



LEGEND

49.0 — AS CONSTRUCTED CONTOURS
(Interval 0.25m)

— RETAINING WALL

REGISTERED SURVEYOR'S CERTIFICATION

I, VERIS AUSTRALIA PTY LTD, hereby certify that the vertical and horizontal locations and dimensions shown on this plan are a true and correct record and were located by survey.

Alistair Byron
Registered Surveyor (sig) Reg. Surveyor No. 6448 Date: 19/11/2021
(Delegate)

AS CONSTRUCTED

0 10 20 30 40 50 60m
SCALE 1:600 @A1

A1

INDEX	DATE	REVISIONS	DRAWN	CHECKED	PASSED
A	03/11/2021	PROGRESS PLOT			
			GJF		

DRAWN	CHECKED	PASSED	INITIALS	DATE
GJF	GJF			03/11/2021
				03/11/2021

veris


BRISBANE (07) 3468 4700 WHITSUNDAYS (07) 4342 9400
MACKAY (07) 4927 9700 CAIRNS (07) 4252 9400
veris.com.au
ACN 615 735 727
Veris Australia Pty Ltd



IPSWICH CITY COUNCIL

BRENTWOOD STAGE 8
AS CONSTRUCTED
SURFACE AS CONSTRUCTED

SCALE 1:600 @A1
SHEET 1 OF 4 SHEETS
DRAWING NO.
400891-AE01A

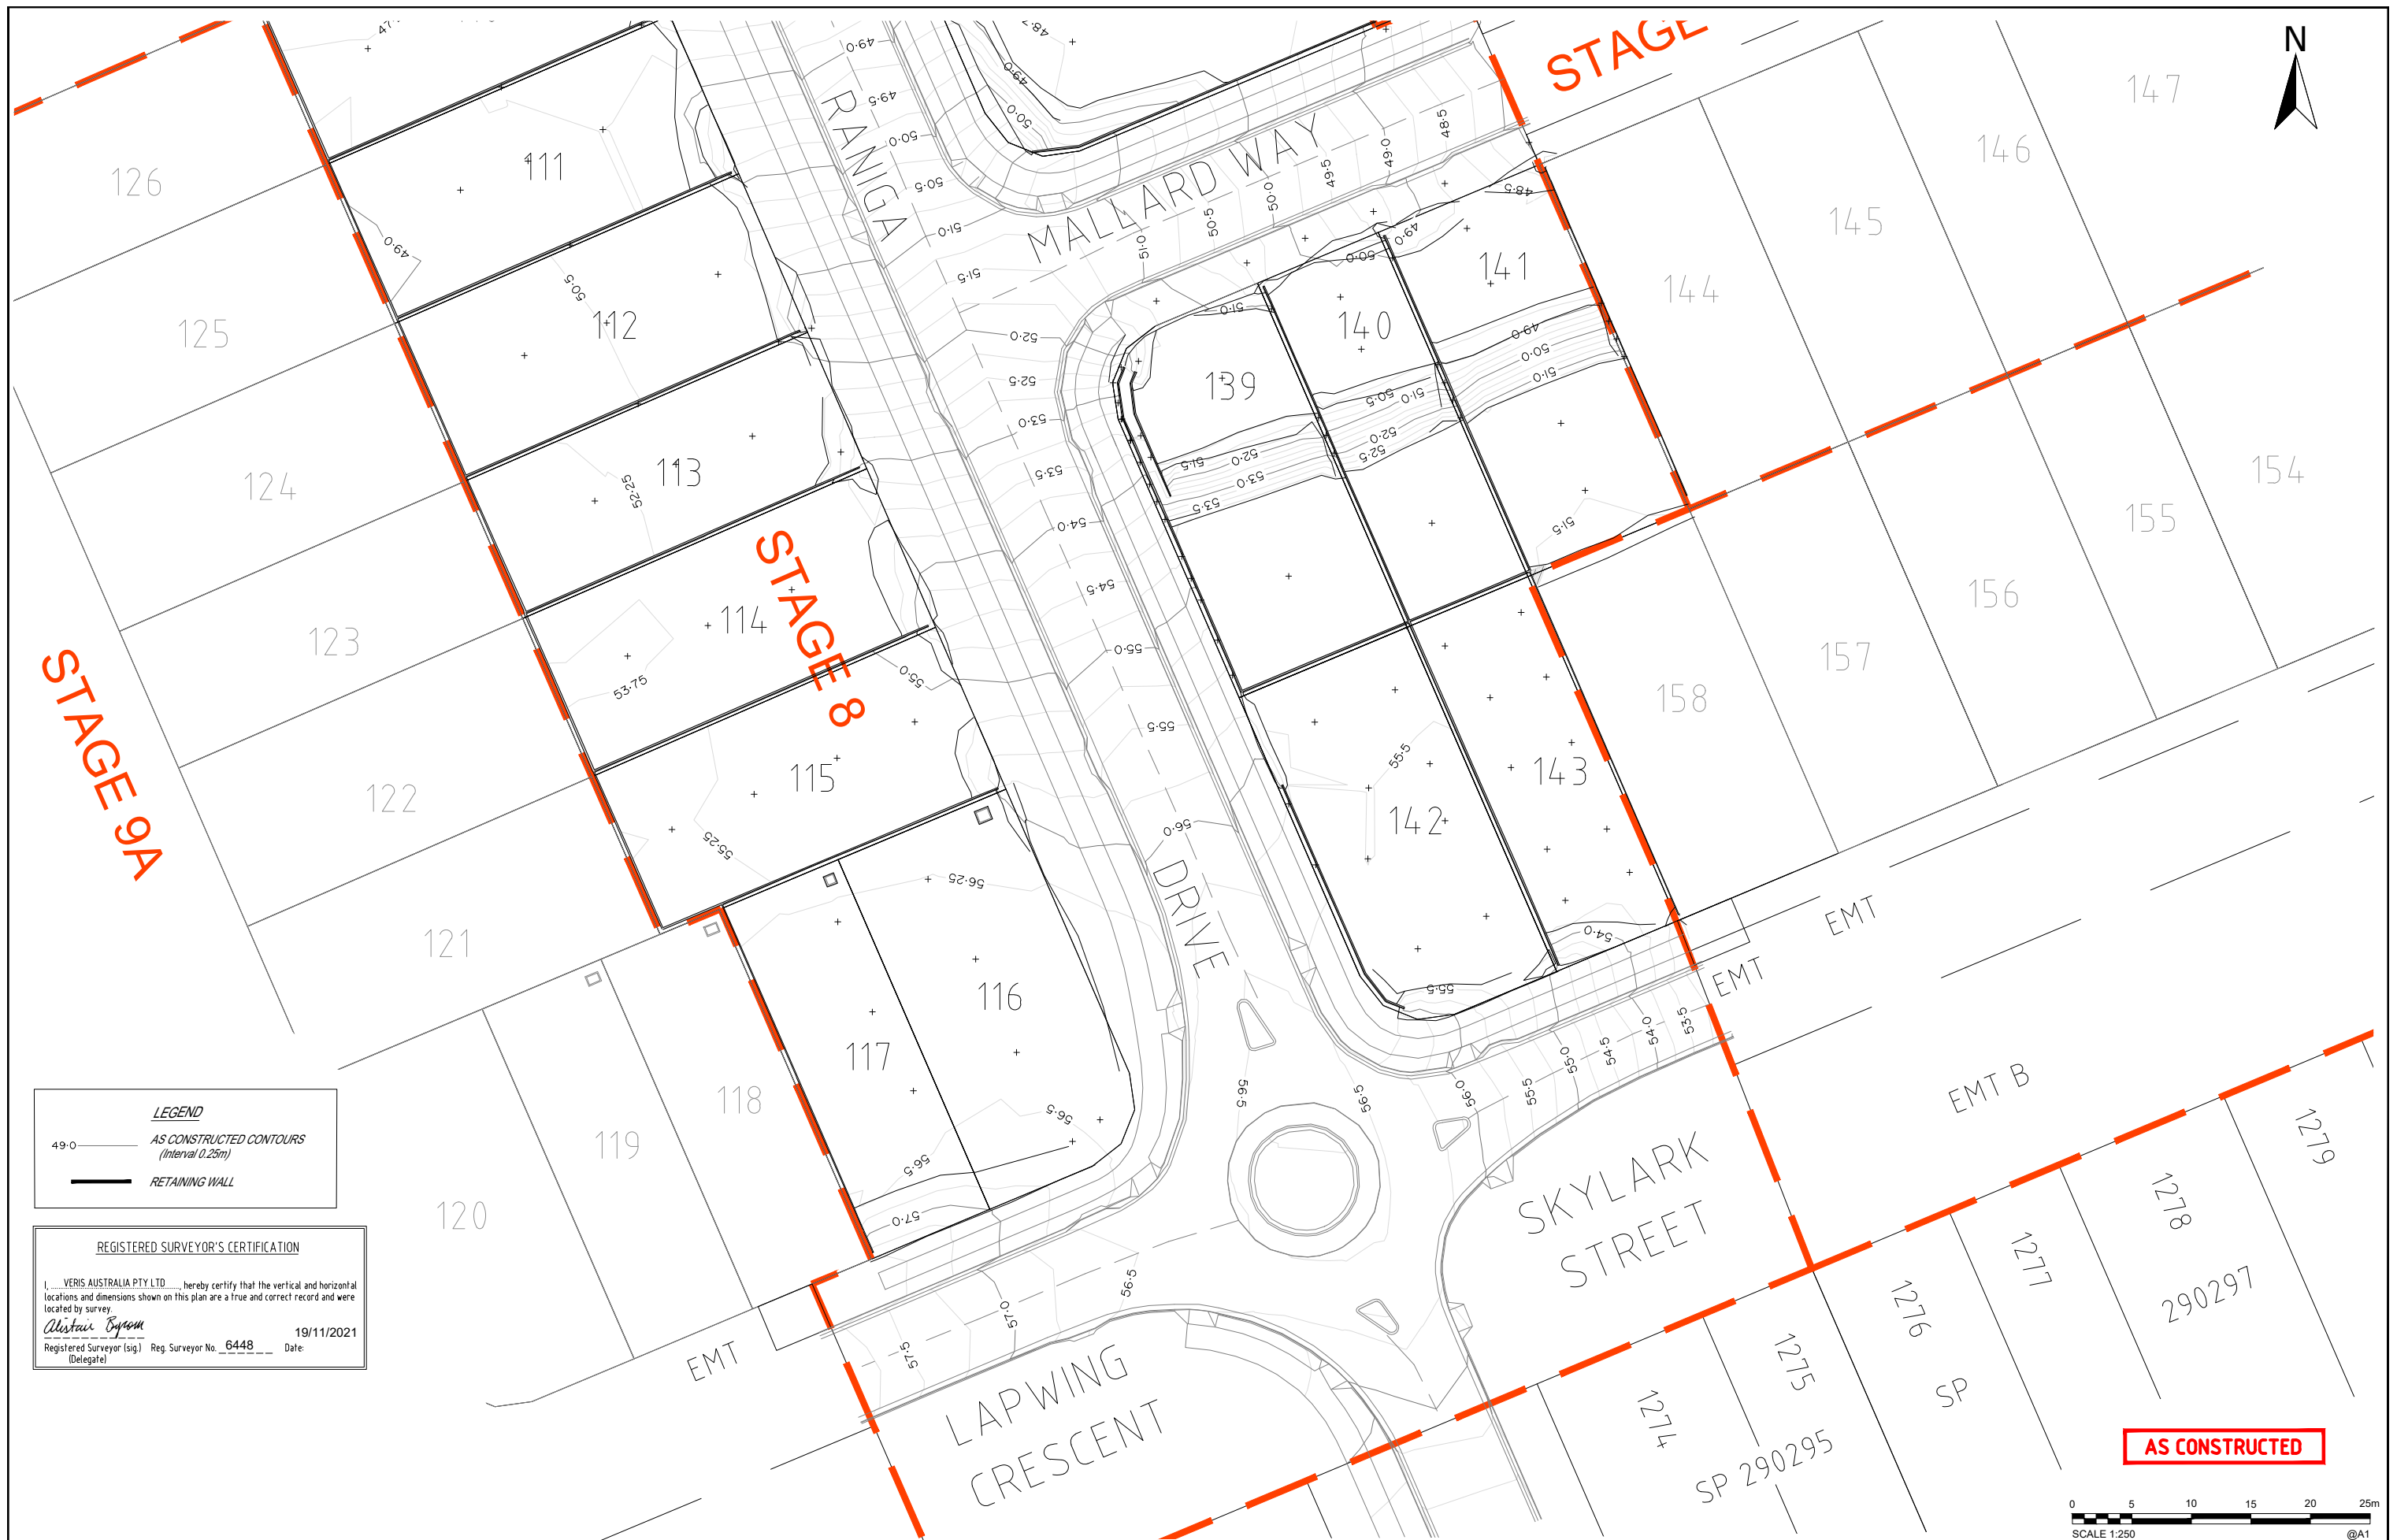

LEGEND

49.0 — AS CONSTRUCTED CONTOURS
(Interval 0.25m)


— RETAINING WALL

REGISTERED SURVEYOR'S CERTIFICATION

I, VERIS AUSTRALIA PTY LTD, hereby certify that the vertical and horizontal locations and dimensions shown on this plan are a true and correct record and were located by survey.

Alister Byrom
Registered Surveyor (sig) Reg. Surveyor No. 6448 Date: 19/11/2021
(Delegate)

AS CONSTRUCTED

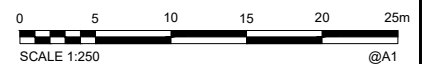

A1	INDEX	DATE	REVISIONS	DRAWN	CHECKED	PASSED
	A	03/11/2021	PROGRESS PLOT	GJF		

DRAWN	GJF	03/11/2021
CHECKED	GJF	03/11/2021
PASSED		
INITIALS		DATE

veris


BRISBANE (07) 3466 4700 WHITSUNDAYS (07) 4442 9400
MACKAY (07) 4927 9700 CAIRNS (07) 4252 9400
veris.com.au
ACN 615 735 727
Veris Australia Pty Ltd



IPSWICH CITY COUNCIL

BRENTWOOD STAGE 8
AS CONSTRUCTED
SURFACE AS CONSTRUCTED

SCALE 1:250 @A1
SHEET 2 OF 4 SHEETS
DRAWING NO.
400891-AE01A

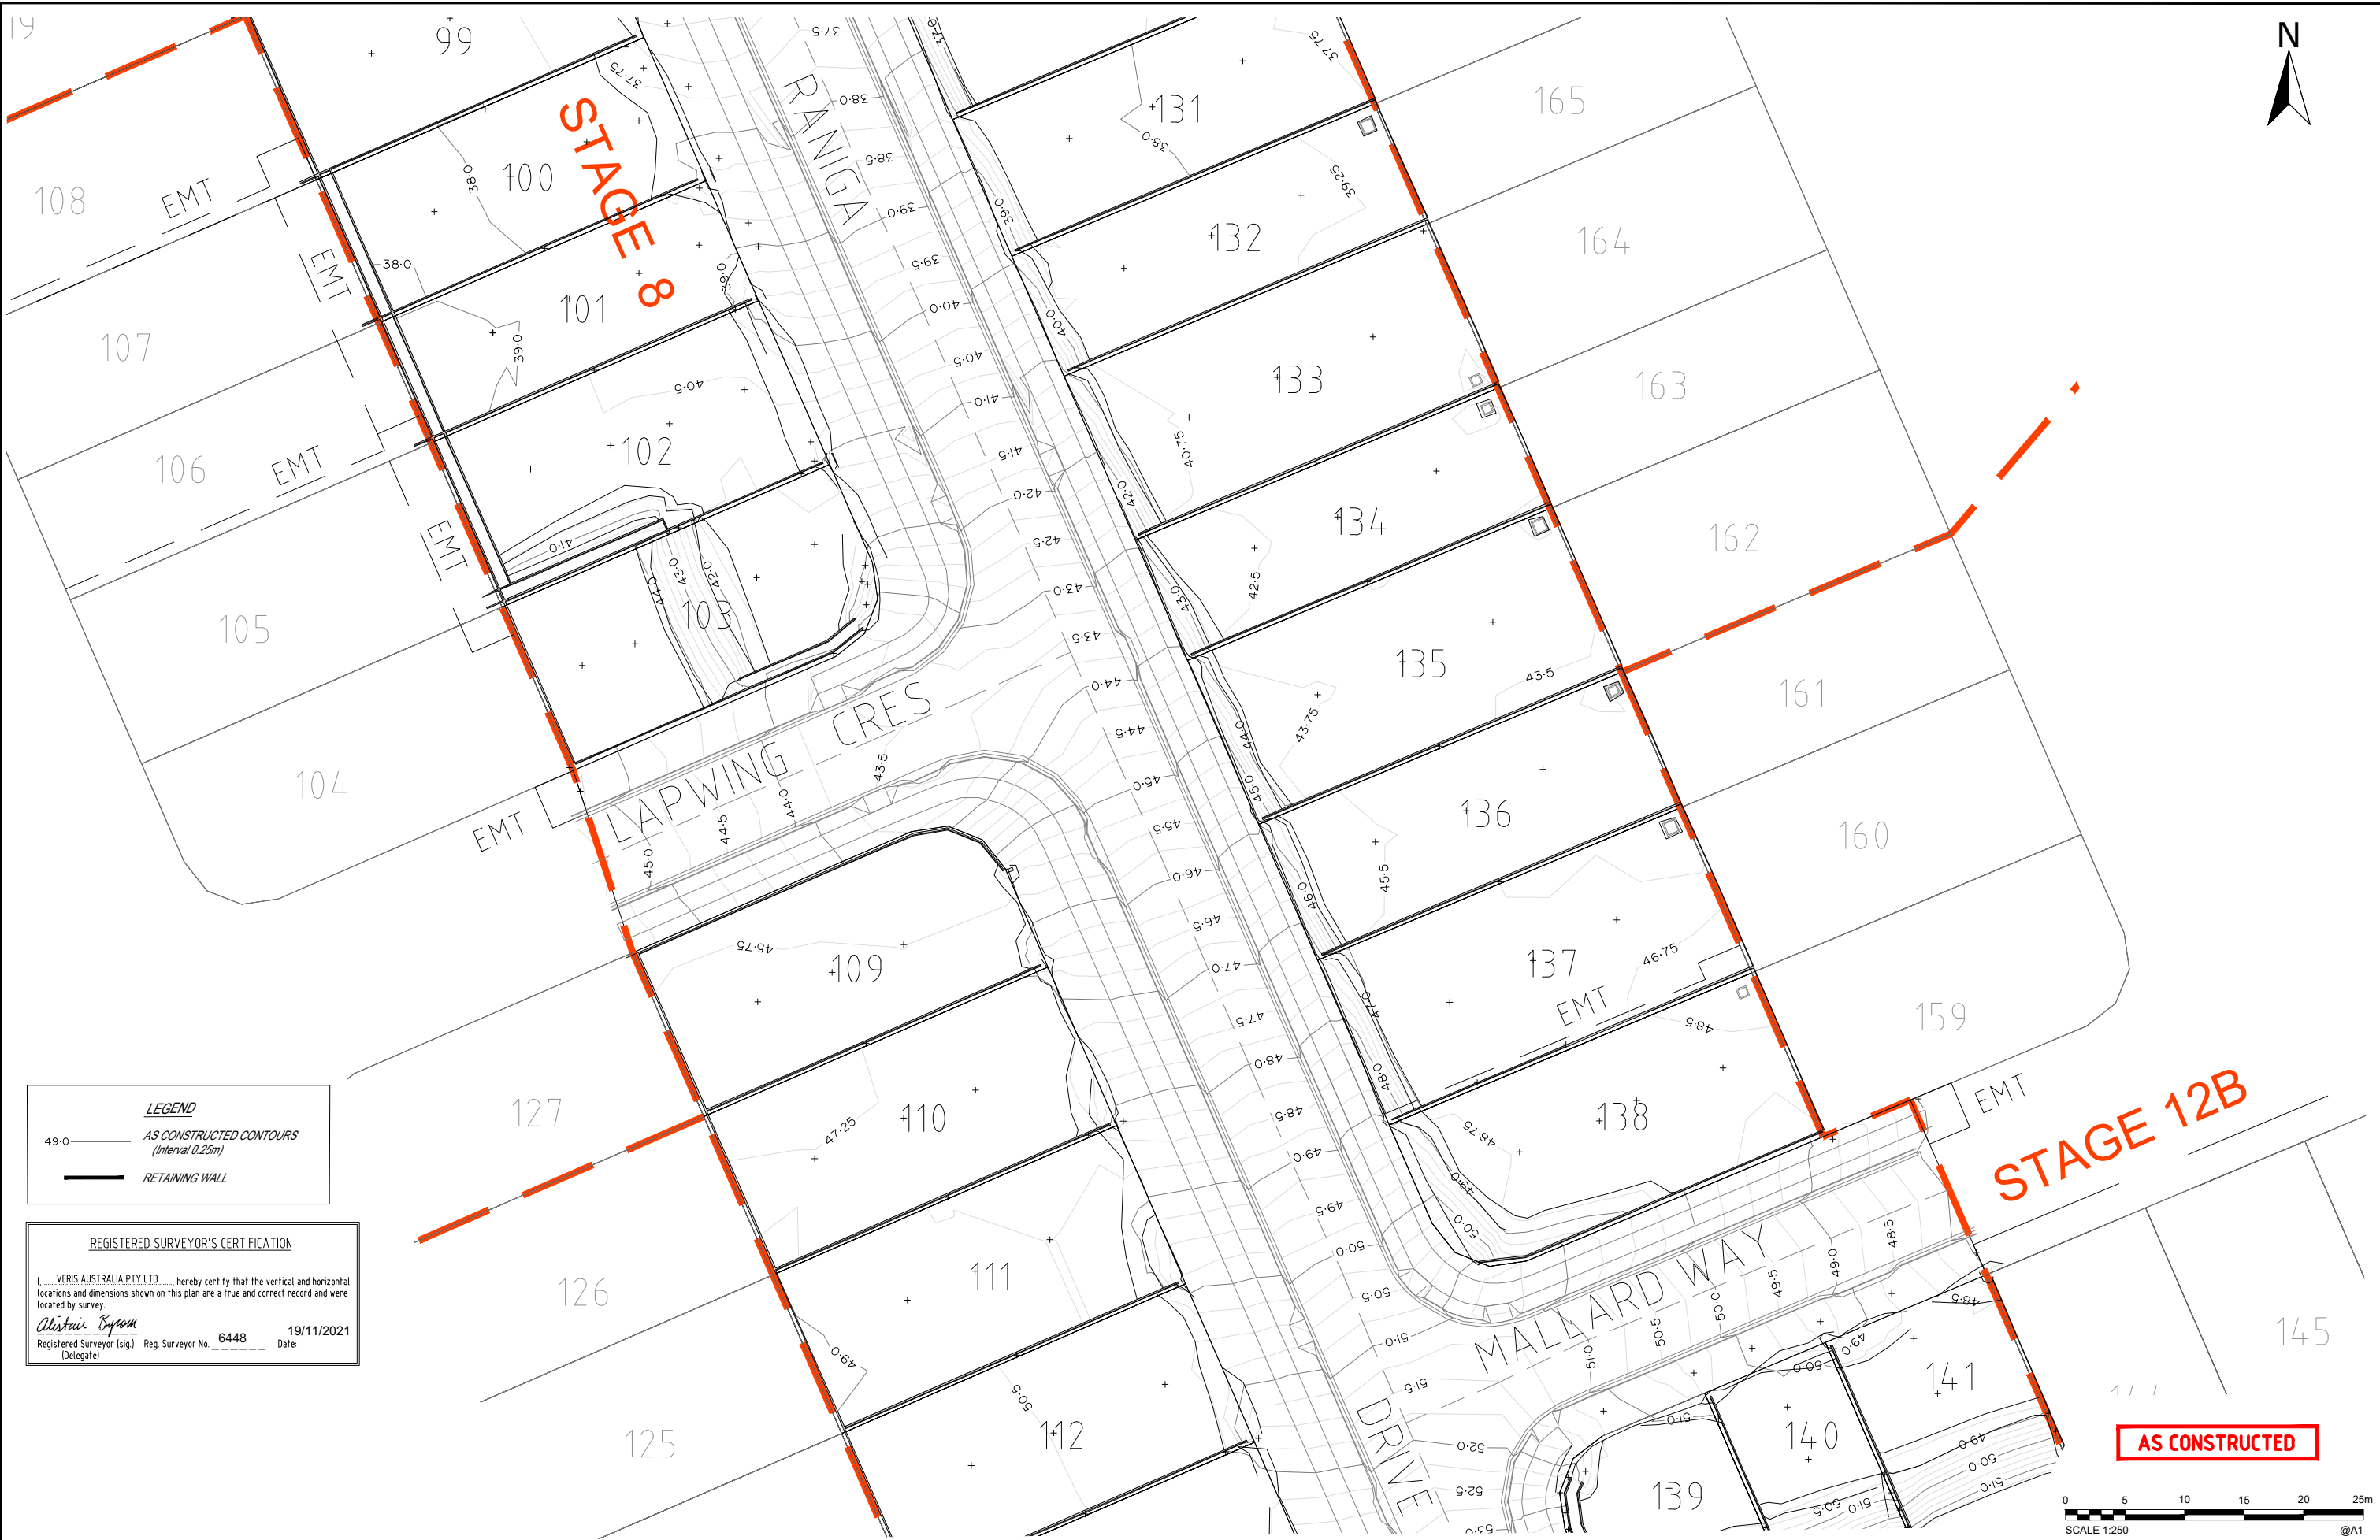

LEGEND

49.0 — AS CONSTRUCTED CONTOURS
(Interval 0.25m)


— RETAINING WALL

REGISTERED SURVEYOR'S CERTIFICATION

I, VERIS AUSTRALIA PTY LTD, hereby certify that the vertical and horizontal locations and dimensions shown on this plan are a true and correct record and were located by survey.

Alexander Byrom
Registered Surveyor (sig) Reg. Surveyor No. 6448 Date: 19/11/2021
(Delegate)

AS CONSTRUCTED

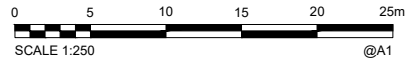

A1									
	A	03/11/2021	PROGRESS PLOT						
INDEX	DATE		REVISIONS	DRAWN	CHECKED	PASSED			

DRAWN	GJ	03/11/2021
CHECKED	GJ	03/11/2021
PASSED		
INITIALS		DATE

veris


BRISBANE (07) 3466 4700 WHITSUNDAYS (07) 4643 9400
MACKAY (07) 4957 9700 CAIRNS (07) 4252 9400
veris.com.au
ACN 615 735 727
Veris Australia Pty Ltd

City of Ipswich

IPSWICH CITY COUNCIL

BRENTWOOD STAGE 8
AS CONSTRUCTED
SURFACE AS CONSTRUCTED


SCALE 1:250 @A1
SHEET 3 OF 4 SHEETS
DRAWING NO.
400891-AE01A

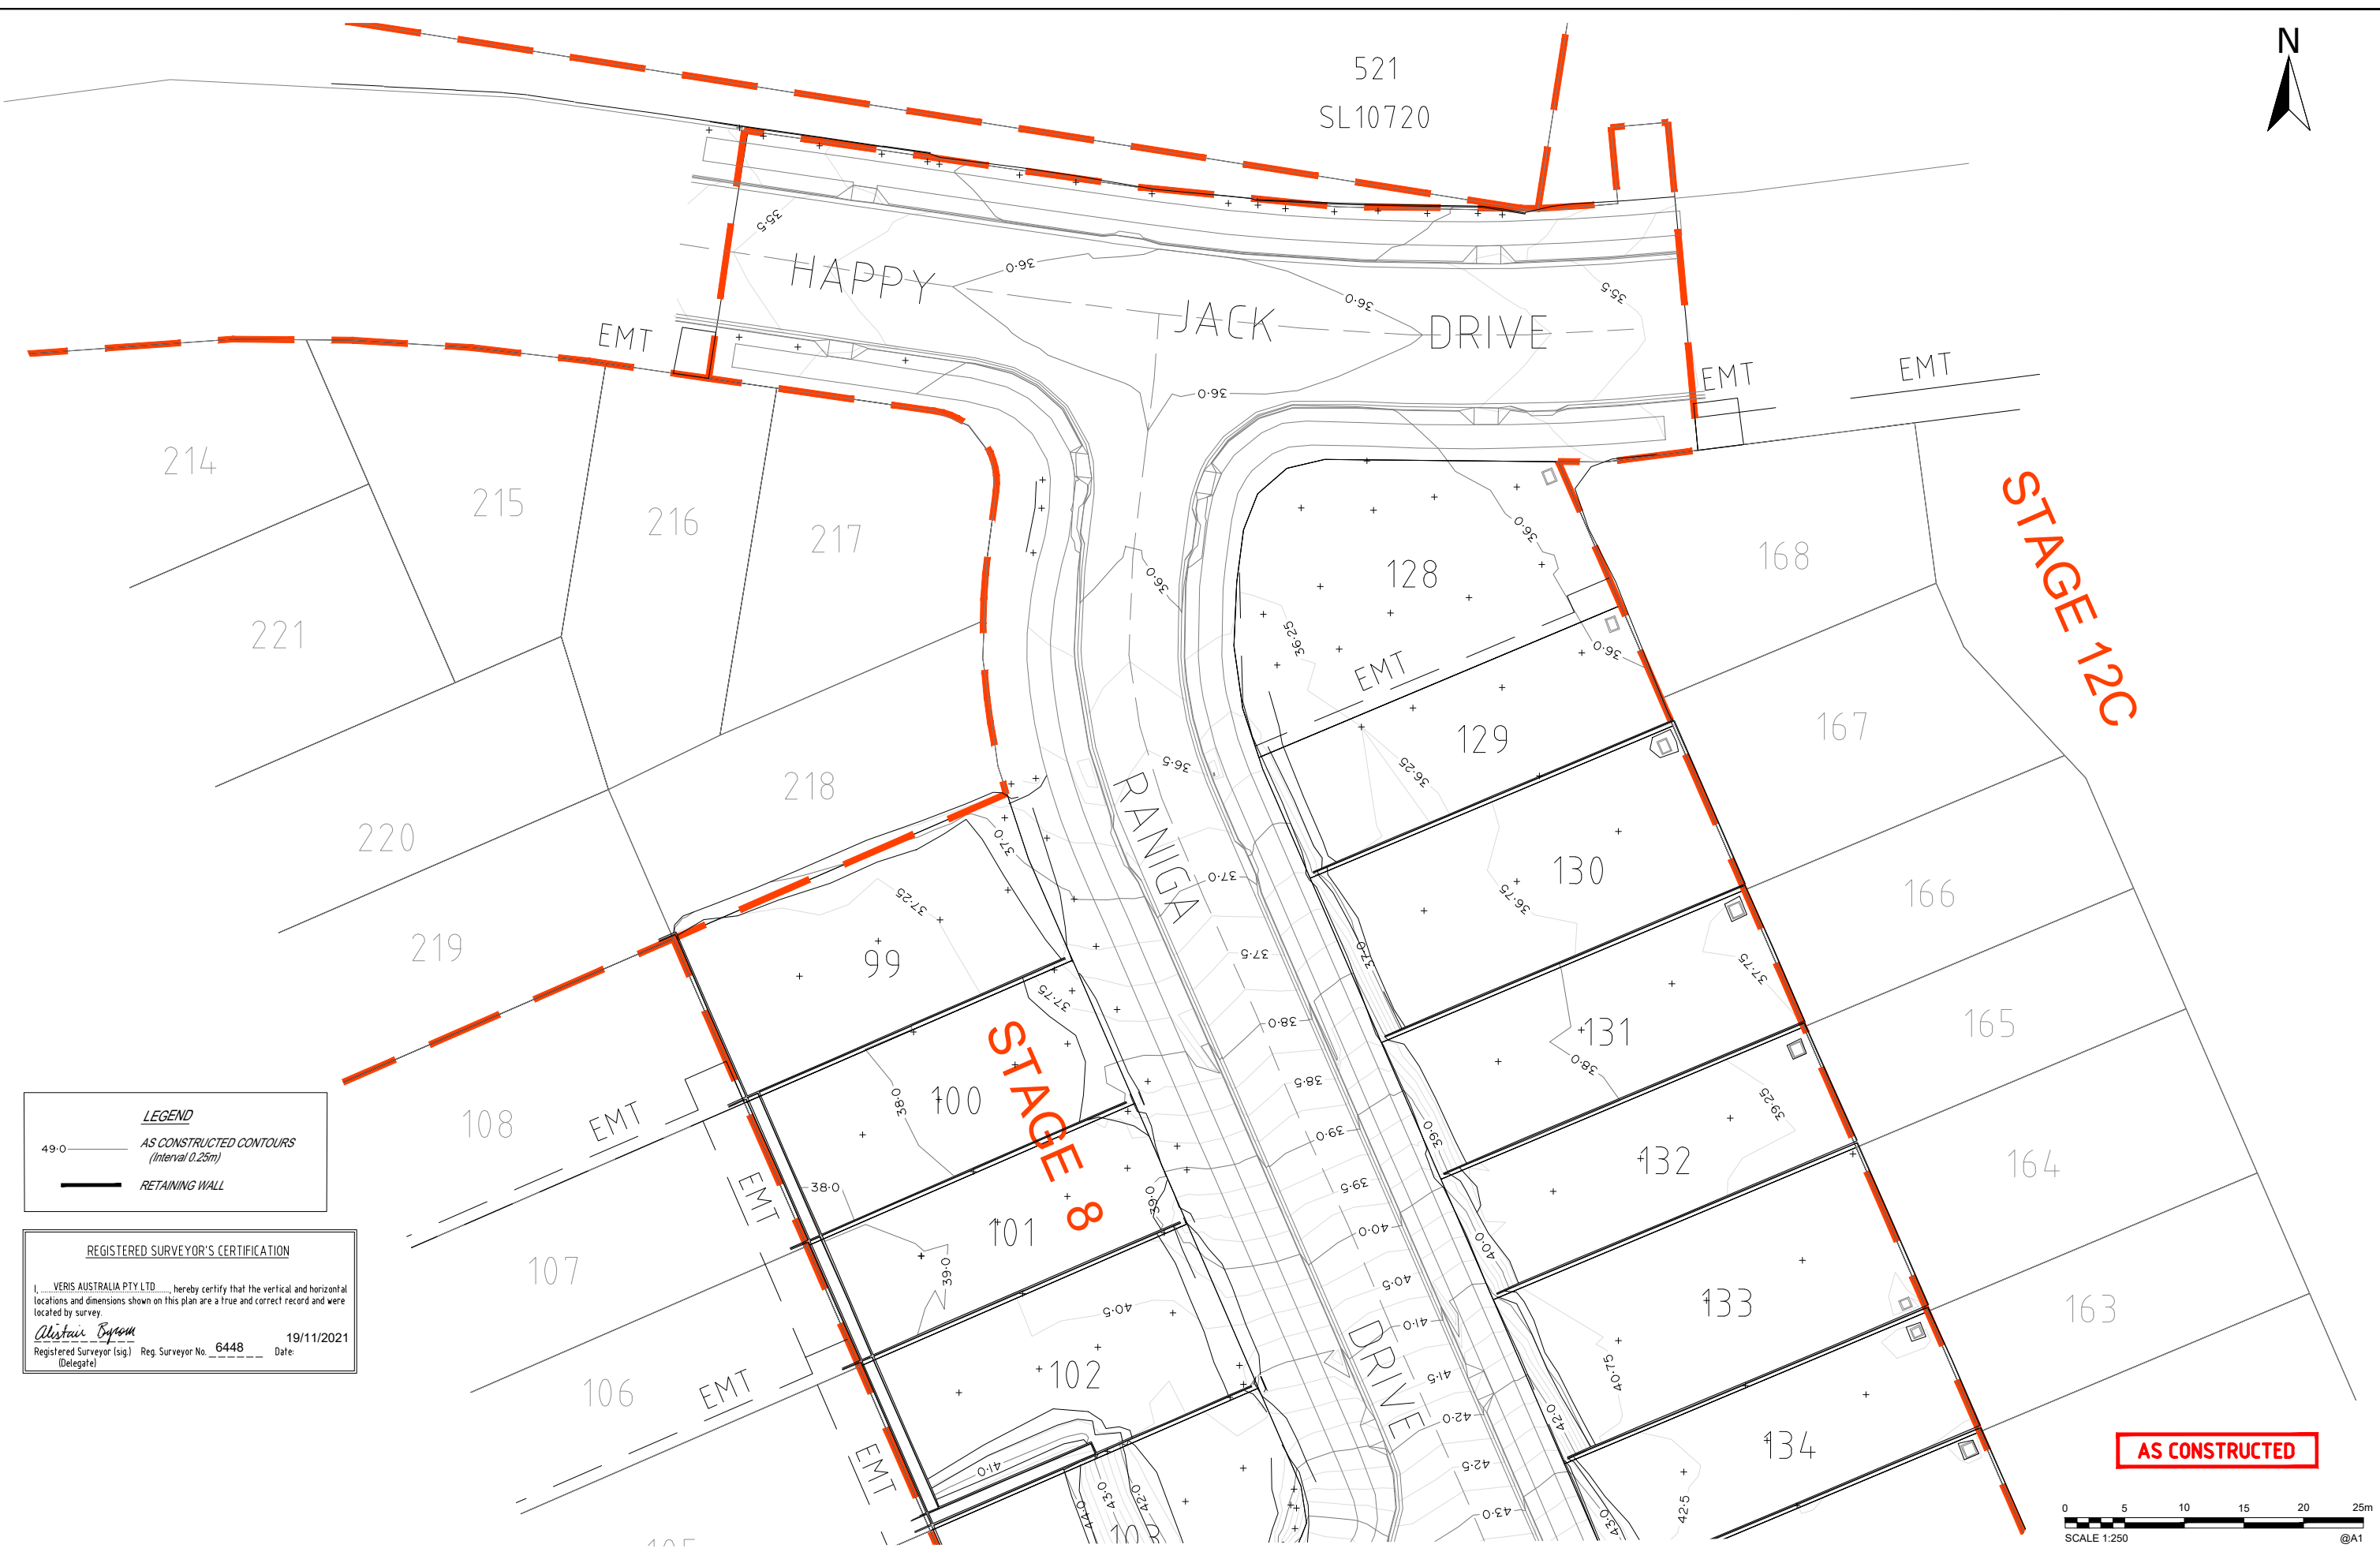

LEGEND
 49.0 — AS CONSTRUCTED CONTOURS
 (Interval 0.25m)
 ——— RETAINING WALL

REGISTERED SURVEYOR'S CERTIFICATION
 I, VERIS AUSTRALIA PTY LTD, hereby certify that the vertical and horizontal locations and dimensions shown on this plan are a true and correct record and were located by survey.
Alexander Byrom
 Registered Surveyor (sig) Reg. Surveyor No. 6448 Date: 19/11/2021
 (Delegate)

AS CONSTRUCTED

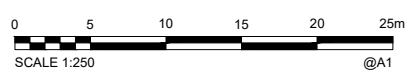

A1	INDEX	DATE	REVISIONS	DRAWN	CHECKED	PASSED
	A	03/11/2021	PROGRESS PLOT	GJF		

DRAWN	GJF	03/11/2021
CHECKED	GJF	03/11/2021
PASSED		
INITIALS		DATE

veris
 BRISBANE (07) 3466 4700 WHITSUNDAYS (07) 4943 9400
 MACKAY (07) 4957 9700 CAIRNS (07) 4332 9400
 veris.com.au
 ACN 615 735 727
 Veris Australia Pty Ltd



IPSWICH CITY COUNCIL

BRENTWOOD STAGE 8
 AS CONSTRUCTED
 SURFACE AS CONSTRUCTED

SCALE 1:250 @A1
 SHEET 4 OF 4 SHEETS
 DRAWING NO.
400891-AE01A