


LEGEND
 49.0 — AS CONSTRUCTED CONTOURS
 (Interval 0.25m)
 — RETAINING WALL

REGISTERED SURVEYOR'S CERTIFICATION
 I, VERIS AUSTRALIA PTY LTD, hereby certify that the vertical and horizontal locations and dimensions shown on this plan are a true and correct record and were located by survey.
 Registered Surveyor (sig) Reg. Surveyor No. 6448 Date: 19/11/2021
 (Delegate)

AS CONSTRUCTED

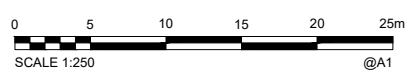

A1									
	A	03/11/2021	PROGRESS PLOT						
	INDEX	DATE	REVISIONS	DRAWN	CHECKED	PASSED	INITIALS	DATE	

DRAWN	GF	03/11/2021
CHECKED	GF	03/11/2021
PASSED		

veris
 BRISBANE (07) 3466 4700 WHITSUNDAYS (07) 4943 9400
 MACKAY (07) 4957 9700 CAIRNS (07) 4252 9400
 veris.com.au
 ACN 615 735 727
 Veris Australia Pty Ltd



IPSWICH CITY COUNCIL
 BRENTWOOD STAGE 8
 AS CONSTRUCTED
 SURFACE AS CONSTRUCTED

SCALE 1:250 @A1
 SHEET 4 OF 4 SHEETS
 DRAWING NO.
400891-AE01A