

**LEGEND**  
 49-0 — AS CONSTRUCTED CONTOURS  
 (Interval 0.25m)  
 — RETAINING WALL

**REGISTERED SURVEYOR'S CERTIFICATION**  
 I, VERIS AUSTRALIA PTY LTD, hereby certify that the vertical and horizontal locations and dimensions shown on this plan are a true and correct record and were located by survey.  
 Alistair Byrom  
 Registered Surveyor (sig) Reg. Surveyor No. 6648 Date: 23/02/2022  
 (Delegate)

**COORDINATE DATUM NOTE:**  
 HORIZONTAL COORDINATES (E,N) SUPPLIED ARE MAPPING GRID OF AUSTRALIA (MGA), ZONE 56 BASED ON THE UNIVERSAL TRANSVERSE MERCATOR PROJECTION AND THE GEOCENTRIC DATUM OF AUSTRALIA 1994.

**AS CONSTRUCTED**  
 SCALE 1:600  
 0 10 20 30 40 50 60m  
 @A1

<b>A1</b>	A	03/02/2022	PROGRESS PLOT	GJF		
	INDEX	DATE	REVISIONS	DRAWN	CHECKED	PASSED

DRAWN	GJF	03/02/2022
CHECKED	GJF	03/02/2022
PASSED		
INITIALS		DATE

**veris**  
 BRISBANE (07) 3466 4700 WHITSUNDAYS (07) 5443 9400  
 MACKAY (07) 4927 9700 CAIRNS (07) 4252 9400  
 veris.com.au  
 ACN 615 735 727  
 Veris Australia Pty Ltd



**IPSWICH CITY COUNCIL**  
 BRENTWOOD STAGE 9  
 AS CONSTRUCTED  
 SURFACE AS CONSTRUCTED

SCALE 1:600 @A1  
 SHEET 1 OF 5 SHEETS  
 DRAWING NO.  
**400891-AE09A**




**LEGEND**  
 49.0 — AS CONSTRUCTED CONTOURS  
 (Interval 0.25m)  
 — RETAINING WALL

**REGISTERED SURVEYOR'S CERTIFICATION**  
 I, VERIS AUSTRALIA PTY LTD, hereby certify that the vertical and horizontal locations and dimensions shown on this plan are a true and correct record and were located by survey.  
*Alister Byrom*  
 Registered Surveyor (sig) Reg. Surveyor No. 6448 Date: 23/02/2022  
 (Delegate)

**COORDINATE DATUM NOTE:**  
 HORIZONTAL COORDINATES (E,N) SUPPLIED ARE MAPPING GRID OF AUSTRALIA (MGA), ZONE 56 BASED ON THE UNIVERSAL TRANSVERSE MERCATOR PROJECTION AND THE GEOCENTRIC DATUM OF AUSTRALIA 1994.

**AS CONSTRUCTED**

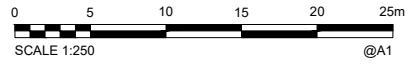

<b>A1</b>	A	03/02/2022	PROGRESS PLOT	GJF		
	INDEX	DATE	REVISIONS	DRAWN	CHECKED	PASSED

DRAWN	GJF	03/02/2022
CHECKED	GJF	03/02/2022
PASSED		
INITIALS		DATE

**veris**  
 BRISBANE (07) 3466 4700 WHITSUNDAYS (07) 4643 9400  
 MACKAY (07) 4957 9700 CAIRNS (07) 4392 9400  
 veris.com.au  
 ACN 615 735 727  
 Veris Australia Pty Ltd




**IPSWICH CITY COUNCIL**

BRENTWOOD STAGE 9  
 AS CONSTRUCTED  
 SURFACE AS CONSTRUCTED

SCALE	1:250 @A1
SHEET	2 OF 5 SHEETS
DRAWING NO.	<b>400891-AE09A</b>



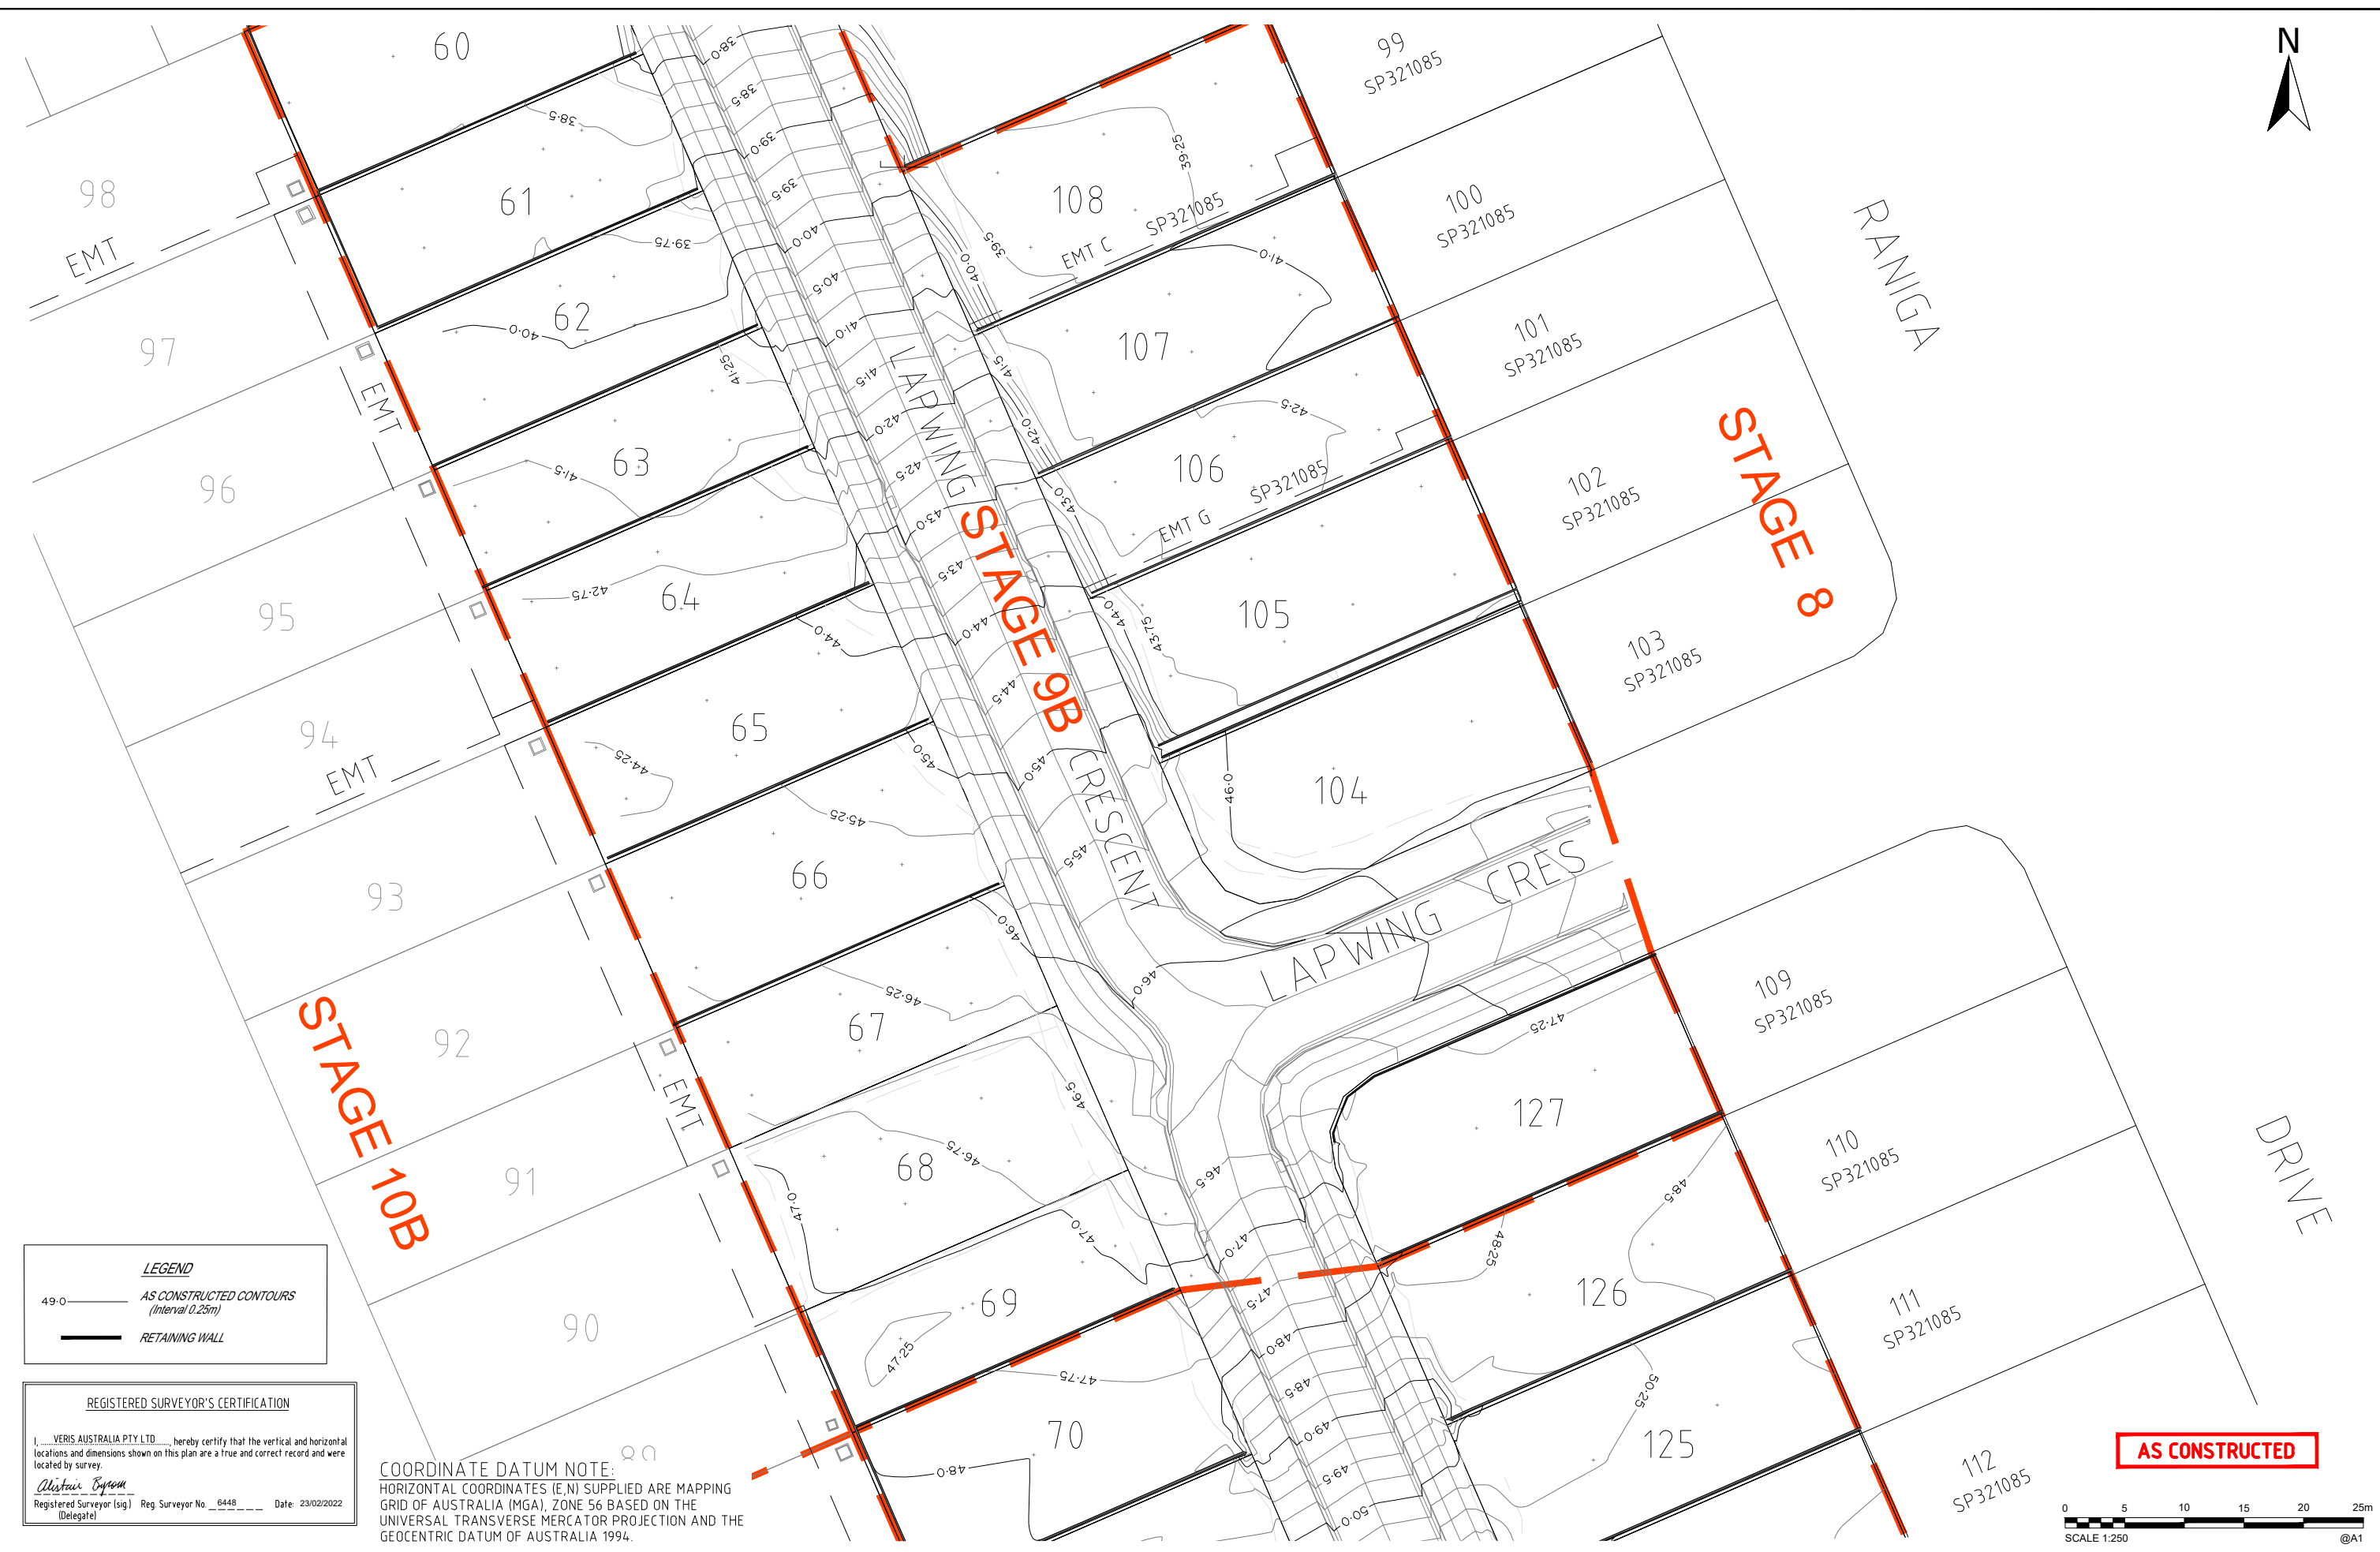

**LEGEND**

49.0 — AS CONSTRUCTED CONTOURS  
(Interval 0.25m)

— RETAINING WALL

**REGISTERED SURVEYOR'S CERTIFICATION**

I, **VERIS AUSTRALIA PTY LTD**, hereby certify that the vertical and horizontal locations and dimensions shown on this plan are a true and correct record and were located by survey.

*Alister Byrom*  
Registered Surveyor (sig) Reg. Surveyor No. 6448 Date: 23/02/2022 (Delegate)

**COORDINATE DATUM NOTE:**  
HORIZONTAL COORDINATES (E,N) SUPPLIED ARE MAPPING GRID OF AUSTRALIA (MGA), ZONE 56 BASED ON THE UNIVERSAL TRANSVERSE MERCATOR PROJECTION AND THE GEOCENTRIC DATUM OF AUSTRALIA 1994.

**AS CONSTRUCTED**

0 5 10 15 20 25m  
SCALE 1:250 @A1

<b>A1</b>						
	A	03/02/2022	PROGRESS PLOT		GJF	
INDEX	DATE		REVISIONS	DRAWN	CHECKED	PASSED

DRAWN	GJF	03/02/2022
CHECKED	GJF	03/02/2022
PASSED		
INITIALS		DATE

**veris**

BRISBANE (07) 3488 4700 WHITSUNDAYS (07) 4643 9400  
MACKAY (07) 4957 9700 CAIRNS (07) 4352 9400  
veris.com.au  
ACN 615 735 727  
Veris Australia Pty Ltd



**IPSWICH CITY COUNCIL**


BRENTWOOD STAGE 9  
AS CONSTRUCTED  
SURFACE AS CONSTRUCTED

SCALE	1:250 @A1
SHEET	3 OF 5 SHEETS
DRAWING NO.	<b>400891-AE09A</b>



521  
SL10720

9001

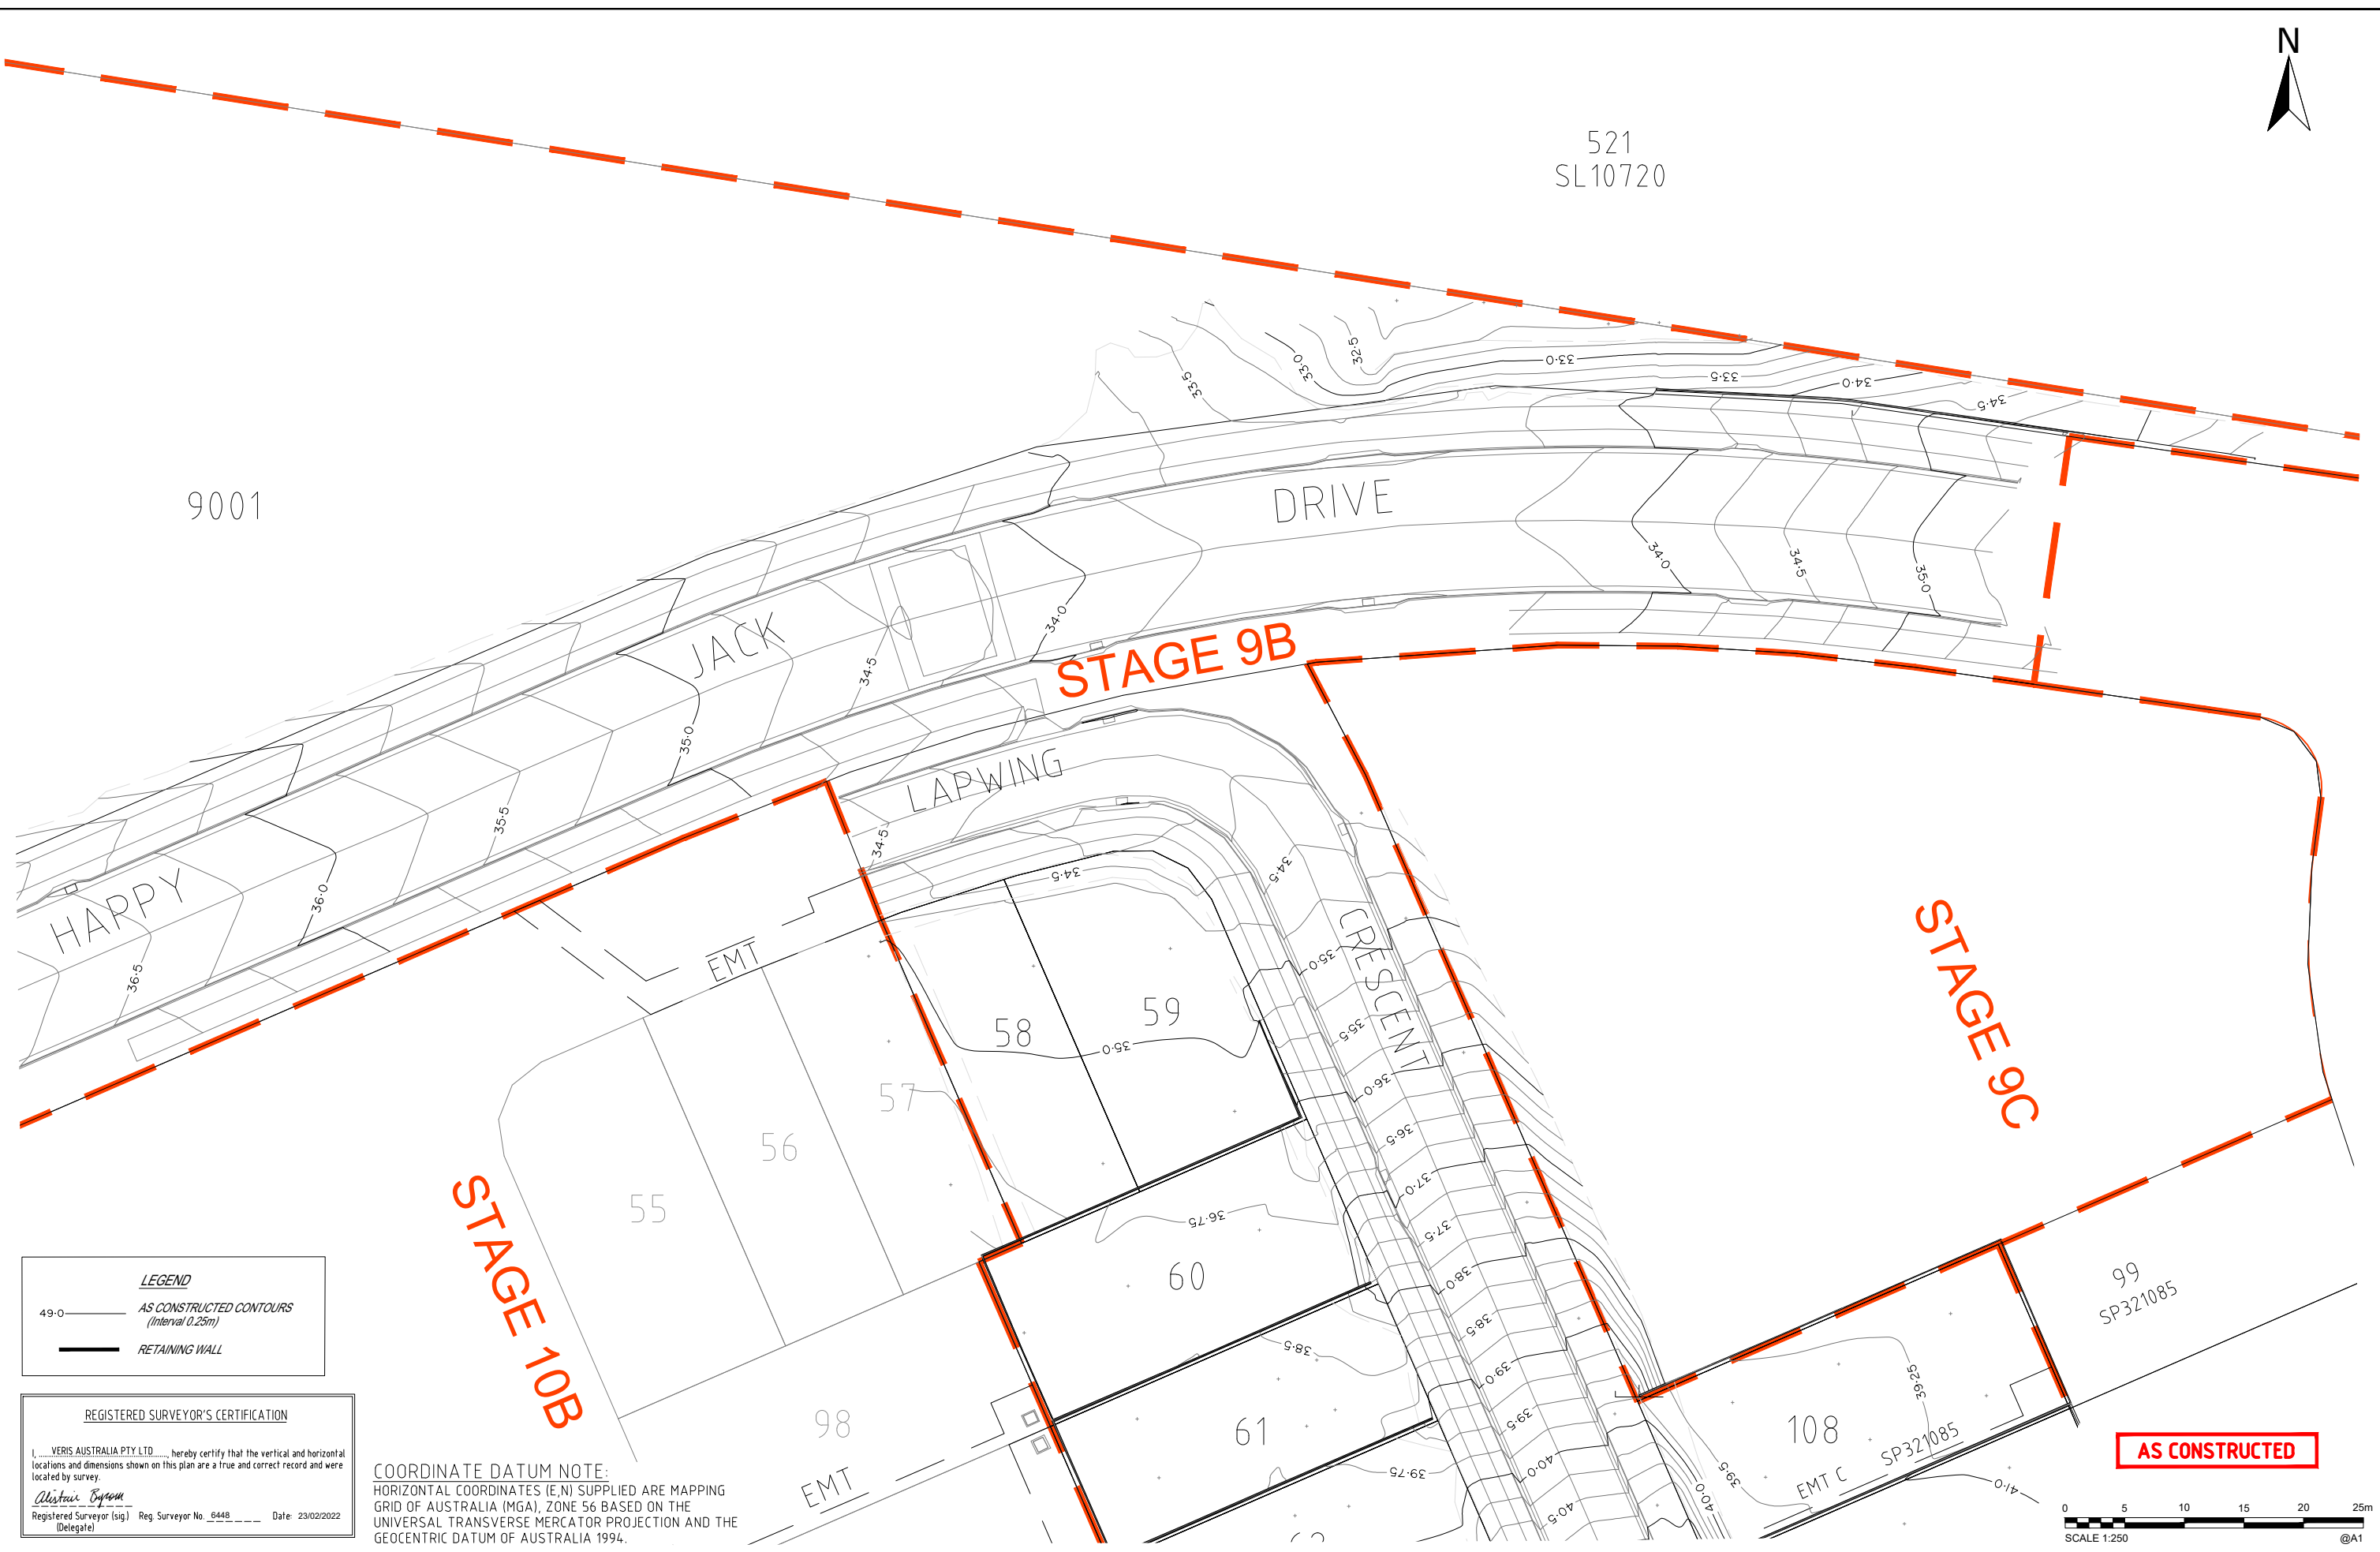

**LEGEND**

49.0 — AS CONSTRUCTED CONTOURS  
(Interval 0.25m)

— RETAINING WALL


**REGISTERED SURVEYOR'S CERTIFICATION**

I, VERIS AUSTRALIA PTY LTD, hereby certify that the vertical and horizontal locations and dimensions shown on this plan are a true and correct record and were located by survey.

*Alicia Byrom*  
Registered Surveyor (sig) Reg. Surveyor No. 6448 Date: 23/02/2022  
(Delegate)

**COORDINATE DATUM NOTE:**  
HORIZONTAL COORDINATES (E,N) SUPPLIED ARE MAPPING GRID OF AUSTRALIA (MGA), ZONE 56 BASED ON THE UNIVERSAL TRANSVERSE MERCATOR PROJECTION AND THE GEOCENTRIC DATUM OF AUSTRALIA 1994.

**AS CONSTRUCTED**

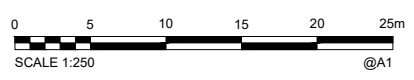

**A1**

INDEX	DATE	REVISIONS	DRAWN	CHECKED	PASSED
A	03/02/2022	PROGRESS PLOT	GJF		

DRAWN	CHECKED	PASSED	INITIALS	DATE
GJF	GJF			03/02/2022
				03/02/2022

**veris**

BRISBANE (07) 3488 4700 WHITSUNDAYS (07) 4943 9400  
MACKAY (07) 4957 9700 CAIRNS (07) 4292 9400  
veris.com.au  
ACN 615 735 727  
Veris Australia Pty Ltd



**IPSWICH CITY COUNCIL**

BRENTWOOD STAGE 9  
AS CONSTRUCTED  
SURFACE AS CONSTRUCTED

SCALE	1:250 @A1
SHEET	4 OF 5 SHEETS
DRAWING NO.	<b>400891-AE09A</b>



**LEGEND**

49.0 — AS CONSTRUCTED CONTOURS  
(Interval 0.25m)

— RETAINING WALL


REGISTERED SURVEYOR'S CERTIFICATION

I, VERIS AUSTRALIA PTY LTD, hereby certify that the vertical and horizontal locations and dimensions shown on this plan are a true and correct record and were located by survey.

*Alistair Byrom*  
Registered Surveyor (sig) Reg. Surveyor No. 6448 Date: 23/02/2022  
(Delegate)

**COORDINATE DATUM NOTE:**  
HORIZONTAL COORDINATES (E,N) SUPPLIED ARE MAPPING GRID OF AUSTRALIA (MGA), ZONE 56 BASED ON THE UNIVERSAL TRANSVERSE MERCATOR PROJECTION AND THE GEOCENTRIC DATUM OF AUSTRALIA 1994.

**AS CONSTRUCTED**

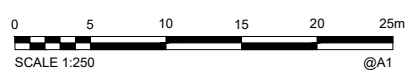

<b>A1</b>	INDEX	DATE	REVISIONS	DRAWN	CHECKED	PASSED
	A	03/02/2022	PROGRESS PLOT	GJF		

DRAWN	GJF	03/02/2022
CHECKED	GJF	03/02/2022
PASSED		
INITIALS		DATE

**veris**

BRISBANE (07) 3486 4700 WHITSUNDAYS (07) 4943 8600  
MACKAY (07) 4957 9700 CAIRNS (07) 4292 9400  
veris.com.au  
ACN 615 735 727  
Veris Australia Pty Ltd



**IPSWICH CITY COUNCIL**

BRENTWOOD STAGE 9  
AS CONSTRUCTED  
SURFACE AS CONSTRUCTED

SCALE	1:250 @A1
SHEET	5 OF 5 SHEETS
DRAWING NO.	<b>400891-AE09A</b>