


REGISTERED SURVEYOR'S CERTIFICATION

I, VERIS AUSTRALIA PTY LTD, hereby certify that the vertical and horizontal locations and dimensions shown on this plan are a true and correct record and were located by survey.


Alistair Byrom
Registered Surveyor (sig) Reg. Surveyor No. 6448 Date: 9/05/2022

LEGEND

49.0 — AS CONSTRUCTED CONTOURS
(Interval 0.25m)
— RETAINING WALL

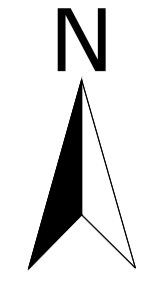

AS CONSTRUCTED

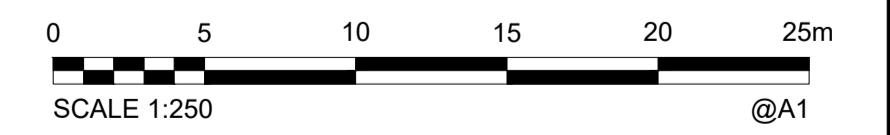

A1	INDEX	DATE	REVISIONS	DRAWN	CHECKED	PASSED
	A	08/04/2022	PROGRESS PLOT	GJF		

DRAWN	GJF	08/04/2022
CHECKED	GJF	08/04/2022
PASSED		
INITIALS		DATE

veris

BRISBANE (07) 3666 4700 WHITSUNDAYS (07) 4945 9500
MACKAY (07) 4967 9100 CAIRNS (07) 4532 9400
veris.com.au
ACN 615 735 727
Veris Australia Pty Ltd



IPSWICH CITY COUNCIL

BRENTWOOD STAGE 9C
AS CONSTRUCTED
SURFACE AS CONSTRUCTED

SCALE	1:250 @A1
SHEET	1 OF 1 SHEETS
DRAWING NO.	400891-AE09C