



SHEET 4

9001



SHEET 3

SHEET 2

COORDINATE DATUM NOTE:
HORIZONTAL COORDINATES (E,N) SUPPLIED ARE MAPPING GRID OF AUSTRALIA (MGA), ZONE 56 BASED ON THE UNIVERSAL TRANSVERSE MERCATOR PROJECTION AND THE GEOCENTRIC DATUM OF AUSTRALIA 1994.

LEGEND

49-0 — AS CONSTRUCTED CONTOURS
(Interval 0.25m)

— RETAINING WALL

REGISTERED SURVEYOR'S CERTIFICATION

I, VERIS AUSTRALIA PTY LTD, hereby certify that the vertical and horizontal locations and dimensions shown on this plan are a true and correct record and were located by survey.

Alexander Byrom
Registered Surveyor (sig) Reg. Surveyor No. 6448 Date: 24/03/2022 (Delegate)

Lot 511
SP276300

AS CONSTRUCTED




A1

INDEX	DATE	REVISIONS	DRAWN	CHECKED	PASSED	INITIALS	DATE
B	23/03/2022	ADD PAD LEVEL TEXT					
A	22/03/2022	PROGRESS PLOT					

BRISBANE (07) 3466 4700 WHITSUNDAYS (07) 4642 9000
MACKAY (07) 4927 9700 CAIRNS (07) 4262 9400

veris

veris.com.au
ACN 615 735 727
Veris Australia Pty Ltd

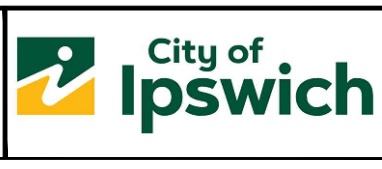

IPSWICH CITY COUNCIL

BRENTWOOD STAGE 10
AS CONSTRUCTED
SURFACE AS CONSTRUCTED

SCALE 1:750 @A1

SHEET 1 OF 4 SHEETS

DRAWING NO.
400891-AE10A




LEGEND
 49.0 — AS CONSTRUCTED CONTOURS
 (Interval 0.25m)
 — RETAINING WALL

REGISTERED SURVEYOR'S CERTIFICATION
 I, VERIS AUSTRALIA PTY LTD, hereby certify that the vertical and horizontal locations and dimensions shown on this plan are a true and correct record and were located by survey.
Alistair Byrom
 Registered Surveyor (sig) Reg. Surveyor No. 6448 Date: 24/03/2022 (Delegate)

COORDINATE DATUM NOTE:
 HORIZONTAL COORDINATES (E,N) SUPPLIED ARE MAPPING GRID OF AUSTRALIA (MGA), ZONE 56 BASED ON THE UNIVERSAL TRANSVERSE MERCATOR PROJECTION AND THE GEOCENTRIC DATUM OF AUSTRALIA 1994.

AS CONSTRUCTED

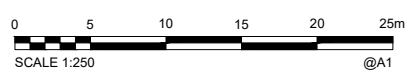

A1	B	23/03/2022	ADD PAD LEVEL TEXT	GJF		
	A	22/03/2022	PROGRESS PLOT	GJF		
	INDEX	DATE	REVISIONS	DRAWN	CHECKED	PASSED

DRAWN	GJF	22/03/2022
CHECKED	GJF	22/03/2022
PASSED		
INITIALS		DATE

veris
 BRISBANE (07) 3488 4700 WHITSUNDAYS (07) 4943 9400
 MACKAY (07) 4957 9700 CAIRNS (07) 4292 9400
 veris.com.au
 ACN 615 735 727
 Veris Australia Pty Ltd



IPSWICH CITY COUNCIL
 BRENTWOOD STAGE 10
 AS CONSTRUCTED
 SURFACE AS CONSTRUCTED

SCALE	1:250 @A1
SHEET	2 OF 4 SHEETS
DRAWING NO.	400891-AE10A
	B
	A



COORDINATE DATUM NOTE:
 HORIZONTAL COORDINATES (E.N) SUPPLIED ARE MAPPING GRID OF AUSTRALIA (MGA), ZONE 56 BASED ON THE UNIVERSAL TRANSVERSE MERCATOR PROJECTION AND THE GEOCENTRIC DATUM OF AUSTRALIA 1994.

LEGEND

49.0 — AS CONSTRUCTED CONTOURS (Interval 0.25m)


— RETAINING WALL

REGISTERED SURVEYOR'S CERTIFICATION

I, **VERIS AUSTRALIA PTY LTD**, hereby certify that the vertical and horizontal locations and dimensions shown on this plan are a true and correct record and were located by survey.

Alistair Byrom
 Registered Surveyor (sig) Reg. Surveyor No. **6448** Date: 24/03/2022 (Delegate)

AS CONSTRUCTED

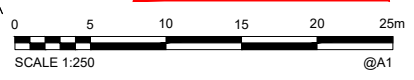

A1	B	23/03/2022	ADD PAD LEVEL TEXT						
	A	22/03/2022	PROGRESS PLOT						
	INDEX	DATE	REVISIONS	DRAWN	CHECKED	PASSED			

DRAWN	GJF	22/03/2022
CHECKED	GJF	22/03/2022
PASSED		
INITIALS		DATE

veris

BRISBANE (07) 3466 4700 WHITSUNDAYS (07) 5463 9400
 MACKAY (07) 4957 9700 CAIRNS (07) 4262 9400
 veris.com.au
 ACN 615 735 727
 Veris Australia Pty Ltd



IPSWICH CITY COUNCIL

BRENTWOOD STAGE 10
 AS CONSTRUCTED
 SURFACE AS CONSTRUCTED

SCALE	1:250 @A1
SHEET	3 OF 4 SHEETS
DRAWING NO.	400891-AE10A
	A



9001

DRIVE

JACK

CRESCENT

HAPPY

LAPWING

LAPWING

PRION CRES

LAPWING

CRESCENT

CRESCENT



COORDINATE DATUM NOTE:
HORIZONTAL COORDINATES (E,N) SUPPLIED ARE MAPPING GRID OF AUSTRALIA (MGA), ZONE 56 BASED ON THE UNIVERSAL TRANSVERSE MERCATOR PROJECTION AND THE GEOCENTRIC DATUM OF AUSTRALIA 1994.


LEGEND	
49.0	AS CONSTRUCTED CONTOURS (Interval 0.25m)
—	RETAINING WALL

REGISTERED SURVEYOR'S CERTIFICATION

I, VERIS AUSTRALIA PTY LTD, hereby certify that the vertical and horizontal locations and dimensions shown on this plan are a true and correct record and were located by survey.

Alistair Byrom
Registered Surveyor (sig) Reg. Surveyor No. 6448 Date: 24/03/2022
(Delegate)

AS CONSTRUCTED

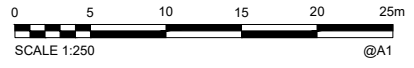

A1

INDEX	DATE	REVISIONS	DRAWN	CHECKED	PASSED
B	23/03/2022	ADD PAD LEVEL TEXT			
A	22/03/2022	PROGRESS PLOT			

DRAWN	INITIALS	DATE
GJF		22/03/2022
GJF		22/03/2022
PASSED		

veris

BRISBANE (07) 3466 4700 WHITSUNDAYS (07) 4943 9400
MACKAY (07) 4957 9700 CAIRNS (07) 4352 9400
veris.com.au
ACN 615 735 727
Veris Australia Pty Ltd



IPSWICH CITY COUNCIL

BRENTWOOD STAGE 10
AS CONSTRUCTED
SURFACE AS CONSTRUCTED

SCALE	SHEET 4 OF 4 SHEETS
1:250 @A1	
DRAWING NO.	
400891-AE10A	