



9008

LEGEND


49.0	AS CONSTRUCTED CONTOURS (Interval 0.25m)
—	RETAINING WALL

REGISTERED SURVEYOR'S CERTIFICATION

I, **VERIS AUSTRALIA PTY LTD**, hereby certify that the vertical and horizontal locations and dimensions shown on this plan are a true and correct record and were located by survey.

Alistair Byron
 Registered Surveyor (sig) Reg. Surveyor No. 6448 Date: 2/09/2022
 (Delegate)

AS CONSTRUCTED

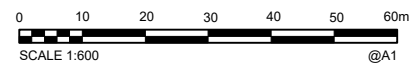

A1

INDEX	DATE	REVISIONS	DRAWN	CHECKED	PASSED
A	31/08/2022	ORIGINAL	Jk		

DRAWN	Jk	31/08/2022
CHECKED	Jk	31/08/2022
PASSED		
INITIALS	DATE	

veris

BRISBANE (07) 3866 4700 WHITSUNDAYS (07) 4342 9600
 MACKAY (07) 4927 9700 CAIRNS (07) 4322 9400
 veris.com.au
 ACN 615 735 727
 Veris Australia Pty Ltd




IPSWICH CITY COUNCIL

BRENTWOOD STAGE 12
AS CONSTRUCTED
FINAL SURFACE

SCALE	1:600 @A1
SHEET	1 OF 4 SHEETS
DRAWING NO.	400891-AE12

AS CONSTRUCTED

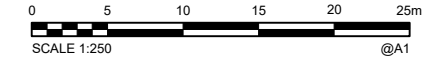

LEGEND


49.0	AS CONSTRUCTED CONTOURS (Interval 0.25m)
—	RETAINING WALL



REGISTERED SURVEYOR'S CERTIFICATION

I, VERIS AUSTRALIA PTY LTD, hereby certify that the vertical and horizontal locations and dimensions shown on this plan are a true and correct record and were located by survey.

Alistair Byrom
Registered Surveyor (sig) Reg. Surveyor No. 6448 Date: 2/09/2022
(Delegate)

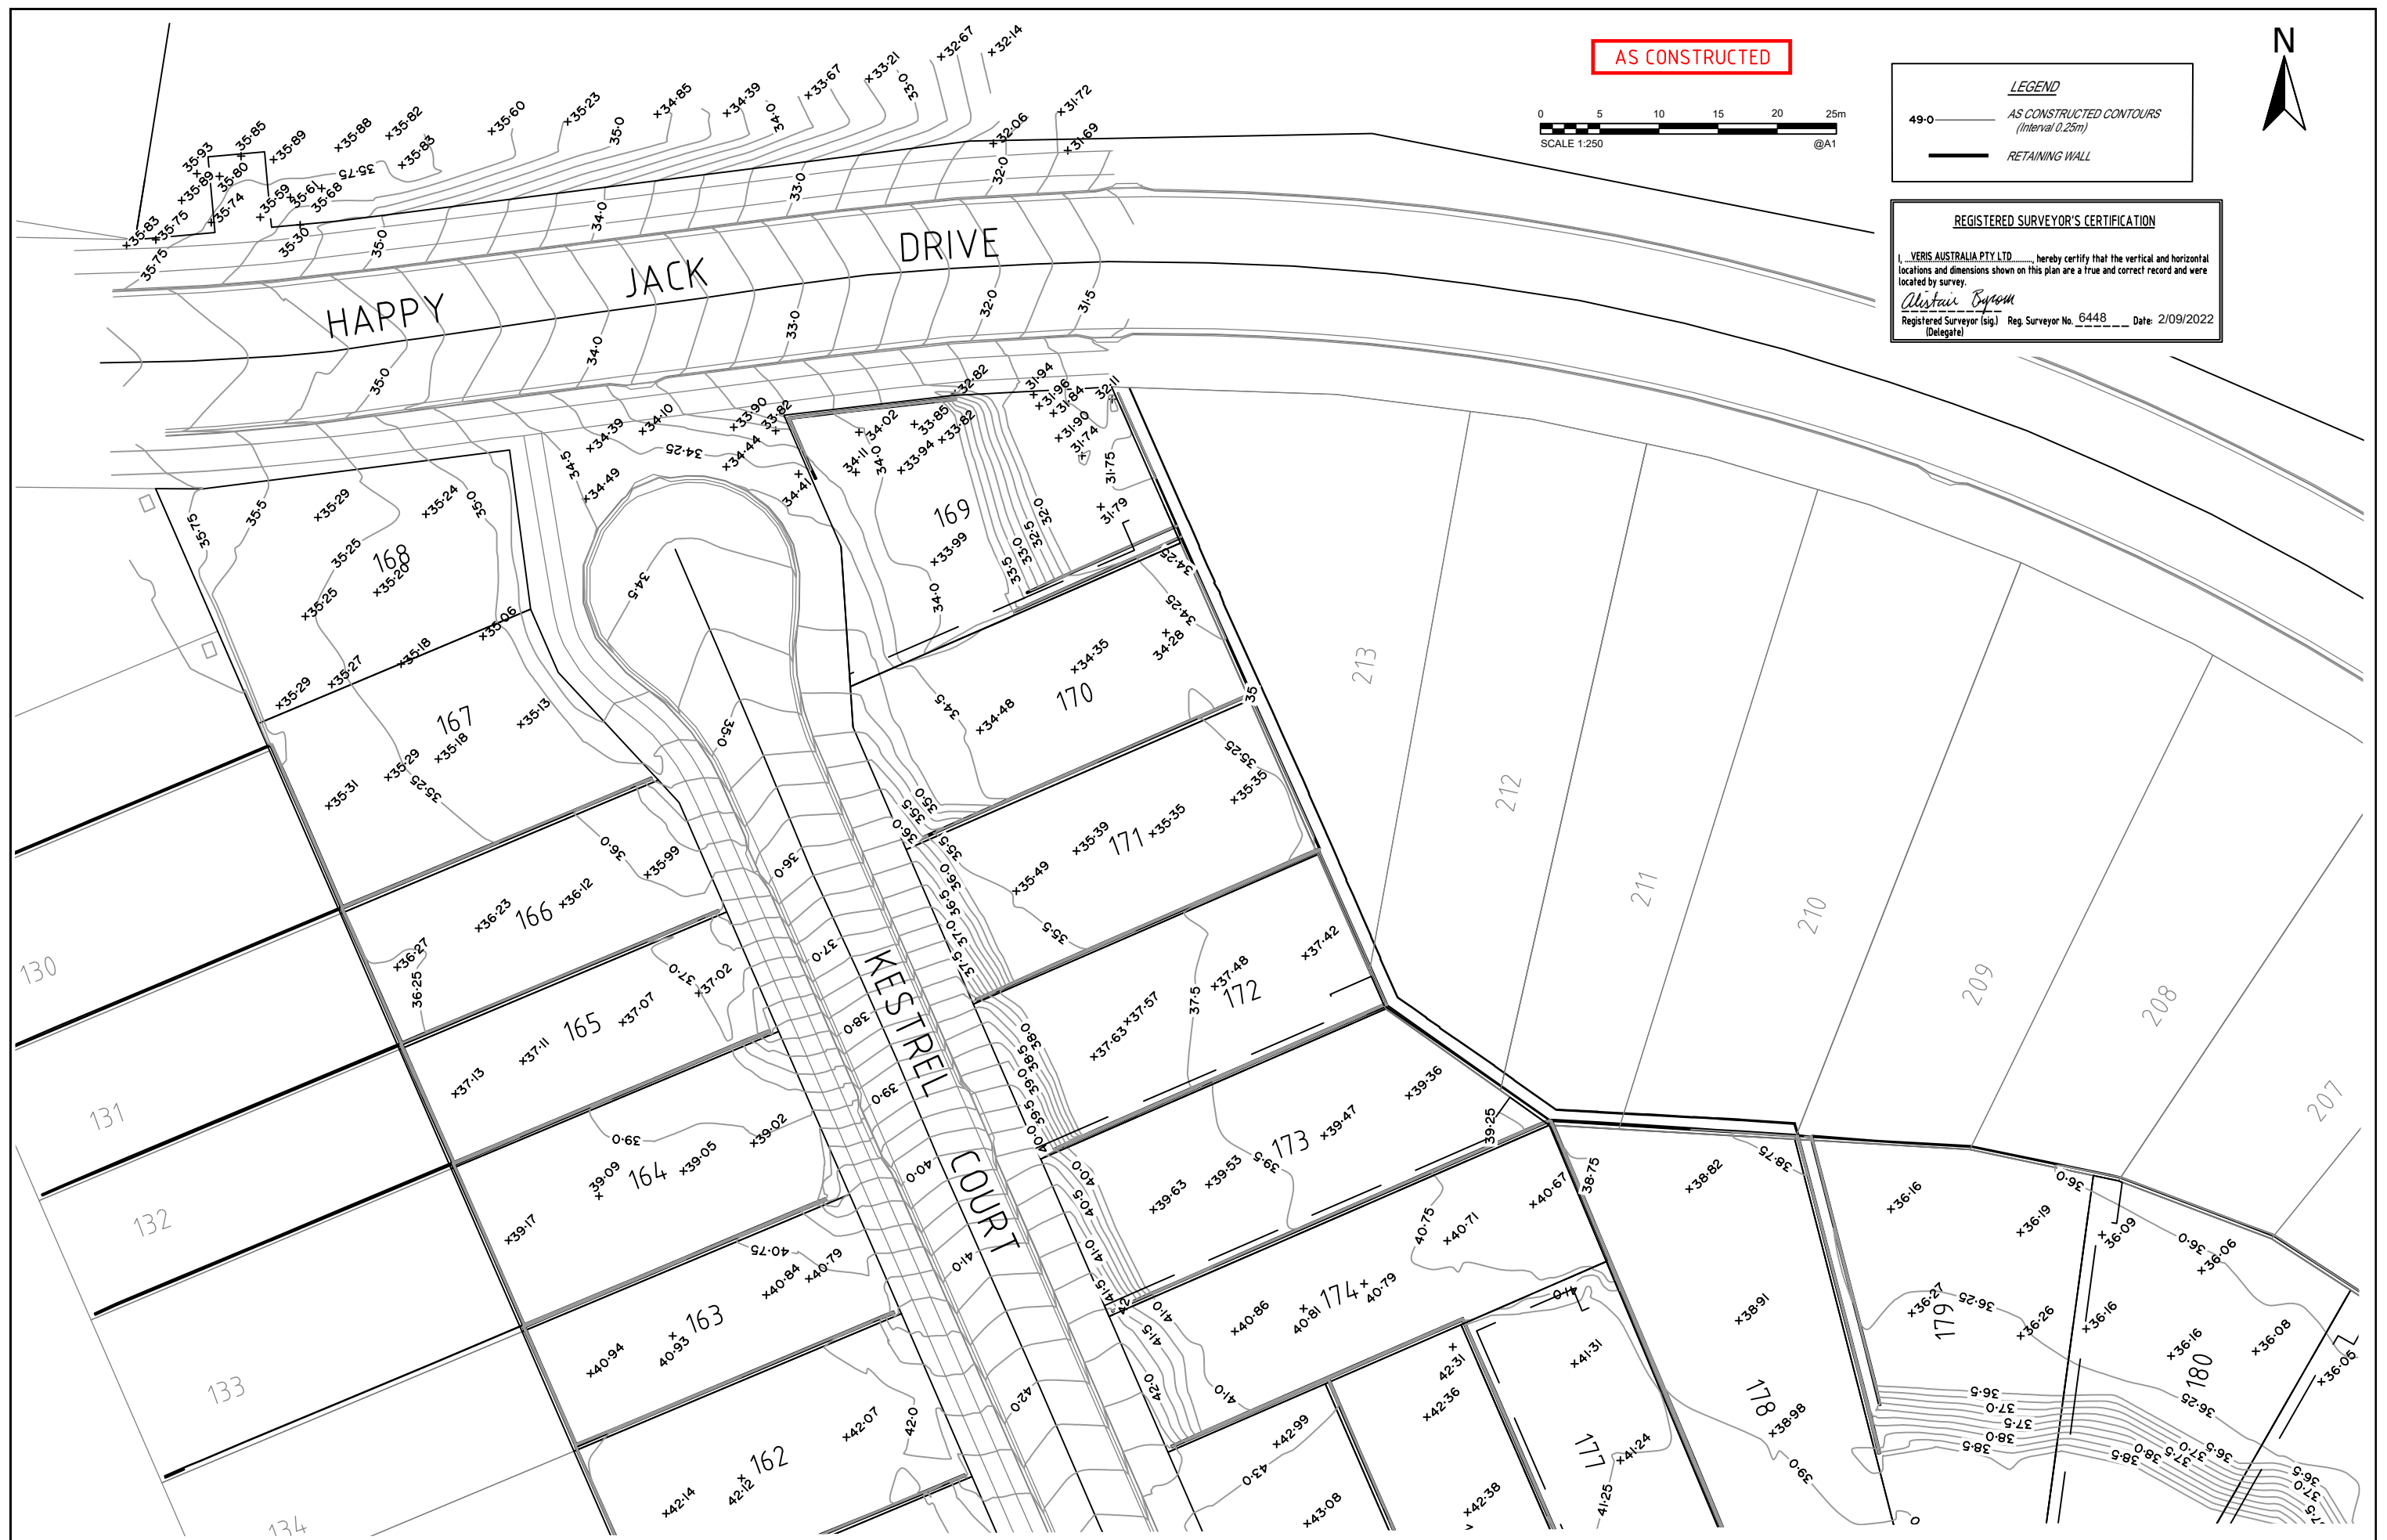

A1								
	INDEX	DATE	REVISIONS	DRAWN	CHECKED	PASSED	INITIALS	DATE
A	31/08/2022	ORIGINAL						

DRAWN	Jk	31/08/2022
CHECKED	Jk	31/08/2022
PASSED		

veris


BRISBANE (07) 3866 4700 WHITSUNDAYS (07) 4642 8600
MACKAY (07) 4927 9700 CAIRNS (07) 4232 9400
veris.com.au
ACN 615 735 727
Veris Australia Pty Ltd



IPSWICH CITY COUNCIL

BRENTWOOD STAGE 12
AS CONSTRUCTED
FINAL SURFACE


SCALE	1:250 @A1
SHEET	2 OF 4 SHEETS
DRAWING NO.	400891-AE12

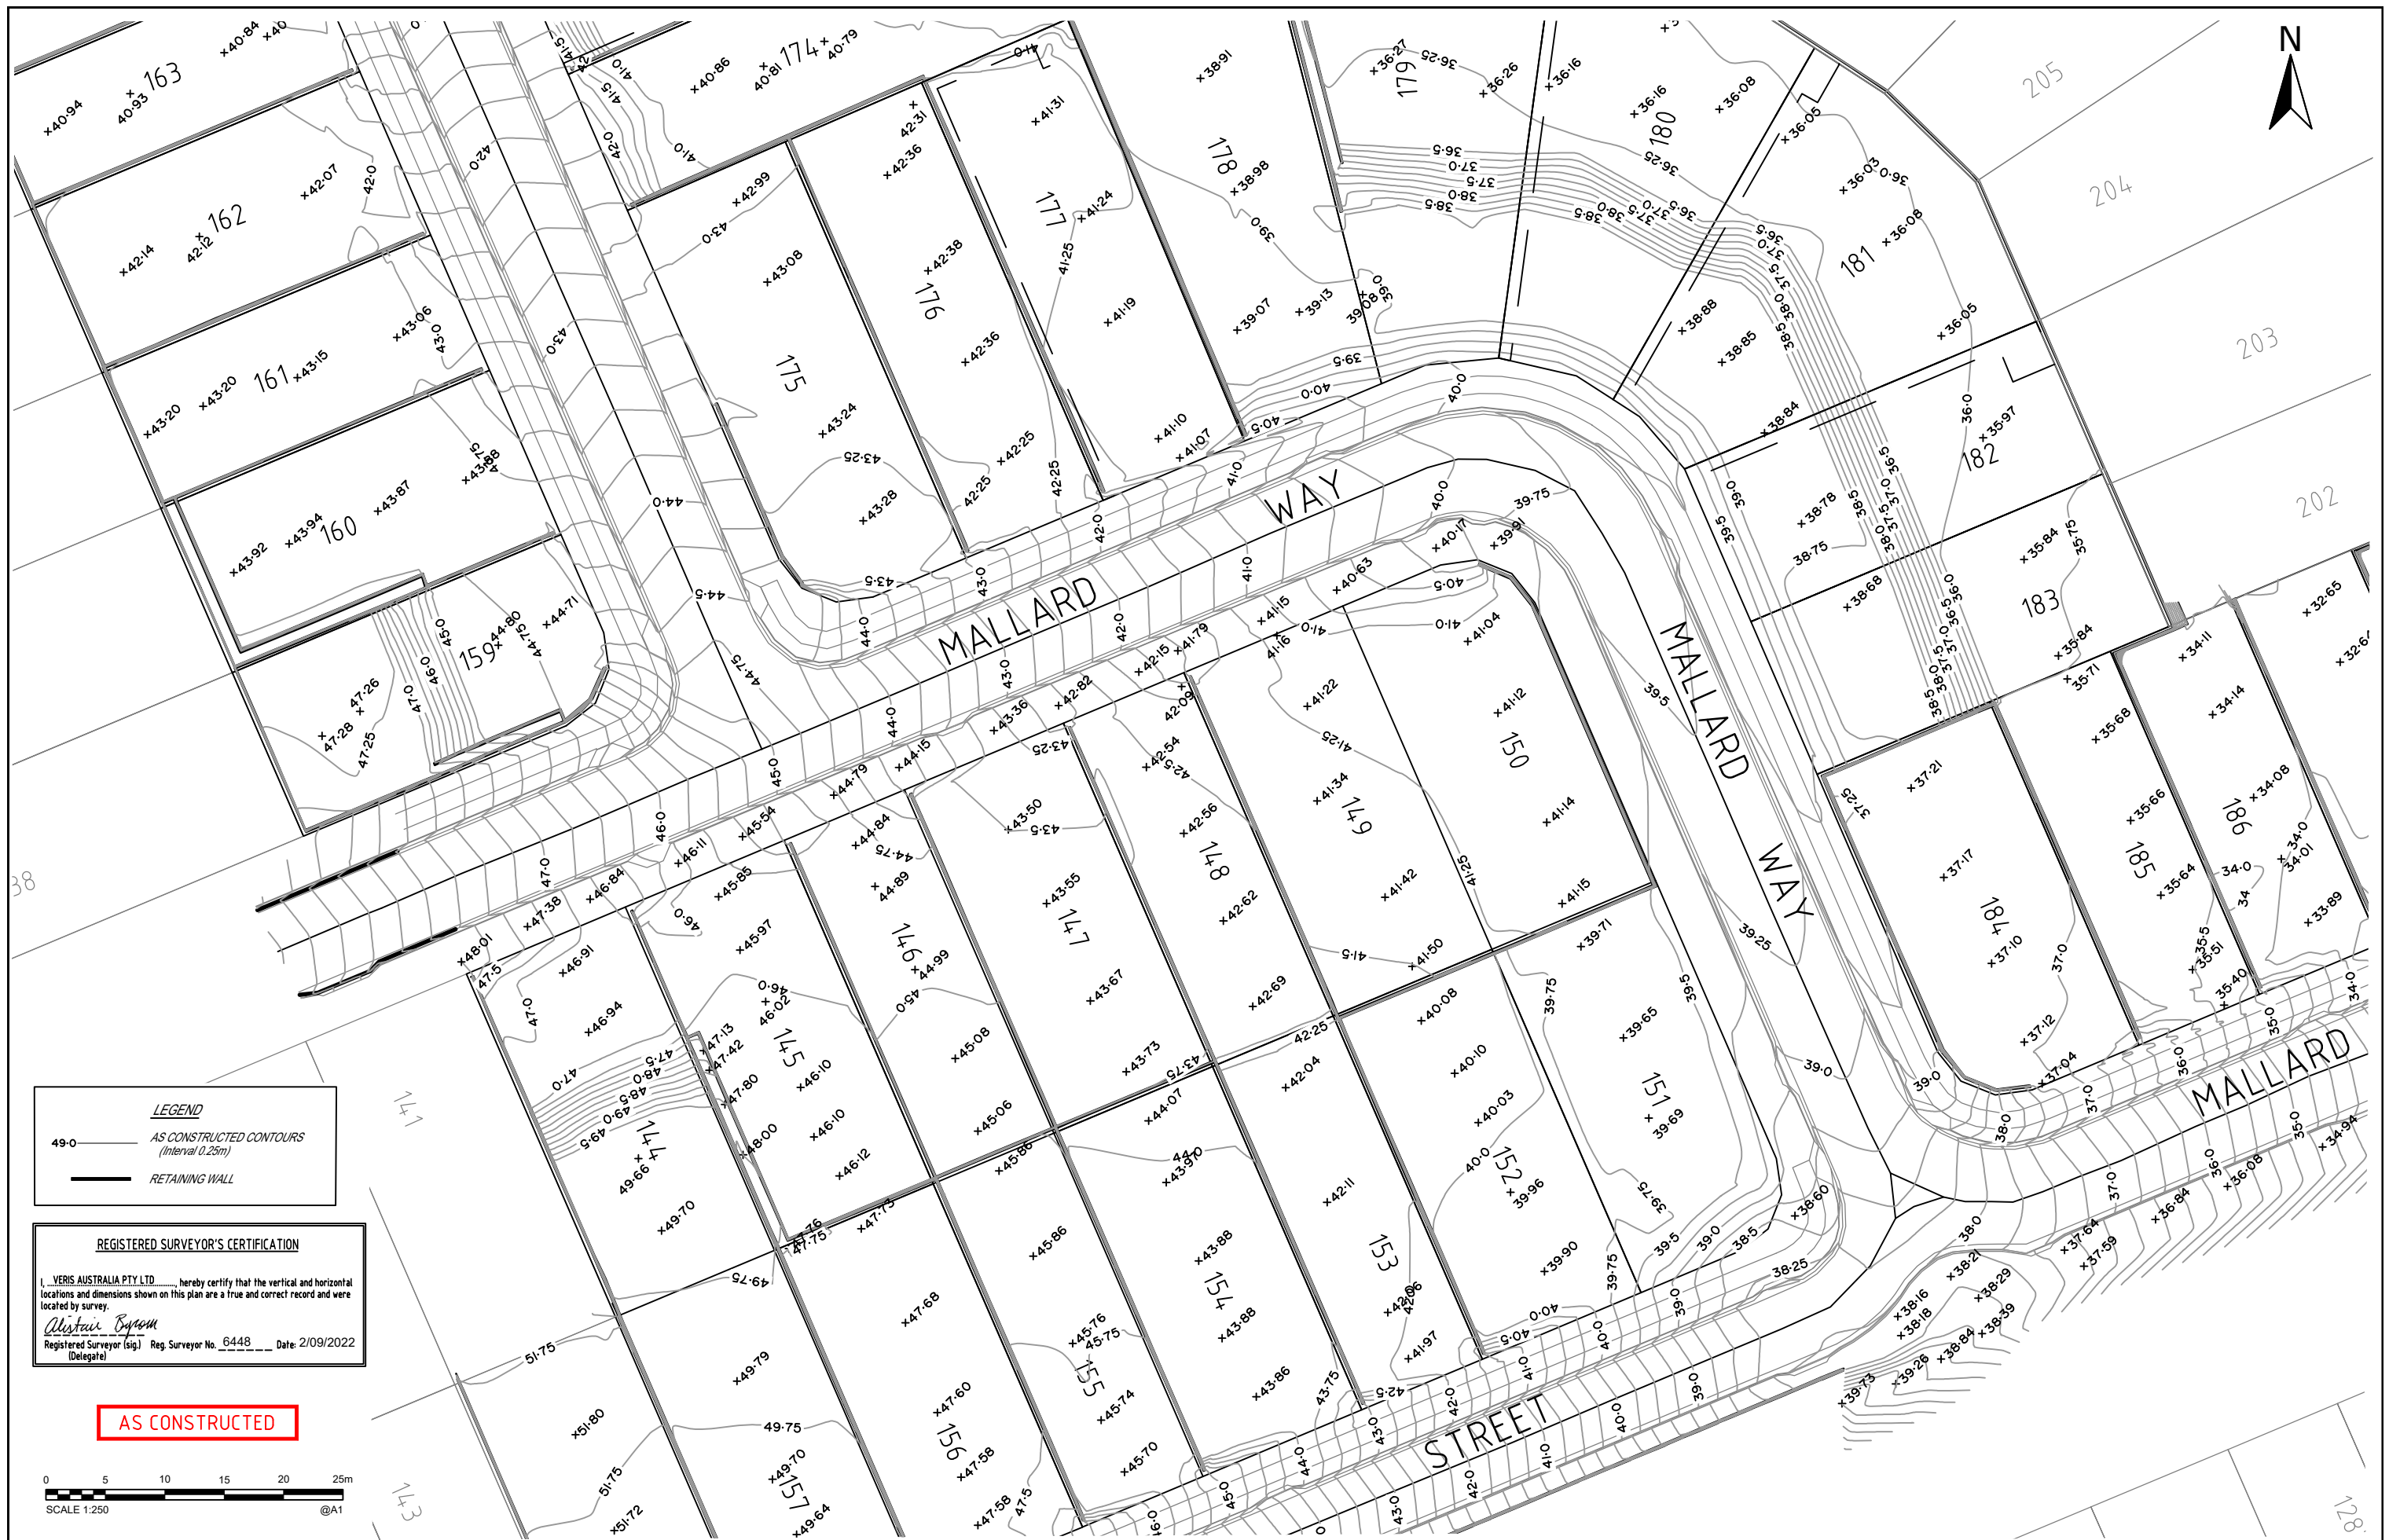

LEGEND
 49.0 — AS CONSTRUCTED CONTOURS
 (Interval 0.25m)
 ——— RETAINING WALL

REGISTERED SURVEYOR'S CERTIFICATION
 I, VERIS AUSTRALIA PTY LTD, hereby certify that the vertical and horizontal locations and dimensions shown on this plan are a true and correct record and were located by survey.
Alexander Byrom
 Registered Surveyor (sig) Reg. Surveyor No. 6448 Date: 2/09/2022
 (Delegate)

AS CONSTRUCTED

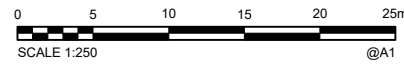

A1	INDEX	DATE	REVISIONS	DRAWN	CHECKED	PASSED
	A	31/08/2022	ORIGINAL	Jk		

DRAWN	Jk	31/08/2022
CHECKED	Jk	31/08/2022
PASSED		

INITIALS	DATE

veris
 BRISBANE (07) 3888 4700 WHITSUNDAYS (07) 4442 8600
 MACKAY (07) 4927 9700 CAIRNS (07) 4232 9400
 veris.com.au
 ACN 615 735 727
 Veris Australia Pty Ltd



IPSWICH CITY COUNCIL

BRENTWOOD STAGE 12
 AS CONSTRUCTED
 FINAL SURFACE

SCALE 1:250 @A1
 SHEET 3 OF 4 SHEETS
 DRAWING NO.
400891-AE12



LEGEND

49.0 — AS CONSTRUCTED CONTOURS
(Interval 0.25m)


— RETAINING WALL

REGISTERED SURVEYOR'S CERTIFICATION

I, VERIS AUSTRALIA PTY LTD, hereby certify that the vertical and horizontal locations and dimensions shown on this plan are a true and correct record and were located by survey.

Alexander Byrom
Registered Surveyor (sig.) Reg. Surveyor No. 6448 Date: 2/09/2022
(Delegate)

AS CONSTRUCTED

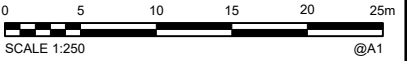

A1							
INDEX	DATE	ORIGINAL	REVISIONS	DRAWN	CHECKED	PASSED	

DRAWN	Jk	31/08/2022
CHECKED	Jk	31/08/2022
PASSED		
INITIALS		DATE



IPSWICH CITY COUNCIL

BRENTWOOD STAGE 12
AS CONSTRUCTED
FINAL SURFACE

SCALE	1:250 @A1
SHEET	6 OF 6 SHEETS
DRAWING NO.	400891-AE12