

**LEGEND**

SUPPLY PILLAR WITH S/N 1234567

STREET LIGHT WITH S/N W1234567


**REGISTERED SURVEYOR'S CERTIFICATION**

I, VERIS AUSTRALIA PTY LTD hereby certify that the vertical and horizontal locations and dimensions shown on this plan are a true and correct record and were located by survey.

*Alistair Byrom*  
Registered Surveyor (sig) Reg. Surveyor No. 6448 Date: 31/01/23

**COORDINATE DATUM NOTE:**  
HORIZONTAL COORDINATES (E,N) SUPPLIED ARE MAPPING GRID OF AUSTRALIA (MGA), ZONE 56 BASED ON THE UNIVERSAL TRANSVERSE MERCATOR PROJECTION AND THE GEDCENTRIC DATUM OF AUSTRALIA 2020.


**AS CONSTRUCTED**

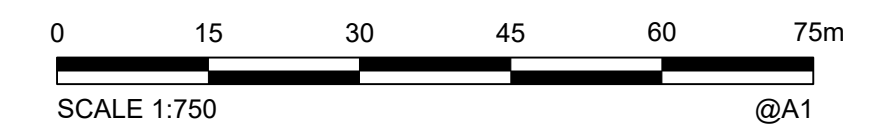

<b>A1</b>									
	A	23/12/2022	PROGRESS PLOT		JMc				
	INDEX	DATE	REVISIONS	DRAWN	CHECKED	PASSED	INITIALS	DATE	

**veris**

BRISBANE 071 3666 4700 WHITSUNDAYS 071 4945 6600  
MACKAY 071 4487 9100 CAIRNS 071 4032 3400  
veris.com.au  
ACN 616 736 727  
Veris Australia Pty Ltd

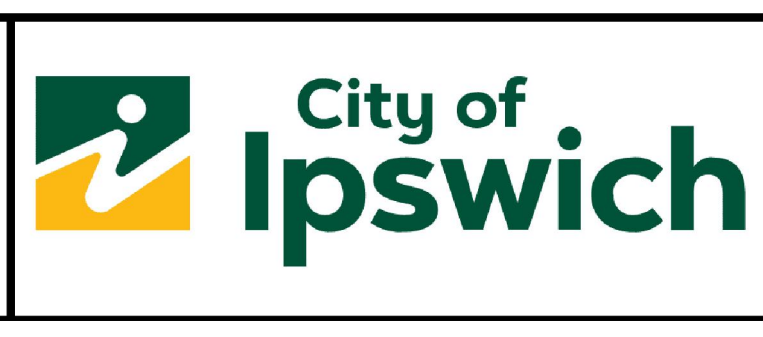

**IPSWICH CITY COUNCIL**

BRENTWOOD STAGES 12  
AS CONSTRUCTED  
ELECTRICAL

SCALE	1:750 @A1
SHEET	1 OF 4 SHEETS
DRAWING NO.	400891-AEL 12



LEGEND

SUPPLY PILLAR WITH S/N  1234567

STREET LIGHT WITH S/N  W1234567


REGISTERED SURVEYOR'S CERTIFICATION

I, VERIS AUSTRALIA PTY LTD, hereby certify that the vertical and horizontal locations and dimensions shown on this plan are a true and correct record and were located by survey.

*Alister Byrom*  
Registered Surveyor (sig) Reg. Surveyor No. 6448 Date: 31/01/23

COORDINATE DATUM NOTE:  
HORIZONTAL COORDINATES (E,N) SUPPLIED ARE MAPPING GRID OF AUSTRALIA (MGA), ZONE 56 BASED ON THE UNIVERSAL TRANSVERSE MERCATOR PROJECTION AND THE GEOCENTRIC DATUM OF AUSTRALIA 2020.

AS CONSTRUCTED

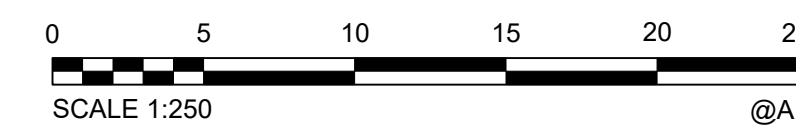

A1

INDEX	DATE	PROGRESS PLOT	REVISIONS	DRAWN	CHECKED	PASSED
A	23/12/2022	PROGRESS PLOT		JMc		

DRAWN	JMc	23/12/2022
CHECKED		
PASSED		
INITIALS		DATE

veris

BRISBANE (07) 3666 9700  
MACKAY (07) 4951 9700  
WHITSUNDAYS (07) 4945 9500  
CAIRNS (07) 4252 9400  
veris.com.au  
ACN 615 735 727  
Veris Australia Pty Ltd




IPSWICH CITY COUNCIL

BRENTWOOD STAGE 12  
AS CONSTRUCTED  
ELECTRICAL

SCALE 1:250 @A1  
SHEET 2 OF 4 SHEETS  
DRAWING NO.  
400891-AEL 12



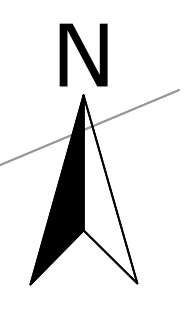

**STAGE 12B**


**STAGE 12A**

**LEGEND**  
 SUPPLY PILLAR WITH S/N [Symbol] 1234567  
 STREET LIGHT WITH S/N [Symbol] W1234567

**REGISTERED SURVEYOR'S CERTIFICATION**  
 I, VERIS AUSTRALIA PTY LTD hereby certify that the vertical and horizontal locations and dimensions shown on this plan are a true and correct record and were located by survey.  
*Alistair Byrom*  
 Registered Surveyor (sig.) Reg. Surveyor No. 6448 Date: 31/01/23

**COORDINATE DATUM NOTE:**  
 HORIZONTAL COORDINATES (E,N) SUPPLIED ARE MAPPING GRID OF AUSTRALIA (MGA), ZONE 56 BASED ON THE UNIVERSAL TRANSVERSE MERCATOR PROJECTION AND THE GEOCENTRIC DATUM OF AUSTRALIA 2020.

**AS CONSTRUCTED**

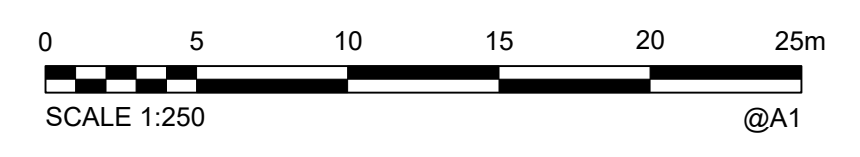

<b>A1</b>									
	A	23/12/2022	PROGRESS PLOT	JMc					
	INDEX	DATE	REVISIONS	DRAWN	CHECKED	PASSED	INITIALS	DATE	





BRISBANE (07) 3668 9700  
 MACKAY (07) 4957 9700  
 WHITSUNDAYS (07) 4946 0500  
 CAIRNS (07) 4252 9400  
 veris.com.au  
 ACN 615 735 727  
 Veris Australia Pty Ltd



**IPSWICH CITY COUNCIL**



BRENTWOOD STAGE 12  
 AS CONSTRUCTED  
 ELECTRICAL

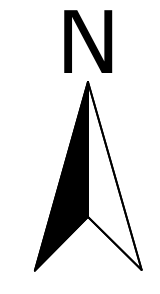SCALE	1:250 @A1
SHEET	3 OF 4 SHEETS
DRAWING NO.	400891-AEL 12




COORDINATE DATUM NOTE:  
 HORIZONTAL COORDINATES (E,N) SUPPLIED  
 ARE MAPPING GRID OF AUSTRALIA (MGA),  
 ZONE 56 BASED ON THE UNIVERSAL  
 TRANSVERSE MERCATOR PROJECTION AND  
 THE GEODCENTRIC DATUM OF AUSTRALIA  
 2020.

LEGEND

- SUPPLY PILLAR WITH S/N  1234567
- STREET LIGHT WITH S/N  W1234567


REGISTERED SURVEYOR'S CERTIFICATION

I, VERIS AUSTRALIA PTY LTD hereby certify that the vertical and horizontal  
 locations and dimensions shown on this plan are a true and correct record and were  
 located by survey.

  
 Registered Surveyor (sig) Reg. Surveyor No. 6448 Date: 31/01/23



AS CONSTRUCTED

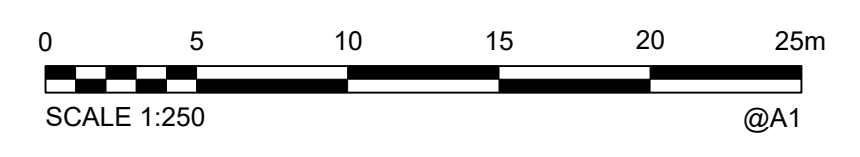

A1	INDEX	DATE	REVISIONS	DRAWN	CHECKED	PASSED
	A	23/12/2022	PROGRESS PLOT	JMc		

DRAWN	JMc	23/12/2022
CHECKED		
PASSED		
INITIALS		DATE

**veris**  
 BRISBANE (07) 3668 9700 WHITSUNDAYS (07) 4946 0500  
 MACKAY (07) 4957 9700 CAIRNS (07) 4252 9400  
 veris.com.au  
 ACN 615 735 727  
 Veris Australia Pty Ltd



IPSWICH CITY COUNCIL

BRENTWOOD STAGE 12  
 AS CONSTRUCTED  
 ELECTRICAL

SCALE	1:250 @A1
SHEET	4 OF 4 SHEETS
DRAWING NO.	400891-AEL 12