

**LEGEND**

SUPPLY PILLAR WITH S/N 1234567

STREET LIGHT WITH S/N W1234567


**REGISTERED SURVEYOR'S CERTIFICATION**

I, VERIS AUSTRALIA PTY LTD hereby certify that the vertical and horizontal locations and dimensions shown on this plan are a true and correct record and were located by survey.

*Alistair Byrom*  
Registered Surveyor (sig) Reg. Surveyor No. 6448 Date: 31/01/23

**COORDINATE DATUM NOTE:**  
HORIZONTAL COORDINATES (E,N) SUPPLIED ARE MAPPING GRID OF AUSTRALIA (MGA), ZONE 56 BASED ON THE UNIVERSAL TRANSVERSE MERCATOR PROJECTION AND THE GEDCENTRIC DATUM OF AUSTRALIA 2020.


**AS CONSTRUCTED**

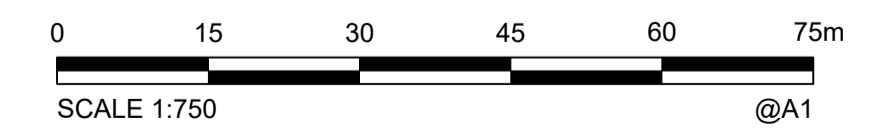

<b>A1</b>									
	A	23/12/2022	PROGRESS PLOT		JMc				
	INDEX	DATE	REVISIONS	DRAWN	CHECKED	PASSED	INITIALS	DATE	

**veris**

BRISBANE 071 3666 4700 WHITSUNDAYS 071 4945 6600  
MACKAY 071 4487 9100 CAIRNS 071 4032 3400  
veris.com.au  
ACN 616 736 727  
Veris Australia Pty Ltd

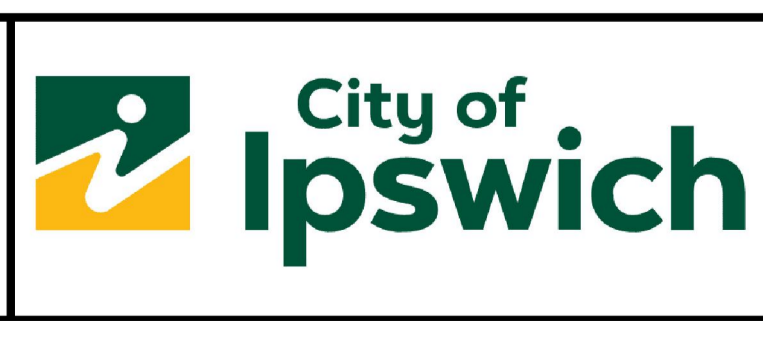

**IPSWICH CITY COUNCIL**

BRENTWOOD STAGES 12  
AS CONSTRUCTED  
ELECTRICAL

SCALE	1:750 @A1
SHEET	1 OF 4 SHEETS
DRAWING NO.	400891-AEL 12



LEGEND

SUPPLY PILLAR WITH S/N  1234567

STREET LIGHT WITH S/N  W1234567


REGISTERED SURVEYOR'S CERTIFICATION

I, VERIS AUSTRALIA PTY LTD, hereby certify that the vertical and horizontal locations and dimensions shown on this plan are a true and correct record and were located by survey.

*Alister Byrom*  
Registered Surveyor (sig) Reg. Surveyor No. 6448 Date: 31/01/23

COORDINATE DATUM NOTE:  
HORIZONTAL COORDINATES (E,N) SUPPLIED ARE MAPPING GRID OF AUSTRALIA (MGA), ZONE 56 BASED ON THE UNIVERSAL TRANSVERSE MERCATOR PROJECTION AND THE GEOCENTRIC DATUM OF AUSTRALIA 2020.

AS CONSTRUCTED

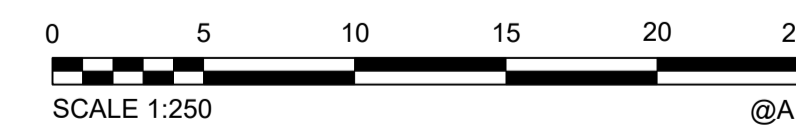

A1

INDEX	DATE	REVISIONS	DRAWN	CHECKED	PASSED
A	23/12/2022	PROGRESS PLOT	JMc		

DRAWN	CHECKED	DATE
JMc		23/12/2022

veris

BRISBANE (07) 3668 9700  
MACKAY (07) 4951 9700  
WHITSUNDAYS (07) 4945 9500  
CAIRNS (07) 4252 9400  
veris.com.au  
ACN 615 735 727  
Veris Australia Pty Ltd



IPSWICH CITY COUNCIL

BRENTWOOD STAGE 12  
AS CONSTRUCTED  
ELECTRICAL

SCALE 1:250 @A1  
SHEET 2 OF 4 SHEETS  
DRAWING NO.  
400891-AEL 12



**LEGEND**

SUPPLY PILLAR WITH S/N 1234567

STREET LIGHT WITH S/N W1234567


**REGISTERED SURVEYOR'S CERTIFICATION**

I, VERIS AUSTRALIA PTY LTD hereby certify that the vertical and horizontal locations and dimensions shown on this plan are a true and correct record and were located by survey.

*Alistair Byrom*  
Registered Surveyor (sig.) Reg. Surveyor No. 6448 Date: 31/01/23

**COORDINATE DATUM NOTE:**  
HORIZONTAL COORDINATES (E,N) SUPPLIED ARE MAPPING GRID OF AUSTRALIA (MGA), ZONE 56 BASED ON THE UNIVERSAL TRANSVERSE MERCATOR PROJECTION AND THE GEOCENTRIC DATUM OF AUSTRALIA 2020.

**AS CONSTRUCTED**

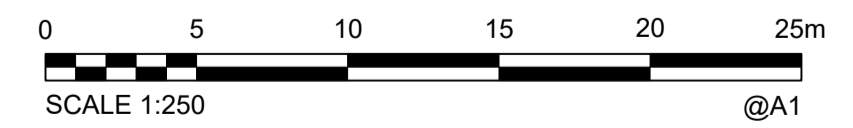

<b>A1</b>									
	A	23/12/2022	PROGRESS PLOT	JMc					
	INDEX	DATE	REVISIONS	DRAWN	CHECKED	PASSED	INITIALS	DATE	

**veris**


BRISBANE (07) 3668 9700 WHITSUNDAYS (07) 4946 0500  
 MACKAY (07) 4957 9700 CAIRNS (07) 4252 9400  
 veris.com.au  
 ACN 615 735 727  
 Veris Australia Pty Ltd



**IPSWICH CITY COUNCIL**

BRENTWOOD STAGE 12  
AS CONSTRUCTED  
ELECTRICAL

SCALE 1:250 @A1  
 SHEET 3 OF 4 SHEETS  
 DRAWING NO.  
 400891-AEL 12

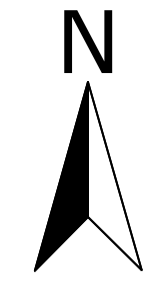

**COORDINATE DATUM NOTE:**  
 HORIZONTAL COORDINATES (E,N) SUPPLIED ARE MAPPING GRID OF AUSTRALIA (MGA), ZONE 56 BASED ON THE UNIVERSAL TRANSVERSE MERCATOR PROJECTION AND THE GEODCENTRIC DATUM OF AUSTRALIA 2020.

**LEGEND**

SUPPLY PILLAR WITH S/N 1234567


STREET LIGHT WITH S/N W1234567

**REGISTERED SURVEYOR'S CERTIFICATION**

I, **VERIS AUSTRALIA PTY LTD** hereby certify that the vertical and horizontal locations and dimensions shown on this plan are a true and correct record and were located by survey.

*Alister Byrom*  
 Registered Surveyor (sig) Reg. Surveyor No. 6448 Date: 31/01/23

**AS CONSTRUCTED**

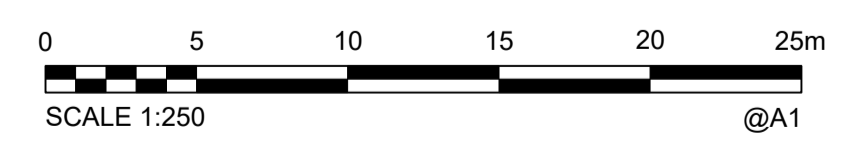

<b>A1</b>									
	A	23/12/2022	PROGRESS PLOT	JMc					
INDEX	DATE	REVISIONS	DRAWN	CHECKED	PASSED	INITIALS	DATE		

DRAWN	JMc	23/12/2022
CHECKED		
PASSED		

**veris**

BRISBANE (07) 3668 9700 WHITSUNDAYS (07) 4946 0500  
 MACKAY (07) 4957 9700 CAIRNS (07) 4252 9400  
 veris.com.au  
 ACN 615 735 727  
 Veris Australia Pty Ltd



**IPSWICH CITY COUNCIL**

BRENTWOOD STAGE 12  
 AS CONSTRUCTED  
 ELECTRICAL

SCALE 1:250 @A1  
 SHEET 4 OF 4 SHEETS  
 DRAWING NO.  
**400891-AEL 12**