





LEGEND

SUPPLY PILLAR WITH S/N  1234567

STREET LIGHT WITH S/N  W1234567


REGISTERED SURVEYOR'S CERTIFICATION

I, VERIS AUSTRALIA PTY LTD hereby certify that the vertical and horizontal locations and dimensions shown on this plan are a true and correct record and were located by survey.

Alister Byrom
Registered Surveyor (sig) Reg. Surveyor No. 6448 Date: 31/01/23

COORDINATE DATUM NOTE:
HORIZONTAL COORDINATES (E,N) SUPPLIED ARE MAPPING GRID OF AUSTRALIA (MGA), ZONE 56 BASED ON THE UNIVERSAL TRANSVERSE MERCATOR PROJECTION AND THE GEDCENTRIC DATUM OF AUSTRALIA 2020.

AS CONSTRUCTED

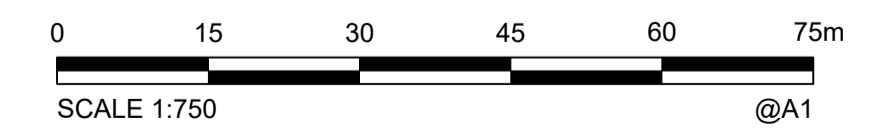

A1					
	A	23/12/2022	PROGRESS PLOT	JMc	
	INDEX	DATE	REVISIONS	DRAWN	CHECKED/PASSED

DRAWN	JMc	23/12/2022
CHECKED	JH	
PASSED		
	INITIALS	DATE

veris

BRISBANE WHITSUNDAYS
(07) 3666 4700 (07) 4945 6600

MACKAY CAIRNS
(07) 4607 9700 (07) 4032 9400


veris.com.au
ACN 616 736 727
Veris Australia Pty Ltd



IPSWICH CITY COUNCIL

BRENTWOOD STAGES 13
AS CONSTRUCTED
ELECTRICAL

SCALE	1:750 @A1
SHEET	1 OF 3 SHEETS
DRAWING NO.	400891-AEL 13

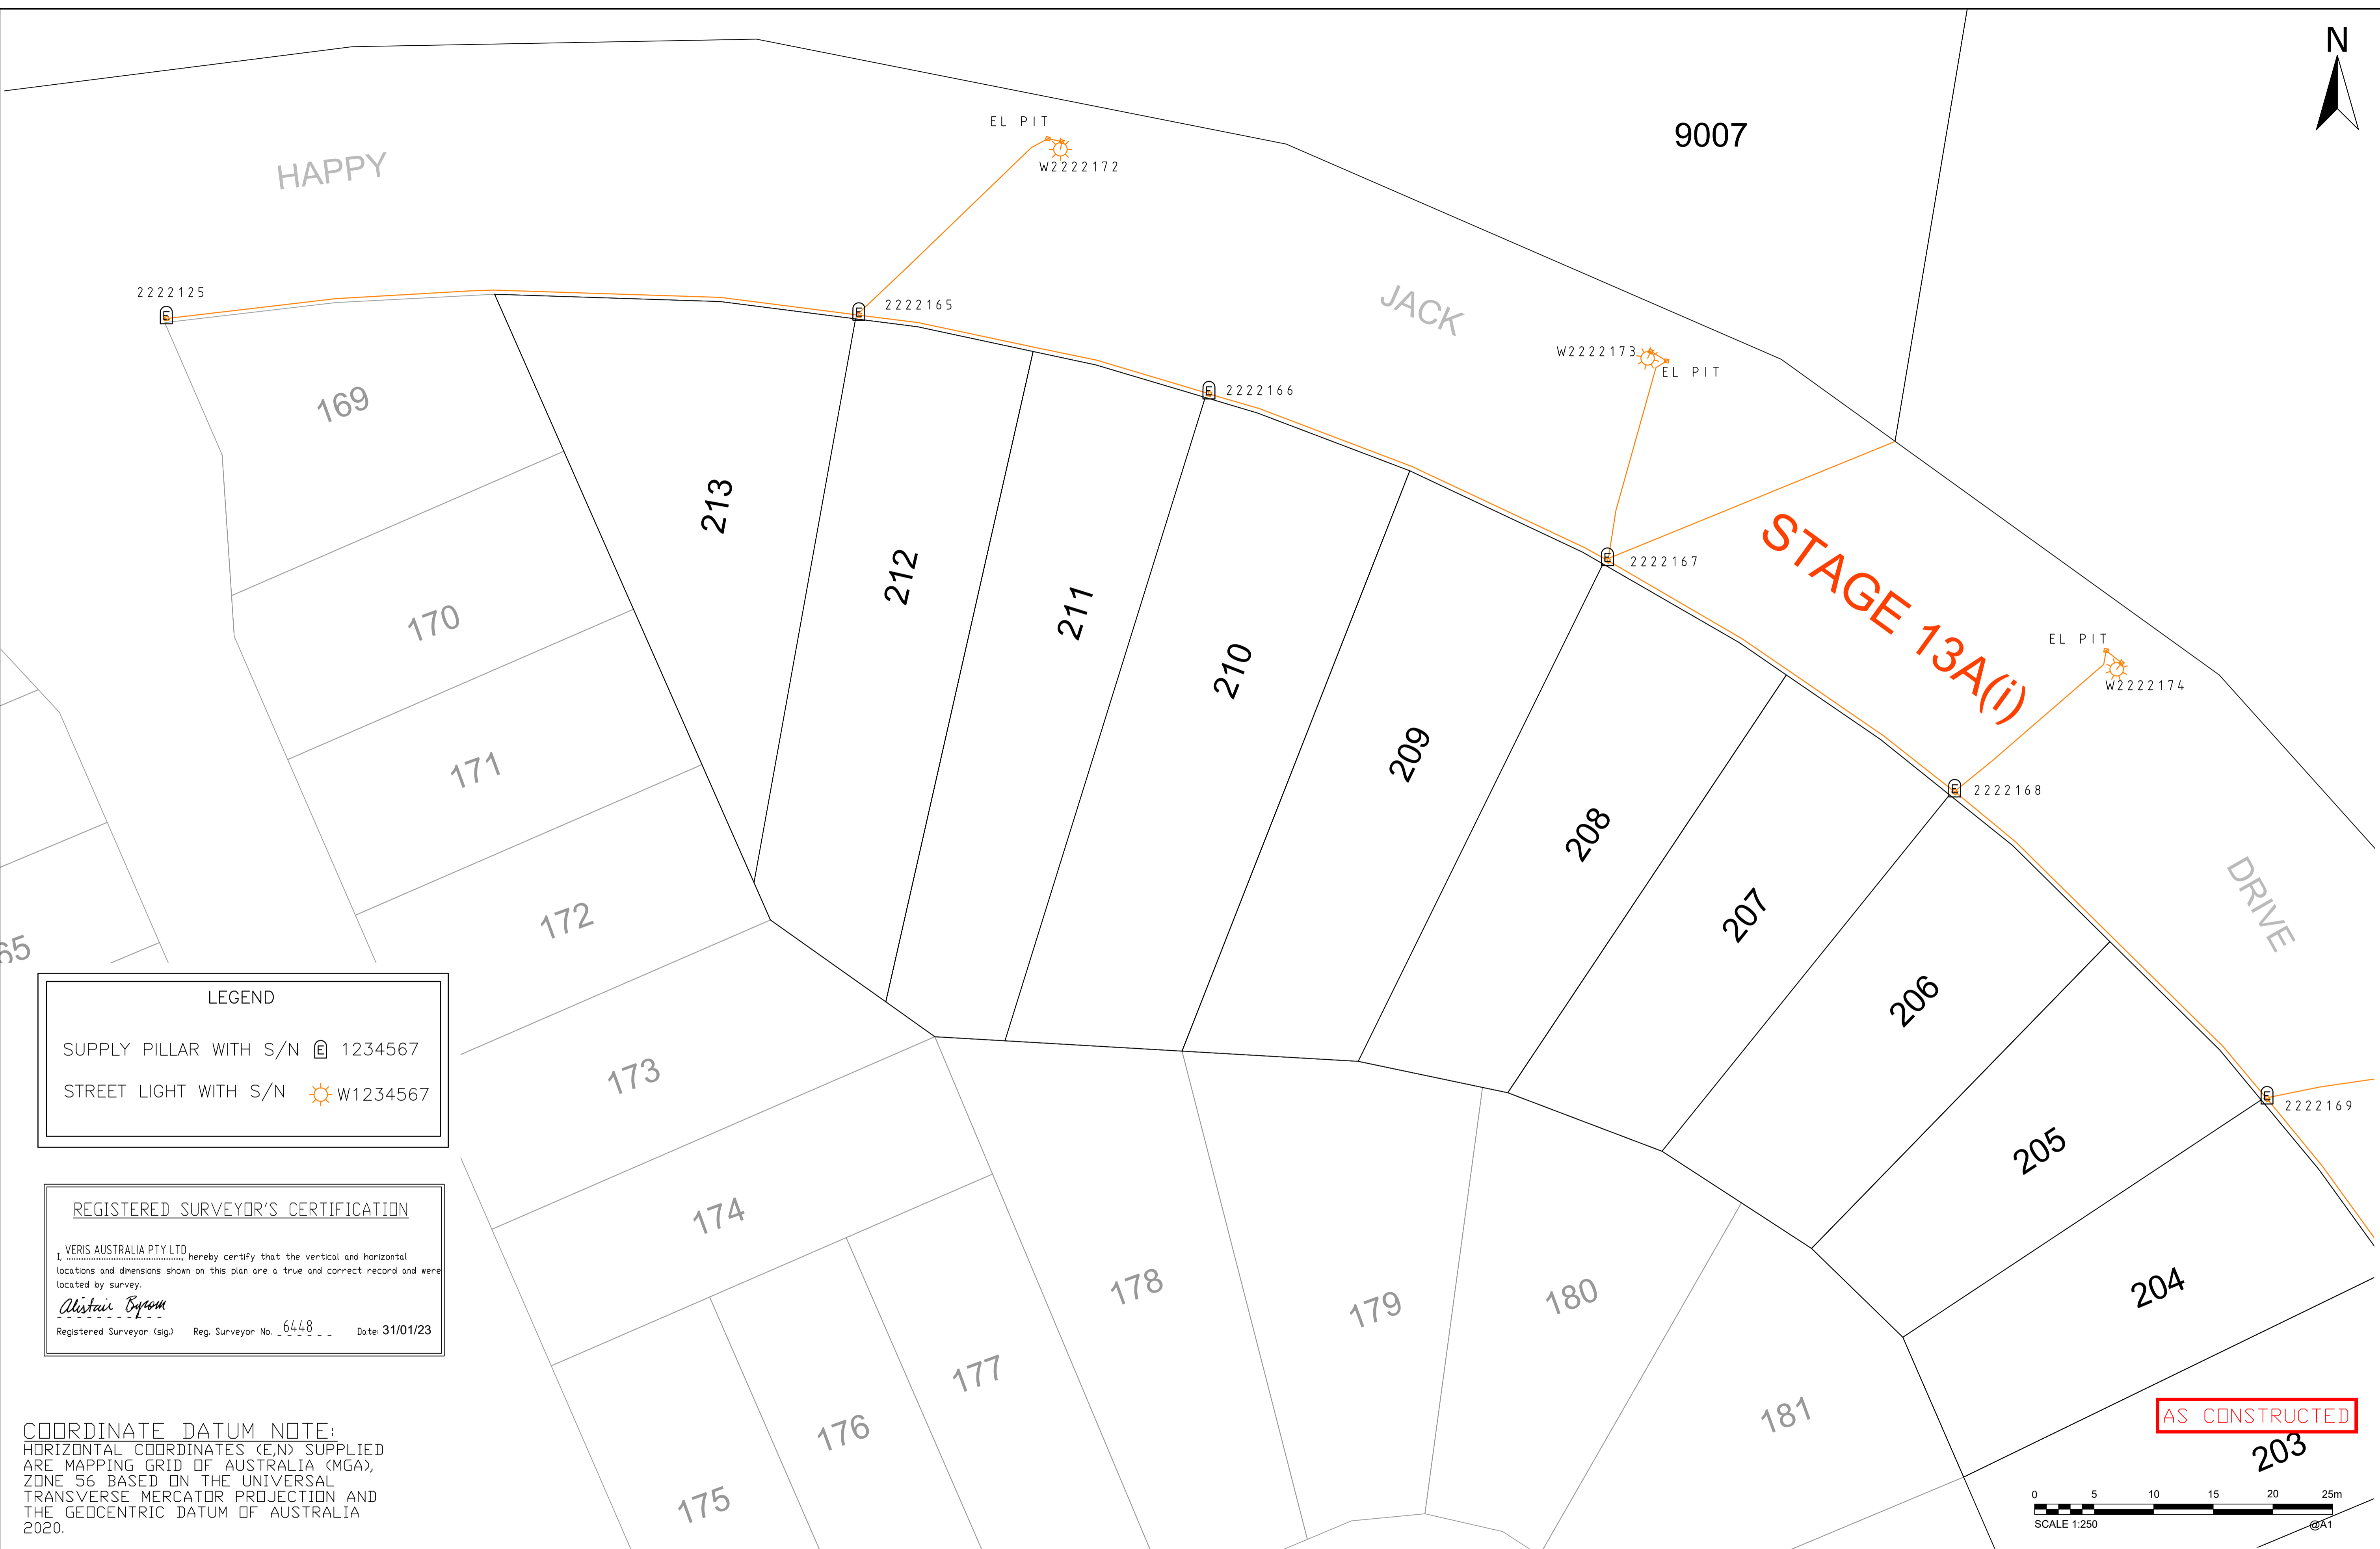

LEGEND


SUPPLY PILLAR WITH S/N E 1234567
STREET LIGHT WITH S/N W1234567

REGISTERED SURVEYOR'S CERTIFICATION

VERIS AUSTRALIA PTY LTD, hereby certify that the vertical and horizontal locations and dimensions shown on this plan are a true and correct record and were located by survey.
Alistair Symon
Registered Surveyor (sig) Reg. Surveyor No. 6448 Date: 31/01/23

COORDINATE DATUM NOTE:
HORIZONTAL COORDINATES (E,N) SUPPLIED ARE MAPPING GRID OF AUSTRALIA (MGA), ZONE 56 BASED ON THE UNIVERSAL TRANSVERSE MERCATOR PROJECTION AND THE GEODESIC DATUM OF AUSTRALIA 2020.

AS CONSTRUCTED

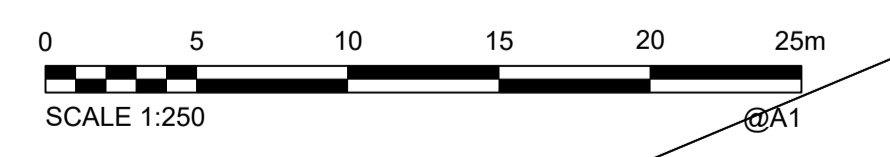

A1

INDEX	DATE	PROGRESS PLOT	REVISIONS	DRAWN	CHECKED	PASSED
A	23/12/2022	PROGRESS PLOT		JMc		

DRAWN	JMc	23/12/2022
CHECKED		
PASSED		
INITIALS		DATE

veris


BRISBANE (07) 3668 9700 WHITSUNDAYS (07) 4946 0500
MACKAY (07) 4957 9700 CAIRNS (07) 4252 9400
veris.com.au
ACN 615 735 727
Veris Australia Pty Ltd




IPSWICH CITY COUNCIL

BRENTWOOD STAGE 13
AS CONSTRUCTED
ELECTRICAL

SCALE	1:250 @A1
SHEET	2 OF 3 SHEETS
DRAWING NO.	400891-AEL 13

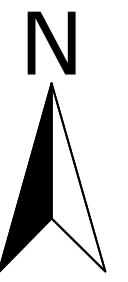

9008

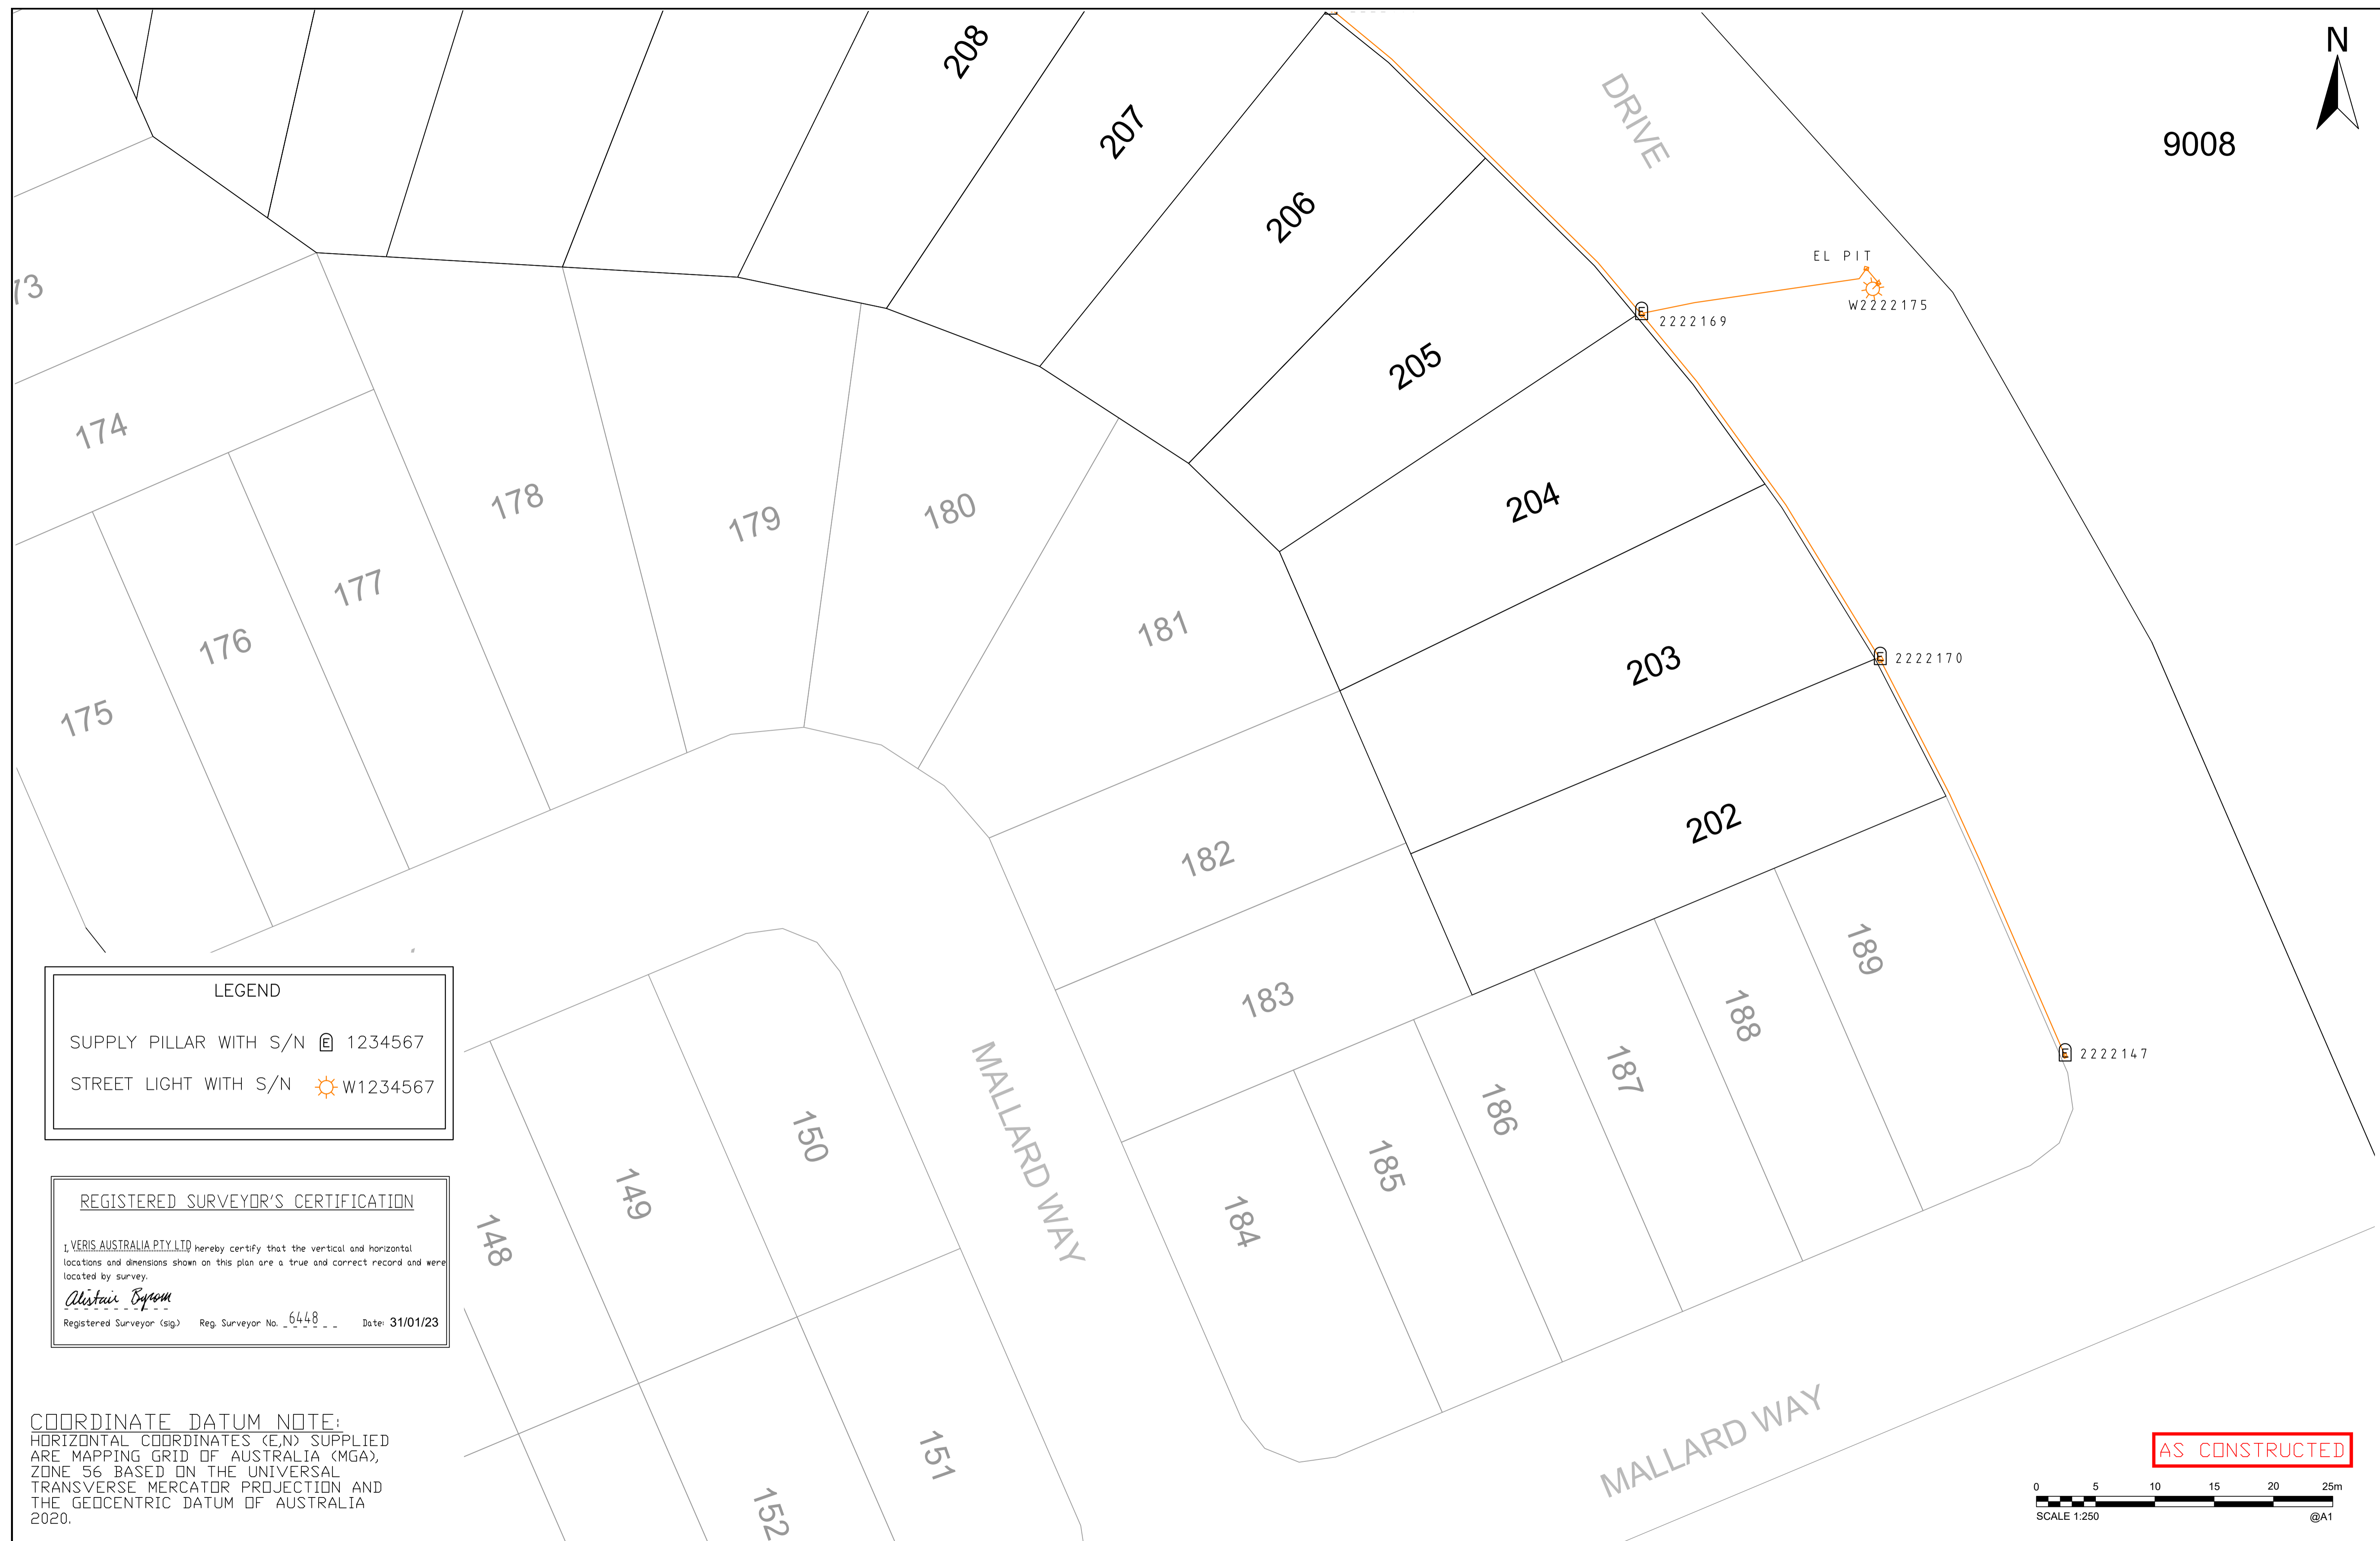

LEGEND

SUPPLY PILLAR WITH S/N 1234567

STREET LIGHT WITH S/N W1234567


REGISTERED SURVEYOR'S CERTIFICATION

I, VERIS AUSTRALIA PTY LTD hereby certify that the vertical and horizontal locations and dimensions shown on this plan are a true and correct record and were located by survey.

Alastair Byron
Registered Surveyor (sig.) Reg. Surveyor No. 6448 Date: 31/01/23

COORDINATE DATUM NOTE:
HORIZONTAL COORDINATES (E,N) SUPPLIED ARE MAPPING GRID OF AUSTRALIA (MGA), ZONE 56 BASED ON THE UNIVERSAL TRANSVERSE MERCATOR PROJECTION AND THE GEODESIC DATUM OF AUSTRALIA 2020.

AS CONSTRUCTED

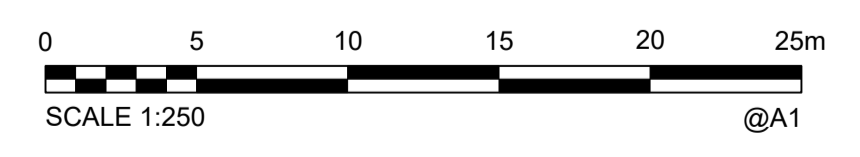


A1	A	23/12/2022	PROGRESS PLOT	JMc		
	INDEX	DATE	REVISIONS	DRAWN	CHECKED	PASSED

DRAWN	JMc	23/12/2022
CHECKED		
PASSED		
INITIALS	DATE	

veris

BRISBANE (07) 3668 9700 WHITSUNDAYS (07) 4946 0500
 MACKAY (07) 4957 9700 CAIRNS (07) 4252 9400
 veris.com.au
 ACN 615 735 727
 Veris Australia Pty Ltd

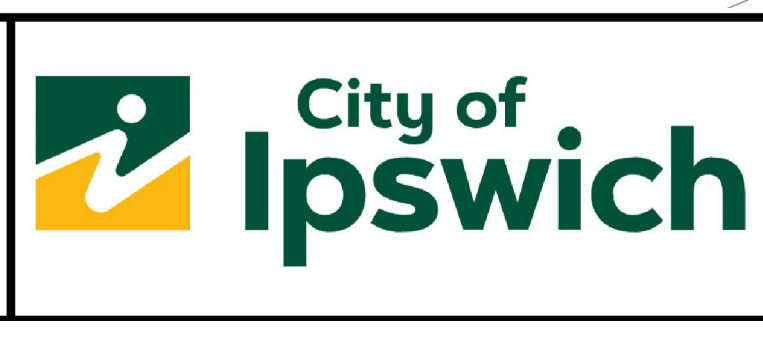

IPSWICH CITY COUNCIL

BRENTWOOD STAGE 13
AS CONSTRUCTED
ELECTRICAL

SCALE	1:250 @A1
SHEET	3 OF 3 SHEETS
DRAWING NO.	400891-AEL 13