




LEGEND
 SUPPLY PILLAR WITH S/N 2221886
 STREET LIGHT WITH S/N W2221897

REGISTERED SURVEYOR'S CERTIFICATION
 I, VERIS AUSTRALIA PTY LTD, hereby certify that the vertical and horizontal locations and dimensions shown on this plan are a true and correct record and were located by survey.
Alastair Byrom
 Registered Surveyor (sig.) Reg. Surveyor No. 6448 Date: 23/09/2022

COORDINATE DATUM NOTE:
 HORIZONTAL COORDINATES (E,N) SUPPLIED ARE MAPPING GRID OF AUSTRALIA (MGA), ZONE 56 BASED ON THE UNIVERSAL TRANSVERSE MERCATOR PROJECTION AND THE GEOCENTRIC DATUM OF AUSTRALIA 1994.

AS CONSTRUCTED

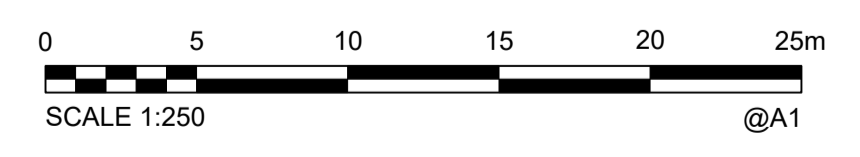

A1									
	B	05/09/2022	PROGRESS PLOT						
	A	30/03/2022	PROGRESS PLOT						
	INDEX	DATE	REVISIONS	DRAWN	CHECKED	PASSED			

DRAWN	JMc	30/03/2022			
CHECKED					
PASSED					
	INITIALS	DATE			

veris
 BRISBANE (07) 3668 9700
 MACKAY (07) 4951 9700
 WHITSUNDAYS (07) 4946 0600
 CAIRNS (07) 4252 9400
 veris.com.au
 ACN 615 735 727
 Veris Australia Pty Ltd



IPSWICH CITY COUNCIL

BRENTWOOD STAGE 8 & 10
 AS CONSTRUCTED
 ELECTRICAL

SCALE	1:250 @A1
SHEET	2 OF 7 SHEETS
DRAWING NO.	400891-AEL 8-10
	B
	A



LEGEND

SUPPLY PILLAR WITH S/N	⊞	2221886
STREET LIGHT WITH S/N	☀	W2221897

REGISTERED SURVEYOR'S CERTIFICATION

I, VERIS AUSTRALIA PTY LTD, hereby certify that the vertical and horizontal locations and dimensions shown on this plan are a true and correct record and were located by survey.

Alistair Byron
 Registered Surveyor (sig.) Reg. Surveyor No. 6448 Date: 23/09/2022

COORDINATE DATUM NOTE:
 HORIZONTAL COORDINATES (E,N) SUPPLIED ARE MAPPING GRID OF AUSTRALIA (MGA), ZONE 56 BASED ON THE UNIVERSAL TRANSVERSE MERCATOR PROJECTION AND THE GEOCENTRIC DATUM OF AUSTRALIA 1994.

AS CONSTRUCTED

0 5 10 15 20 25m
 SCALE 1:250 @A1

A1	B	05/09/2022	PROGRESS PLOT	JMc		
	A	30/03/2022	PROGRESS PLOT	JMc		
	INDEX	DATE	REVISIONS	DRAWN	CHECKED	PASSED

DRAWN	JMc	30/03/2022
CHECKED		
PASSED		
INITIALS		DATE

veris

BRISBANE (07) 3666 4700 WHITSUNDAYS (07) 4945 8600
 MACKAY (07) 4607 9700 CAIRNS (07) 4200 3400
 veris.com.au
 ACN 615 735 727
 Veris Australia Pty Ltd



IPSWICH CITY COUNCIL

BRENTWOOD STAGE 8 & 10
 AS CONSTRUCTED
 ELECTRICAL

SCALE	1:250 @A1
SHEET	3 OF 7 SHEETS
DRAWING NO.	400891-AEL 8-10
	A


PUR 389

REGISTERED SURVEYOR'S CERTIFICATION
 I, VERIS AUSTRALIA PTY LTD, hereby certify that the vertical and horizontal locations and dimensions shown on this plan are a true and correct record and were located by survey.
Alistair Byrom
 Registered Surveyor (sig.) Reg. Surveyor No. 6448 Date: 23/09/2022

LEGEND
 SUPPLY PILLAR WITH S/N 2221886
 STREET LIGHT WITH S/N W2221897



COORDINATE DATUM NOTE:
 HORIZONTAL COORDINATES (E,N) SUPPLIED ARE MAPPING GRID OF AUSTRALIA (MGA), ZONE 56 BASED ON THE UNIVERSAL TRANSVERSE MERCATOR PROJECTION AND THE GEOCENTRIC DATUM OF AUSTRALIA 1994.

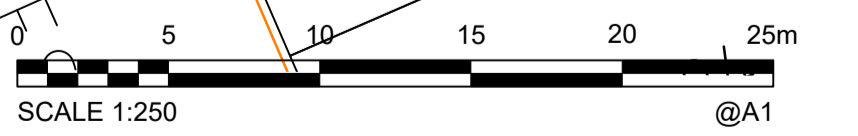

AS CONSTRUCTED

A1								
	B	05/09/2022	PROGRESS PLOT				JMc	
	A	30/03/2022	PROGRESS PLOT				JMc	
	INDEX	DATE	REVISIONS	DRAWN	CHECKED	PASSED		

DRAWN	JMc	30/03/2022
CHECKED		
PASSED		
INITIALS		DATE

veris
 BRISBANE (07) 3666 4700 WHITSUNDAYS (07) 4945 6600
 MACKAY (07) 4957 9100 CAIRNS (07) 4252 9400
 veris.com.au
 ACN 615 735 727
 Veris Australia Pty Ltd



IPSWICH CITY COUNCIL


BRENTWOOD STAGE 8 & 10
 AS CONSTRUCTED
 ELECTRICAL

SCALE	1:250 @A1
SHEET	4 OF 7 SHEETS
DRAWING NO.	400891-AEL 8-10

REGISTERED SURVEYOR'S CERTIFICATION

I, VERIS AUSTRALIA PTY LTD, hereby certify that the vertical and horizontal locations and dimensions shown on this plan are a true and correct record and were located by survey.

Alister Byron
 Registered Surveyor (sig.) Reg. Surveyor No. 6448 Date: 23/09/2022

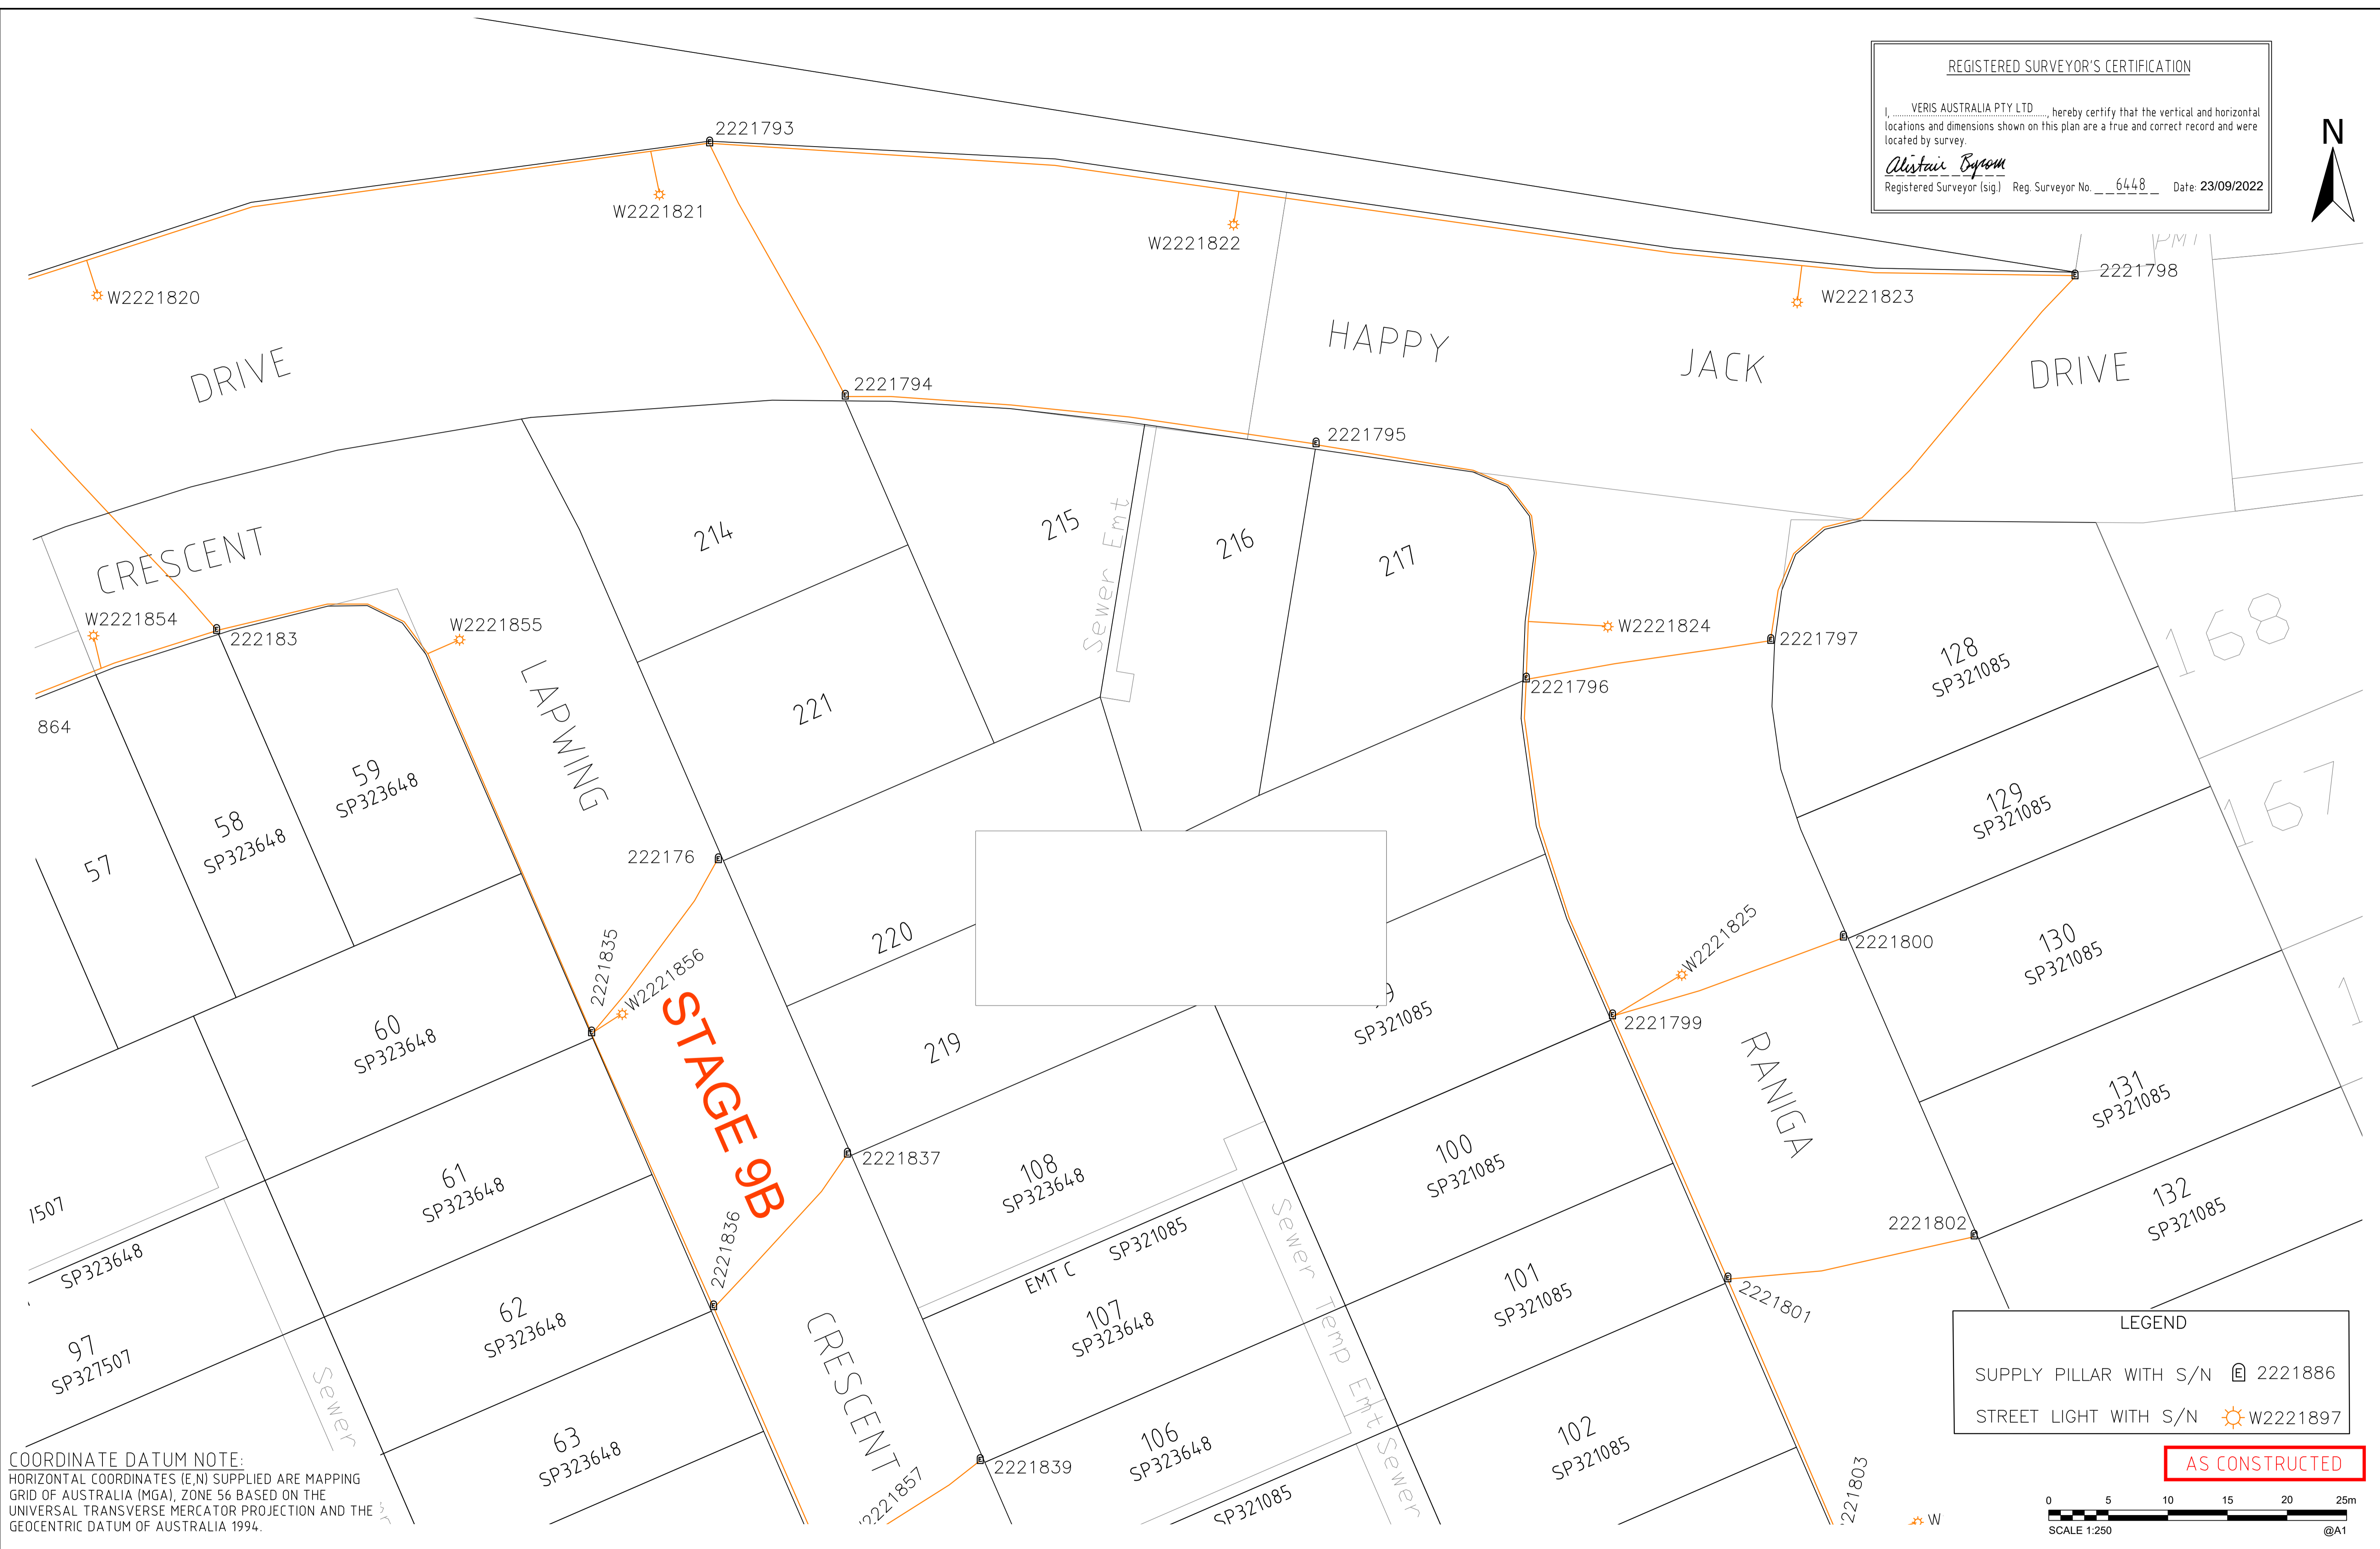

COORDINATE DATUM NOTE:
 HORIZONTAL COORDINATES (E,N) SUPPLIED ARE MAPPING GRID OF AUSTRALIA (MGA), ZONE 56 BASED ON THE UNIVERSAL TRANSVERSE MERCATOR PROJECTION AND THE GEOCENTRIC DATUM OF AUSTRALIA 1994.

LEGEND

SUPPLY PILLAR WITH S/N 2221886

STREET LIGHT WITH S/N W2221897

AS CONSTRUCTED

0 5 10 15 20 25m
 SCALE 1:250 @A1

A1	B	05/09/2022	PROGRESS PLOT	JMc						
	A	30/03/2022	PROGRESS PLOT	JMc						
	INDEX	DATE	REVISIONS	DRAWN	CHECKED	PASSED	INITIALS	DATE		

veris

BRISBANE (07) 3666 4700 WHITSUNDAYS (07) 4945 6000
 MACKAY (07) 4957 9700 CAIRNS (07) 4252 9400
 veris.com.au
 ACN 615 735 727
 Veris Australia Pty Ltd



IPSWICH CITY COUNCIL

BRENTWOOD STAGE 8 & 10
 AS CONSTRUCTED
 ELECTRICAL

SCALE 1:250 @A1
 SHEET 5 OF 7 SHEETS
 DRAWING NO.
400891-AEL 8-10



REGISTERED SURVEYOR'S CERTIFICATION
 I, VERIS AUSTRALIA PTY LTD, hereby certify that the vertical and horizontal locations and dimensions shown on this plan are a true and correct record and were located by survey.
Alastair Byrom
 Registered Surveyor (Sig) Reg. Surveyor No. 6448 Date: 23/09/2022

LEGEND
 SUPPLY PILLAR WITH S/N □ 2221886
 STREET LIGHT WITH S/N ☀ W2221897

COORDINATE DATUM NOTE:
 HORIZONTAL COORDINATES (E,N) SUPPLIED ARE MAPPING GRID OF AUSTRALIA (MGA), ZONE 56 BASED ON THE UNIVERSAL TRANSVERSE MERCATOR PROJECTION AND THE GEOCENTRIC DATUM OF AUSTRALIA 1994.

SCALE 1:250 @A1
 AS CONSTRUCTED

A1	B	05/09/2022	PROGRESS PLOT	JMc							
	A	30/03/2022	PROGRESS PLOT	JMc							
	INDEX DATE REVISIONS			DRAWN	CHECKED	PASSED	INITIALS	DATE			

BRISBANE (07) 3666 4700 WHITSUNDAYS (07) 4945 6600
 MACKAY (07) 4957 9700 CAIRNS (07) 4252 9400
 veris.com.au
 ACN 615 735 727
 Veris Australia Pty Ltd



IPSWICH CITY COUNCIL
 BRENTWOOD STAGE 8 & 10
 AS CONSTRUCTED ELECTRICAL


SCALE	1:250 @A1
SHEET	6 OF 7 SHEETS
DRAWING NO.	400891-AEL 8-10



REGISTERED SURVEYOR'S CERTIFICATION
 I, VERIS AUSTRALIA PTY LTD, hereby certify that the vertical and horizontal locations and dimensions shown on this plan are a true and correct record and were located by survey.
Alistair Symon
 Registered Surveyor (Sig) Reg. Surveyor No. 6448 Date: 23/09/2022

LEGEND
 SUPPLY PILLAR WITH S/N 2221886
 STREET LIGHT WITH S/N W2221897

COORDINATE DATUM NOTE:
 HORIZONTAL COORDINATES (E,N) SUPPLIED ARE MAPPING GRID OF AUSTRALIA (MGA), ZONE 56 BASED ON THE UNIVERSAL TRANSVERSE MERCATOR PROJECTION AND THE GEOCENTRIC DATUM OF AUSTRALIA 1994.

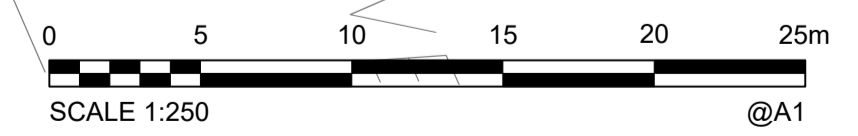


A1	B	05/09/2022	PROGRESS PLOT	JMc		
	A	30/03/2022	PROGRESS PLOT	JMc		
	INDEX	DATE	REVISIONS	DRAWN	CHECKED	PASSED

DRAWN	JMc	30/03/2022
CHECKED		
PASSED		
INITIALS		DATE

veris

BRISBANE (07) 3666 4700 WHITSUNDAYS (07) 4945 6600
 MACKAY (07) 4957 9700 CAIRNS (07) 4252 9400
 veris.com.au
 ACN 615 735 727
 Veris Australia Pty Ltd

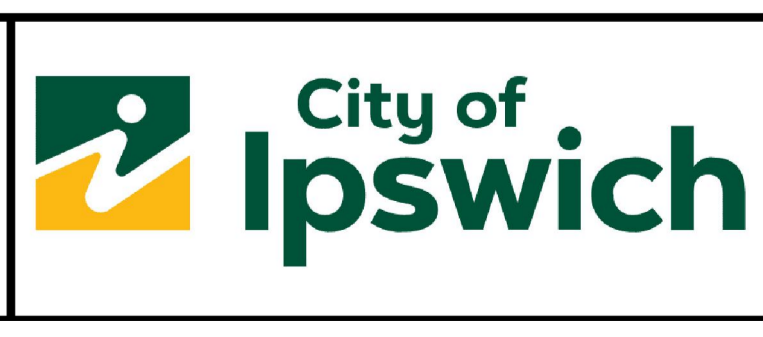

IPSWICH CITY COUNCIL

BRENTWOOD STAGE 8 & 10
 AS CONSTRUCTED
 ELECTRICAL

SCALE	1:250 @A1
SHEET	6 OF 7 SHEETS
DRAWING NO.	400891-AEL 8-10