

REGISTERED SURVEYOR'S CERTIFICATION

I, **VERIS AUSTRALIA PTY LTD**, hereby certify that the vertical and horizontal locations and dimensions shown on this plan are a true and correct record and were located by survey:

*Alexander Byrom*  
 Reg. Surveyor Delegate Reg. Surveyor No: 6448 Date: 07/11/2022


**LEGEND**

49-0 — AS CONSTRUCTED CONTOURS (Interval 0.25m)

— RETAINING WALL

COORDINATE DATUM NOTE:  
 HORIZONTAL COORDINATES (E,N) SUPPLIED ARE MAPPING GRID OF AUSTRALIA (MGA), ZONE 56 BASED ON THE UNIVERSAL TRANSVERSE MERCATOR PROJECTION AND THE GEOCENTRIC DATUM OF AUSTRALIA 2020.

AS CONSTRUCTED

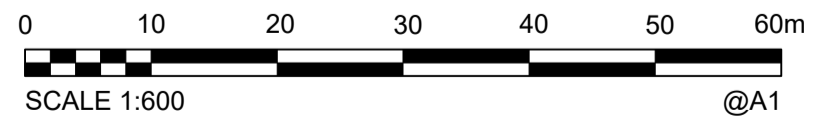

<b>A1</b>									
	A	01/11/2022	FINAL SURFACE PLOT	JMc					
INDEX	DATE	REVISIONS	DRAWN	CHECKED	PASSED	INITIALS	DATE		

DRAWN	JMc	01/11/2022
CHECKED	JH	07/11/2022
PASSED		

**veris**


BRISBANE (07) 3666 4700 WHITSUNDAYS (07) 4945 9600  
 MACKAY (07) 4611 9700 CAIRNS (07) 4522 3400  
 veris.com.au  
 ACN 615 735 727  
 Veris Australia Pty Ltd



IPSWICH CITY COUNCIL

BRENTWOOD STAGE 13  
 AS CONSTRUCTED  
 FINAL SURFACE LEVELS

SCALE	1:600 @A1
SHEET	1 OF 3 SHEETS
DRAWING NO.	400891-AFSL

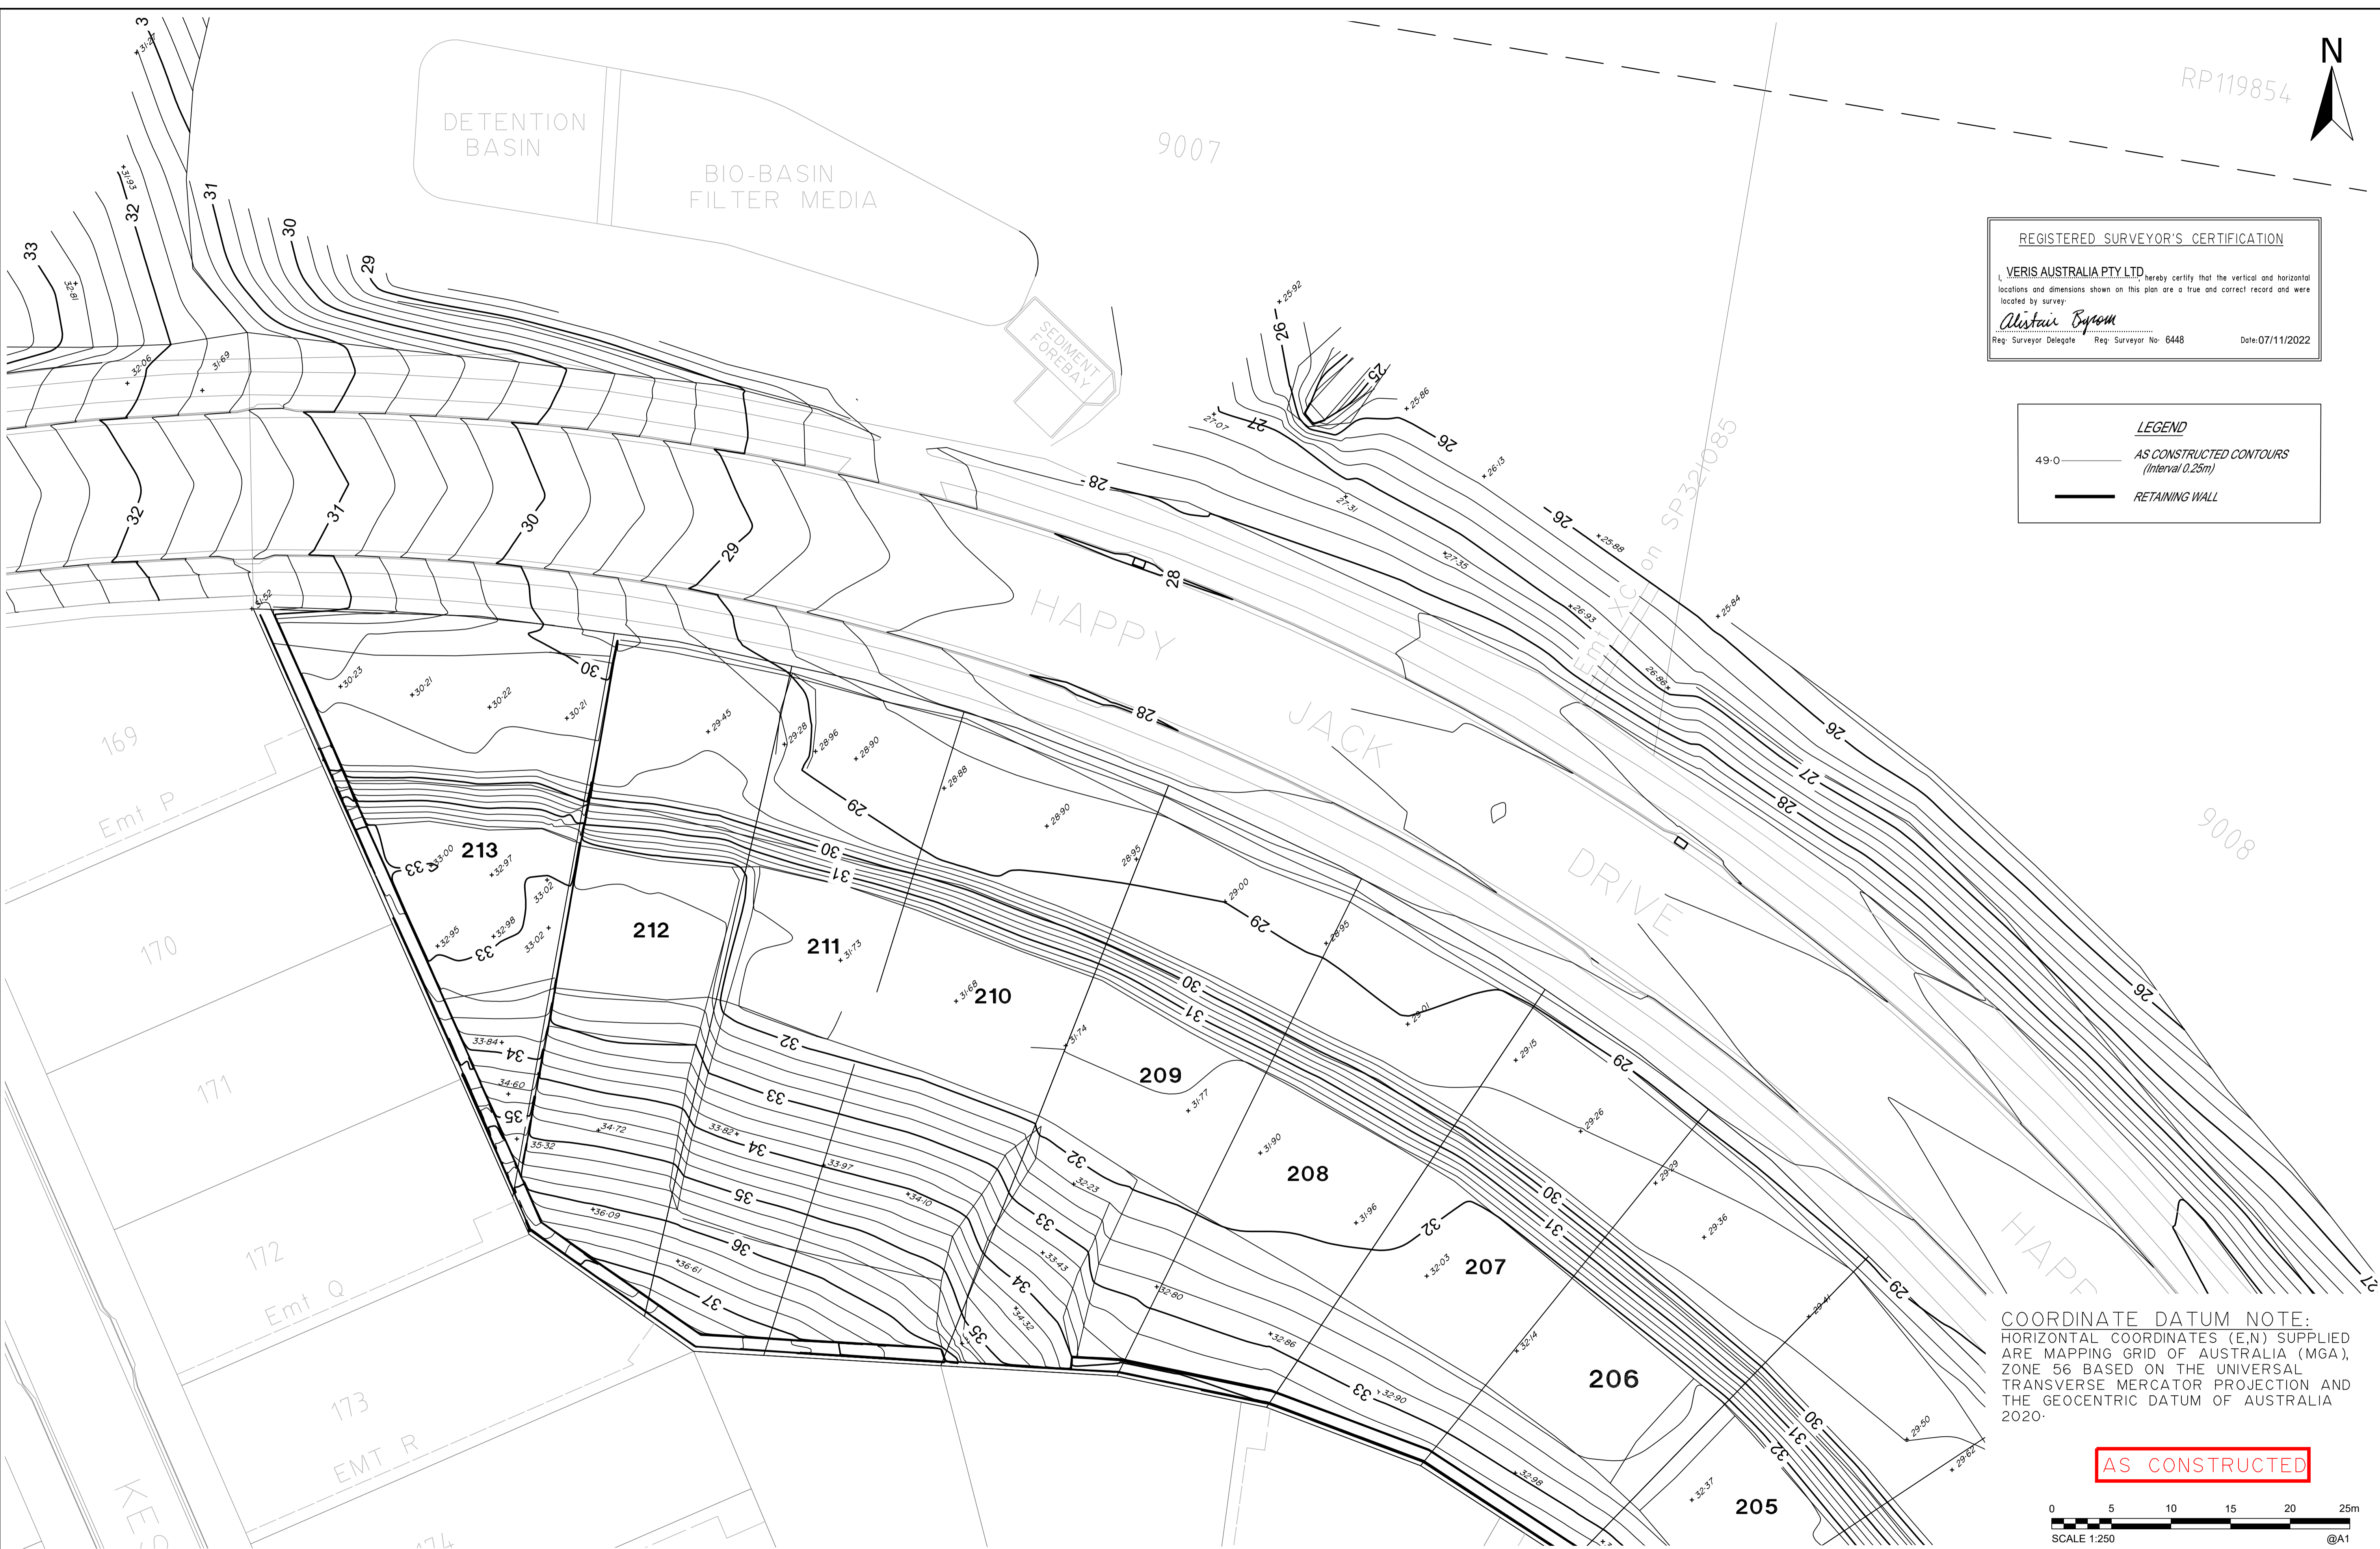

RP119854

REGISTERED SURVEYOR'S CERTIFICATION

VERIS AUSTRALIA PTY LTD, hereby certify that the vertical and horizontal locations and dimensions shown on this plan are a true and correct record and were located by survey.

*Alistair Byrom*  
 Reg. Surveyor Delegate Reg. Surveyor No: 6448 Date: 07/11/2022


LEGEND

49.0 — AS CONSTRUCTED CONTOURS (Interval 0.25m)

— RETAINING WALL

COORDINATE DATUM NOTE:  
 HORIZONTAL COORDINATES (E,N) SUPPLIED ARE MAPPING GRID OF AUSTRALIA (MGA), ZONE 56 BASED ON THE UNIVERSAL TRANSVERSE MERCATOR PROJECTION AND THE GEOCENTRIC DATUM OF AUSTRALIA 2020.

AS CONSTRUCTED

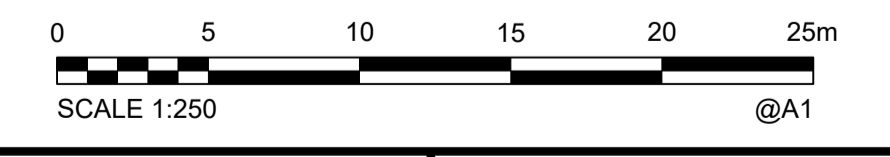

A1	INDEX	DATE	REVISIONS	DRAWN	CHECKED	PASSED
	A	01/11/2022	FINAL SURFACE PLOT	JMC		

DRAWN	JMC	01/11/2022
CHECKED	JH	07/11/2022
PASSED		
INITIALS		DATE

**veris**



BRISBANE (07) 3666 4700 WHITSUNDAYS (07) 4945 6600  
 MACKAY (07) 4661 9700 CAIRNS (07) 4102 3400  
 veris.com.au  
 ACN 615 735 727  
 Veris Australia Pty Ltd



IPSWICH CITY COUNCIL

BRENTWOOD STAGE 13  
 AS CONSTRUCTED  
 FINAL SURFACE LEVELS

SCALE	1:250 @A1
SHEET	2 OF 3 SHEETS
DRAWING NO.	400891-AFSL

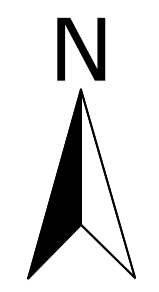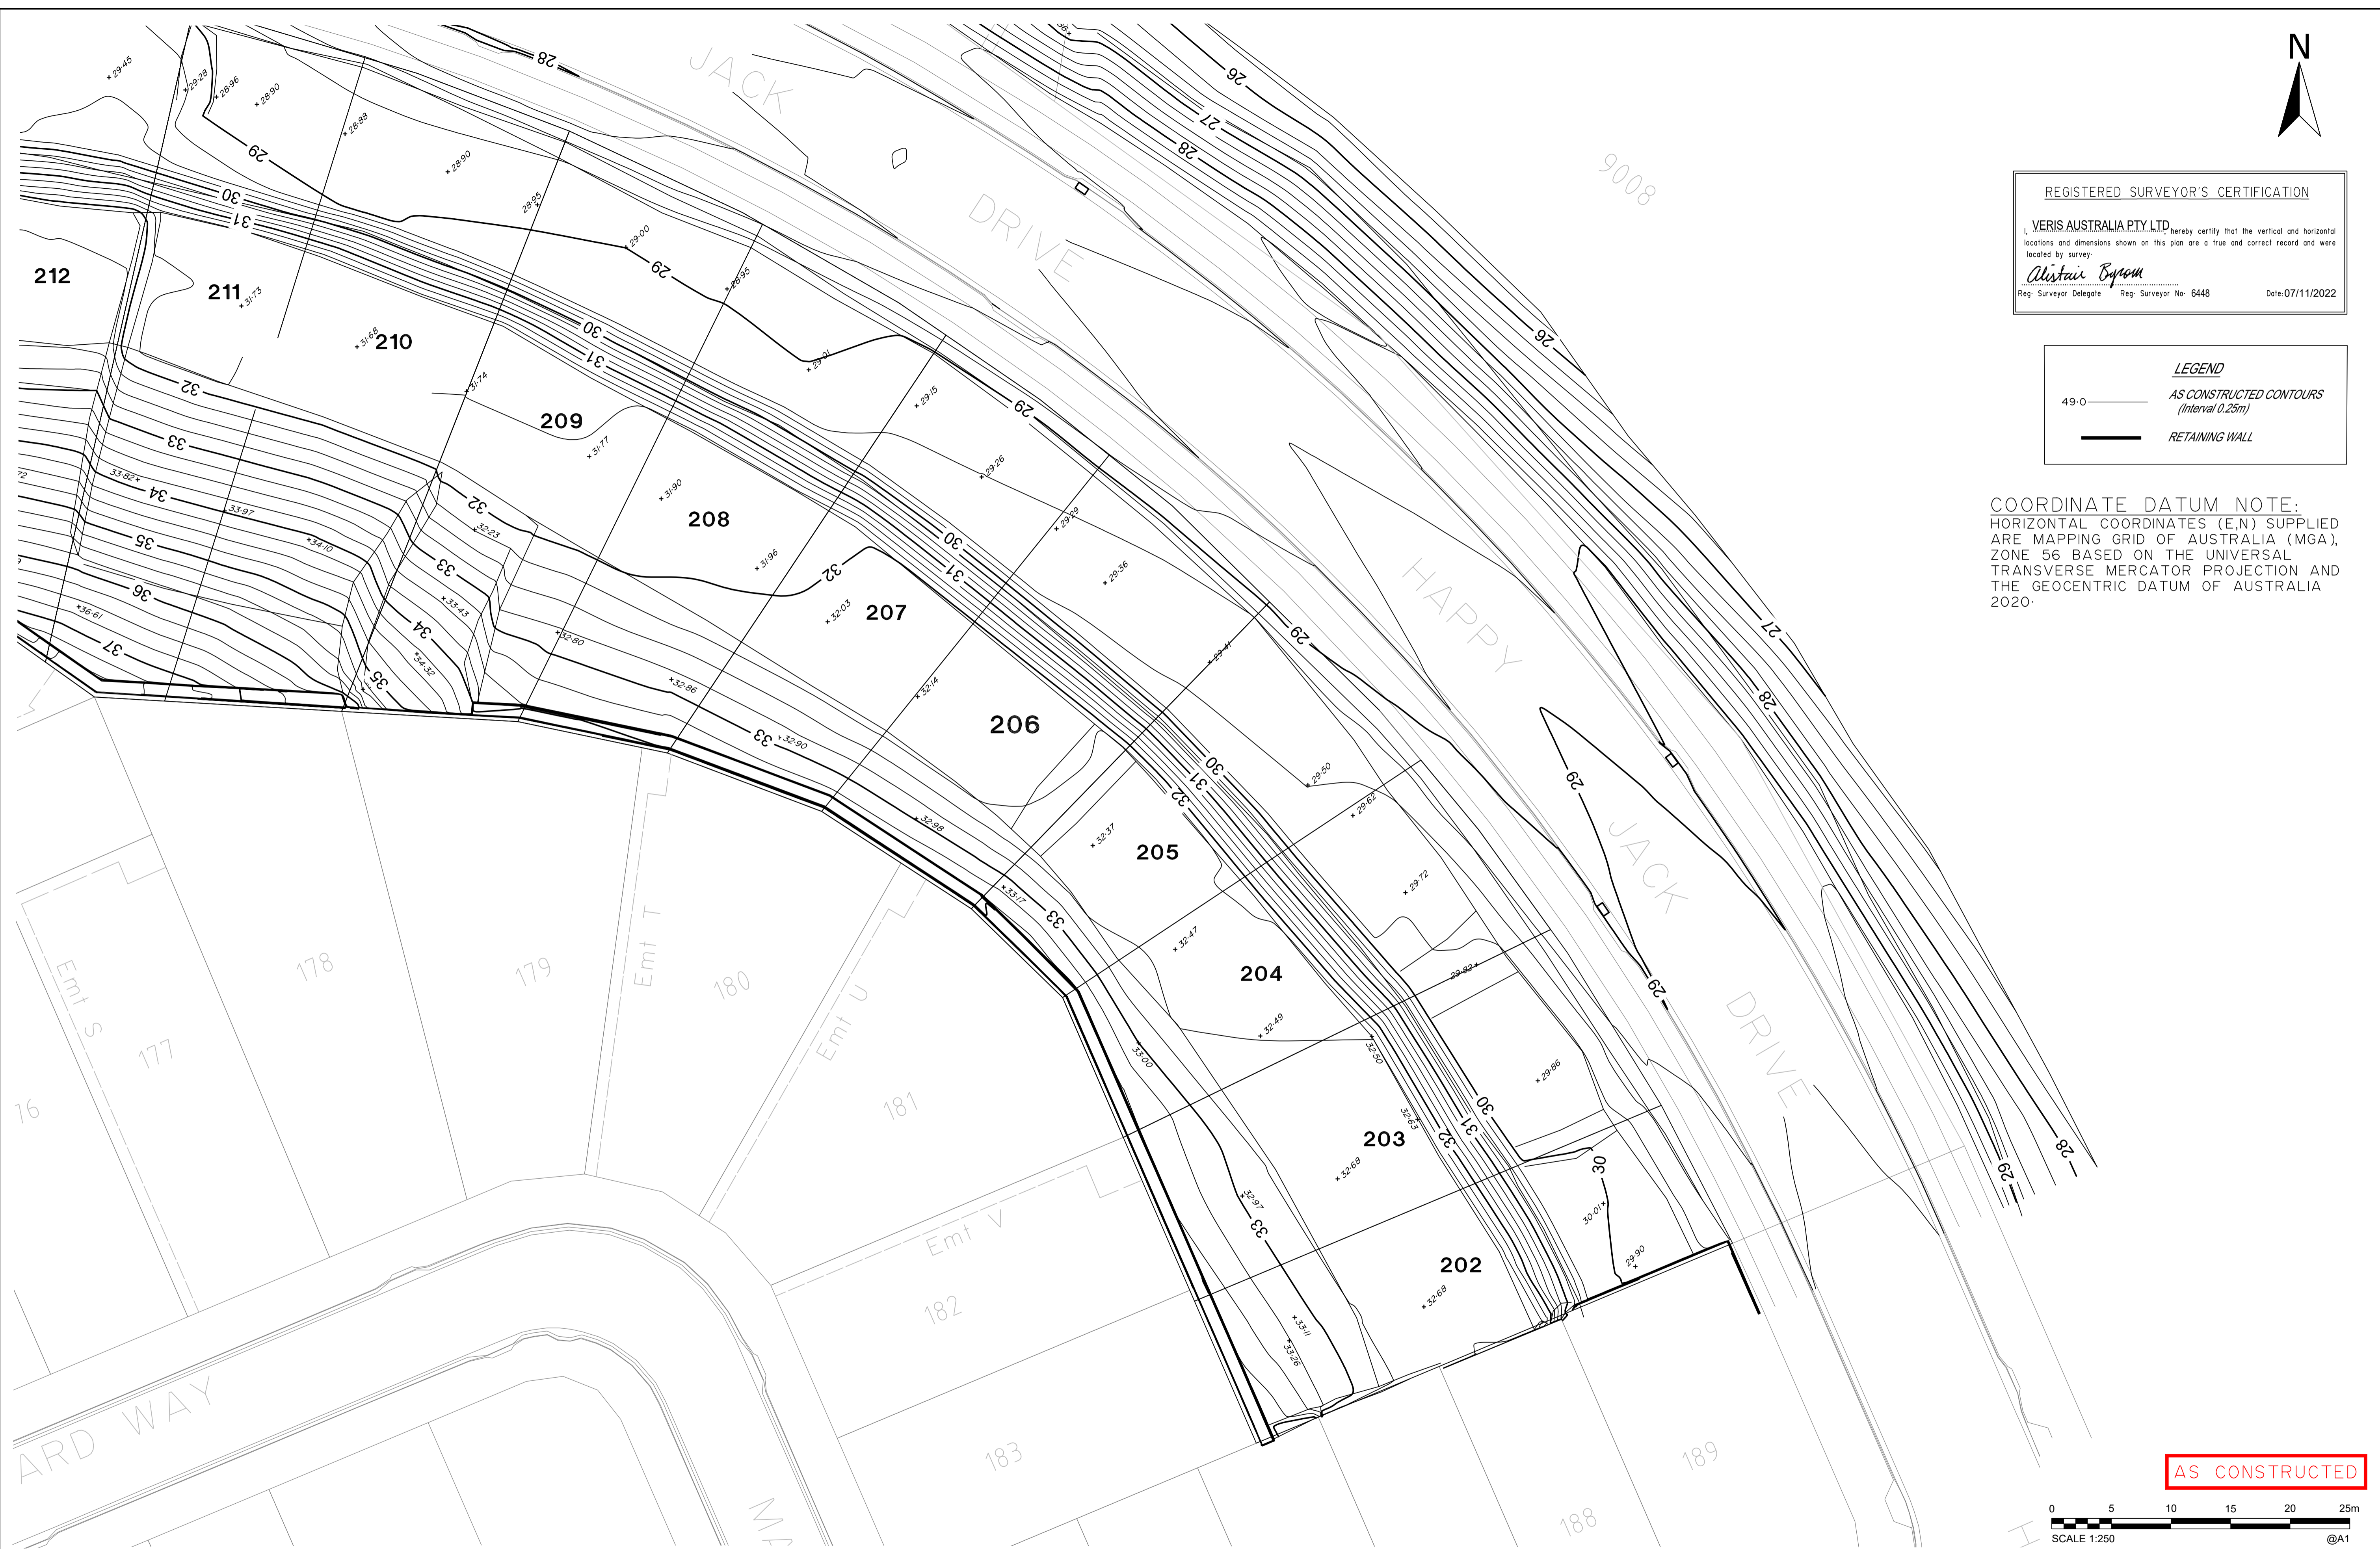


**REGISTERED SURVEYOR'S CERTIFICATION**  
 VERIS AUSTRALIA PTY. LTD. hereby certify that the vertical and horizontal locations and dimensions shown on this plan are a true and correct record and were located by survey.  
*Alastair Byrom*  
 Reg. Surveyor Delegate Reg. Surveyor No. 6448 Date: 07/11/2022

**LEGEND**  
 49.0 — AS CONSTRUCTED CONTOURS (Interval 0.25m)  
 — RETAINING WALL

**COORDINATE DATUM NOTE:**  
 HORIZONTAL COORDINATES (E,N) SUPPLIED ARE MAPPING GRID OF AUSTRALIA (MGA), ZONE 56 BASED ON THE UNIVERSAL TRANSVERSE MERCATOR PROJECTION AND THE GEOCENTRIC DATUM OF AUSTRALIA 2020.

**AS CONSTRUCTED**

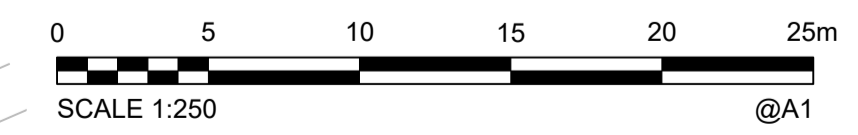

<b>A1</b>					
	A	01/11/2022	FINAL SURFACE PLOT	JMc	
INDEX	DATE	REVISIONS	DRAWN	CHECKED	PASSED

DRAWN	JMc	01/11/2022
CHECKED	JH	07/11/2022
PASSED		
INITIALS		DATE

**veris**  
 BRISBANE (07) 3664 4700 WHITSUNDAYS (07) 4945 6600  
 MACKAY (07) 4611 9700 CAIRNS (07) 4322 3400  
 veris.com.au  
 ACN 615 735 727  
 Veris Australia Pty Ltd



**IPSWICH CITY COUNCIL**

BRENTWOOD STAGE 13  
 AS CONSTRUCTED  
 FINAL SURFACE LEVELS

SCALE	1:250 @A1
SHEET	3 OF 3 SHEETS
DRAWING NO-	400891-AFSL