


LEGEND

- SEWER MAIN
- SEWER HOUSE CONNECTION
- SEWER HOUSE CONNECTION
- SEWER MAINTENANCE HOLE (INSITU)
- SEWER MAINTENANCE SHAFT
- SEWER END OF LINE
- EXISTING SEWER MAINTENANCE SHAFT
- DESIGN LEVEL 58.19#

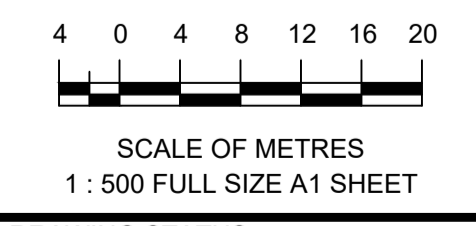


REGISTERED SURVEYOR'S CERTIFICATION  
I, Veris Australia Pty Ltd, hereby certify that the vertical and horizontal locations and dimensions shown on this plan are a true and correct record and were located by survey.  
*Christina Byrom* 6448 22/10/2021  
Registered Surveyor (sig.) Reg. Surveyor No. Date  
(Delegate)

A1	F	19/10/2021	FINAL	MJT/GJF					
	E	07/09/2021	PROGRESS PLOT	JMc					
	D	24/08/2021	SHEET 8 REMOVED	JMc					
	C	16/08/2021	PROGRESS PLOT	JMc					
	B	19/17/2021	PROGRESS PLOT	JMc					
	REV NO	DATE	REVISION PURPOSE / DESCRIPTION	DRAWN	RPEQ	RPEQ No	INITIALS	DATE	



BRENTWOOD FOREST  
7000 Jones Road, Bellbird Park  
AS CONSTRUCTED SEWER STAGE 8  
SEWER

DRAWING STATUS  
**AS CONSTRUCTED**  
SHEET 1 OF 7 SHEETS  
DRAWING NO. 400891-AS08F  
REV. F

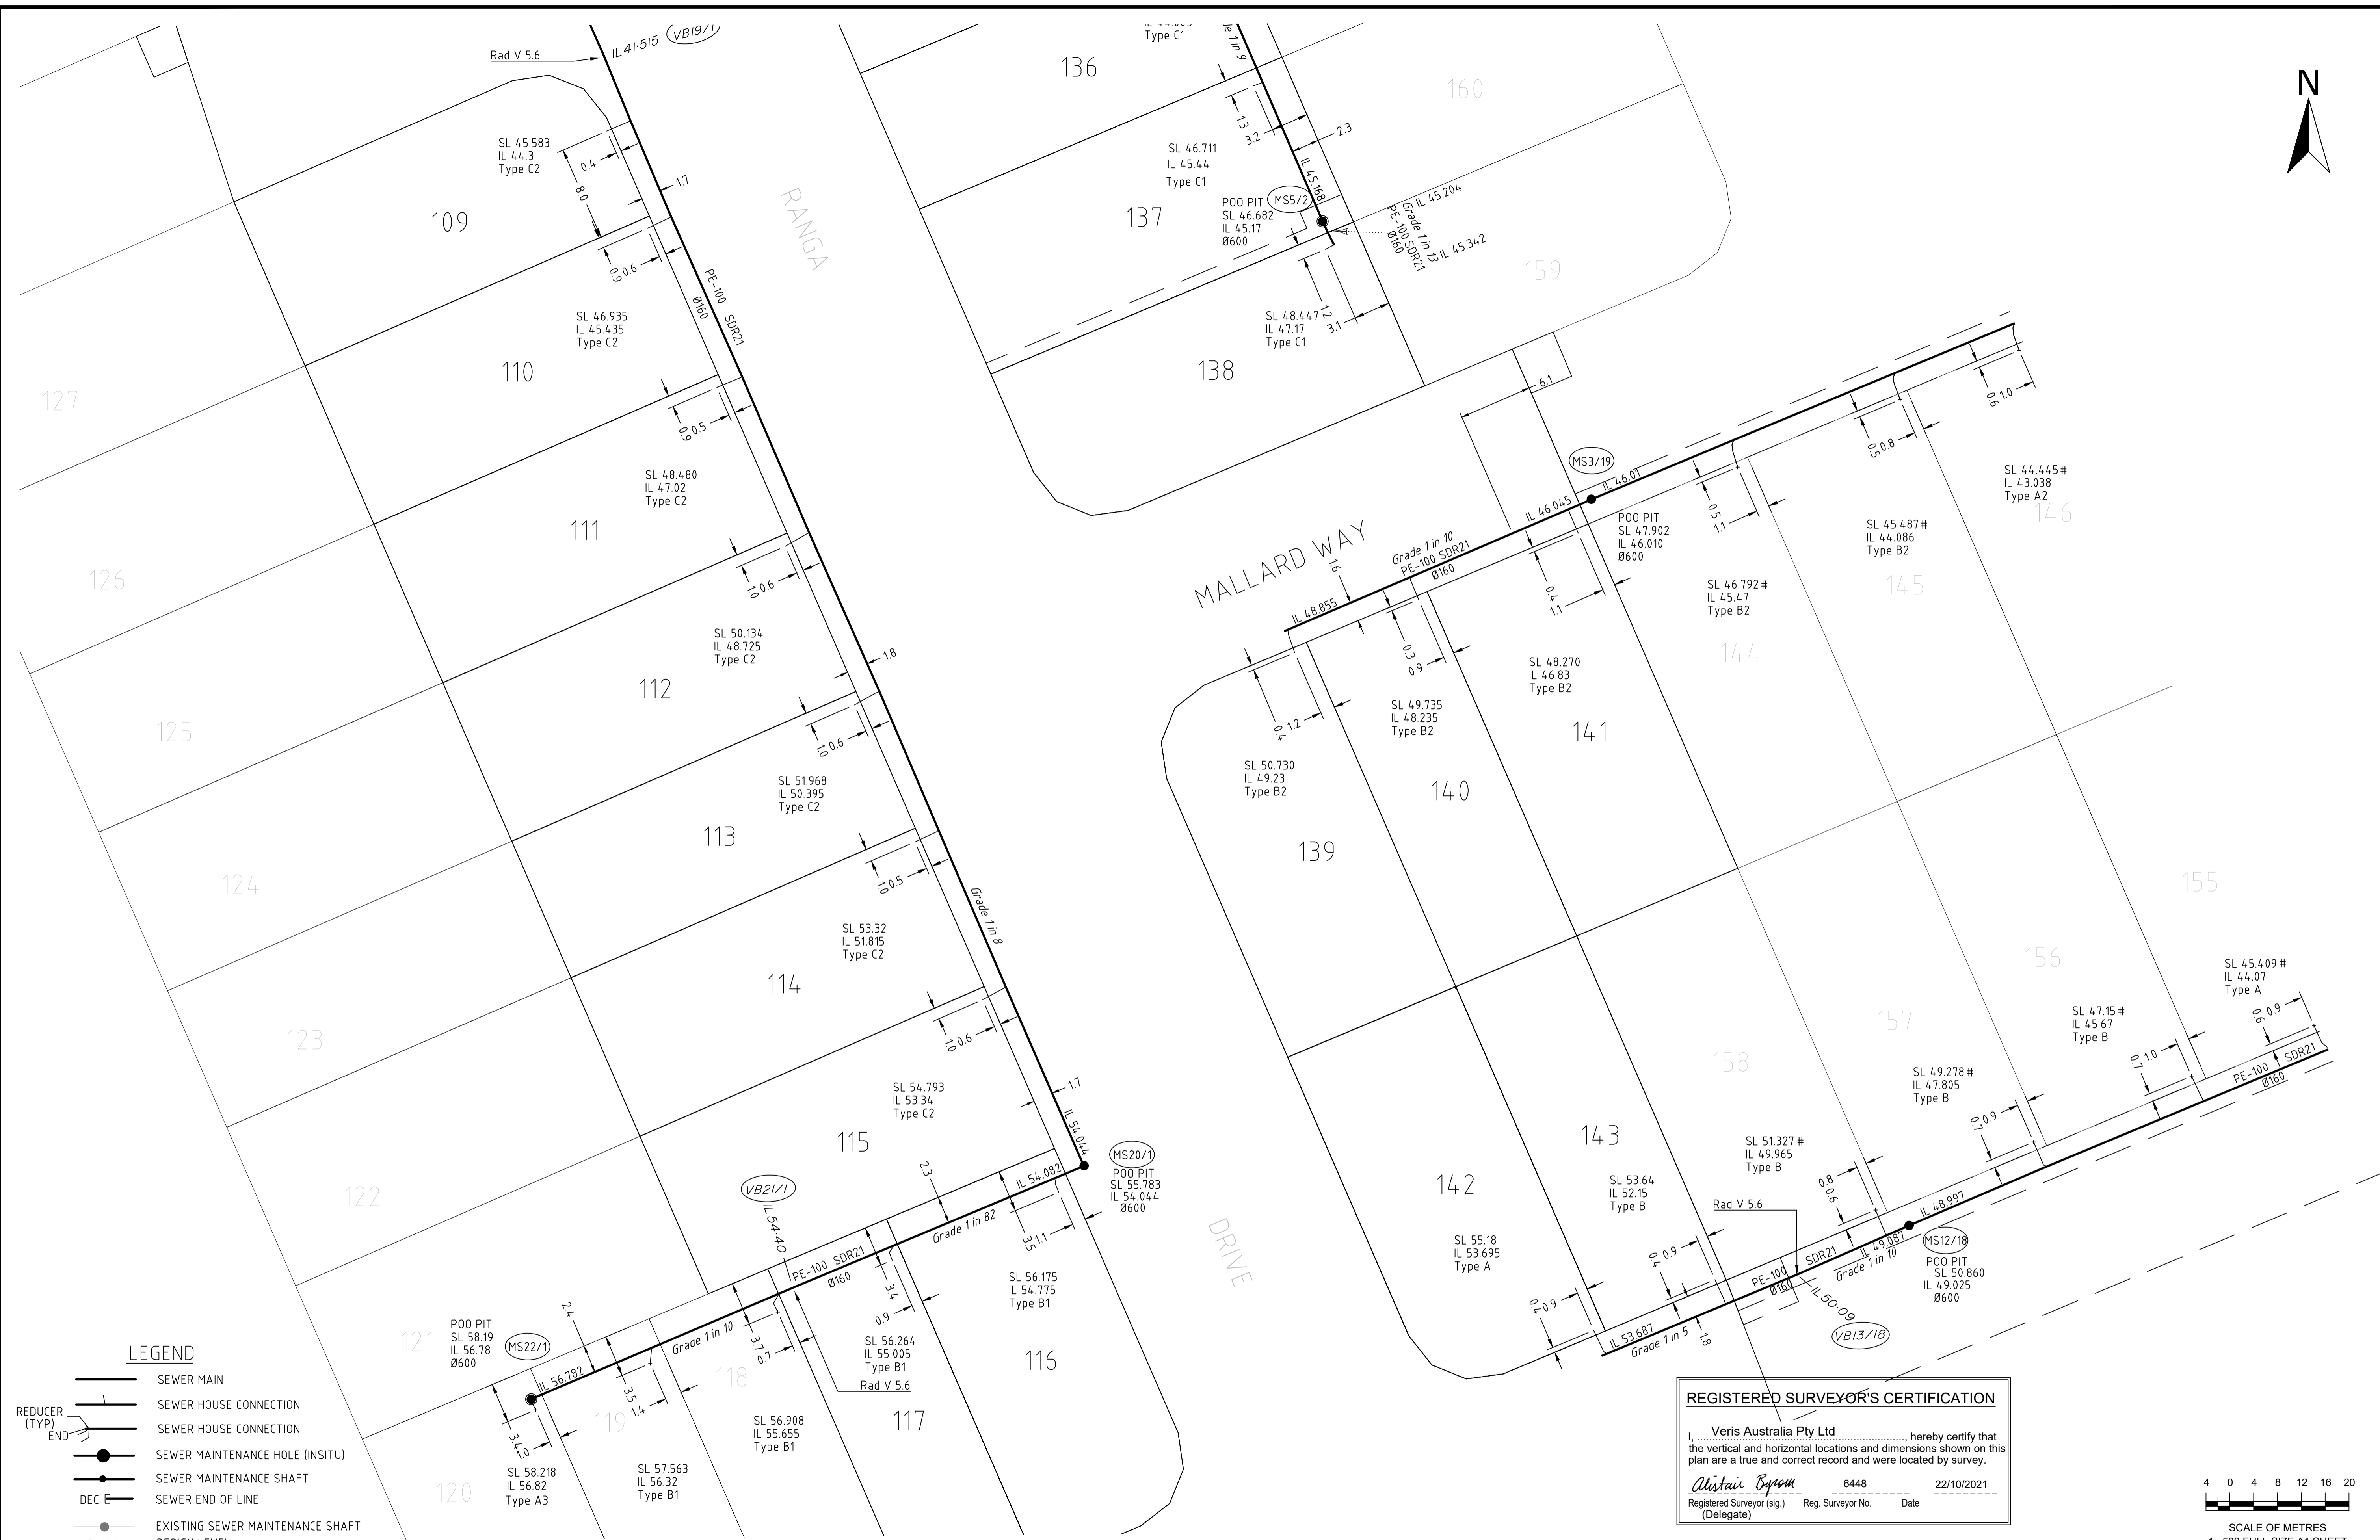


**LEGEND**

- SEWER MAIN
- SEWER HOUSE CONNECTION
- SEWER HOUSE CONNECTION
- SEWER MAINTENANCE HOLE (INSITU)
- SEWER MAINTENANCE SHAFT
- SEWER END OF LINE
- EXISTING SEWER MAINTENANCE SHAFT
- DESIGN LEVEL

**REGISTERED SURVEYOR'S CERTIFICATION**

I, Veris Australia Pty Ltd, hereby certify that the vertical and horizontal locations and dimensions shown on this plan are a true and correct record and were located by survey.

*Alister Byrom* 6448 22/10/2021  
 Registered Surveyor (sig.) Reg. Surveyor No. Date  
 (Delegate)

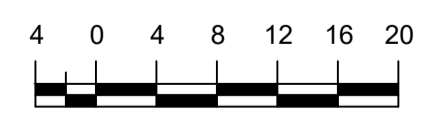

SCALE OF METRES  
 1 : 500 FULL SIZE A1 SHEET

<b>A1</b>	F	19/10/2021	FINAL	MJT/GF			
	E	07/09/2021	PROGRESS PLOT	JMc			
	D	24/08/2021	SHEET 8 REMOVED	JMc	DRAWN	JMc	23/06/2021
	C	16/08/2021	PROGRESS PLOT	JMc	CHECKED		
	B	19/07/2021	PROGRESS PLOT	JMc	APPROVED		
REV NO	DATE	REVISION PURPOSE / DESCRIPTION	DRAWN	RPEQ	RPEQ No	INITIALS	DATE

**veris** BRISBANE (07) 3066 4700 WHITSUNDAYS (07) 4943 6000  
 MACKAY (07) 4957 9700 CAIRNS (07) 4252 9400  
 veris.com.au  
 ACN 615 730 727  
 Veris Australia Pty Ltd



**BRENTWOOD FOREST**  
 7000 Jones Road, Bellbird Park  
**AS CONSTRUCTED SEWER STAGE 8**  
**SEWER**

DRAWING STATUS <b>AS CONSTRUCTED</b>	
SHEET 2 OF 7 SHEETS	
DRAWING NO. <b>400891-AS08F</b>	REV. <b>E</b>



**REGISTERED SURVEYOR'S CERTIFICATION**  
 I, **Veris Australia Pty Ltd**, hereby certify that the vertical and horizontal locations and dimensions shown on this plan are a true and correct record and were located by survey.  
*Alistair Byrom* 6448 22/10/2021  
 Registered Surveyor (Sig.) Reg. Surveyor No. Date  
 (Delegate)

**LEGEND**

- SEWER MAIN
- SEWER HOUSE CONNECTION
- SEWER MAINTENANCE HOLE (INSITU)
- SEWER MAINTENANCE SHAFT
- SEWER END OF LINE
- EXISTING SEWER MAINTENANCE SHAFT
- DESIGN LEVEL

4 0 4 8 12 16 20  
 SCALE OF METRES  
 1 : 500 FULL SIZE A1 SHEET


<b>A1</b>	F	19/10/2021	FINAL	MJT/GF				
	E	07/09/2021	PROGRESS PLOT	JMc				
	D	24/08/2021	SHEET 8 REMOVED	JMc		DRAWN	JMc	23/06/2021
	C	16/08/2021	PROGRESS PLOT	JMc		CHECKED		
	B	06/08/2021	PROGRESS PLOT	JMc		APPROVED		
	REV NO	DATE	REVISION PURPOSE / DESCRIPTION	DRAWN	RPEQ	RPEQ No	INITIALS	DATE

**veris**  
 BRISBANE (07) 3966 4700  
 MACKAY (07) 4957 0700  
 WHITSUNDAYS (07) 4942 0600  
 CAIRNS (07) 4252 9400  
 veris.com.au  
 ACN 615 735 727  
 Veris Australia Pty Ltd



**BRENTWOOD FOREST**  
 7000 Jones Road, Bellbird Park  
**AS CONSTRUCTED SEWER STAGE 8**  
 SEWER

DRAWING STATUS  
**AS CONSTRUCTED**  
 SHEET 3 OF 7 SHEETS  
 DRAWING NO. **400891-AS08F**  
 REV. **F**

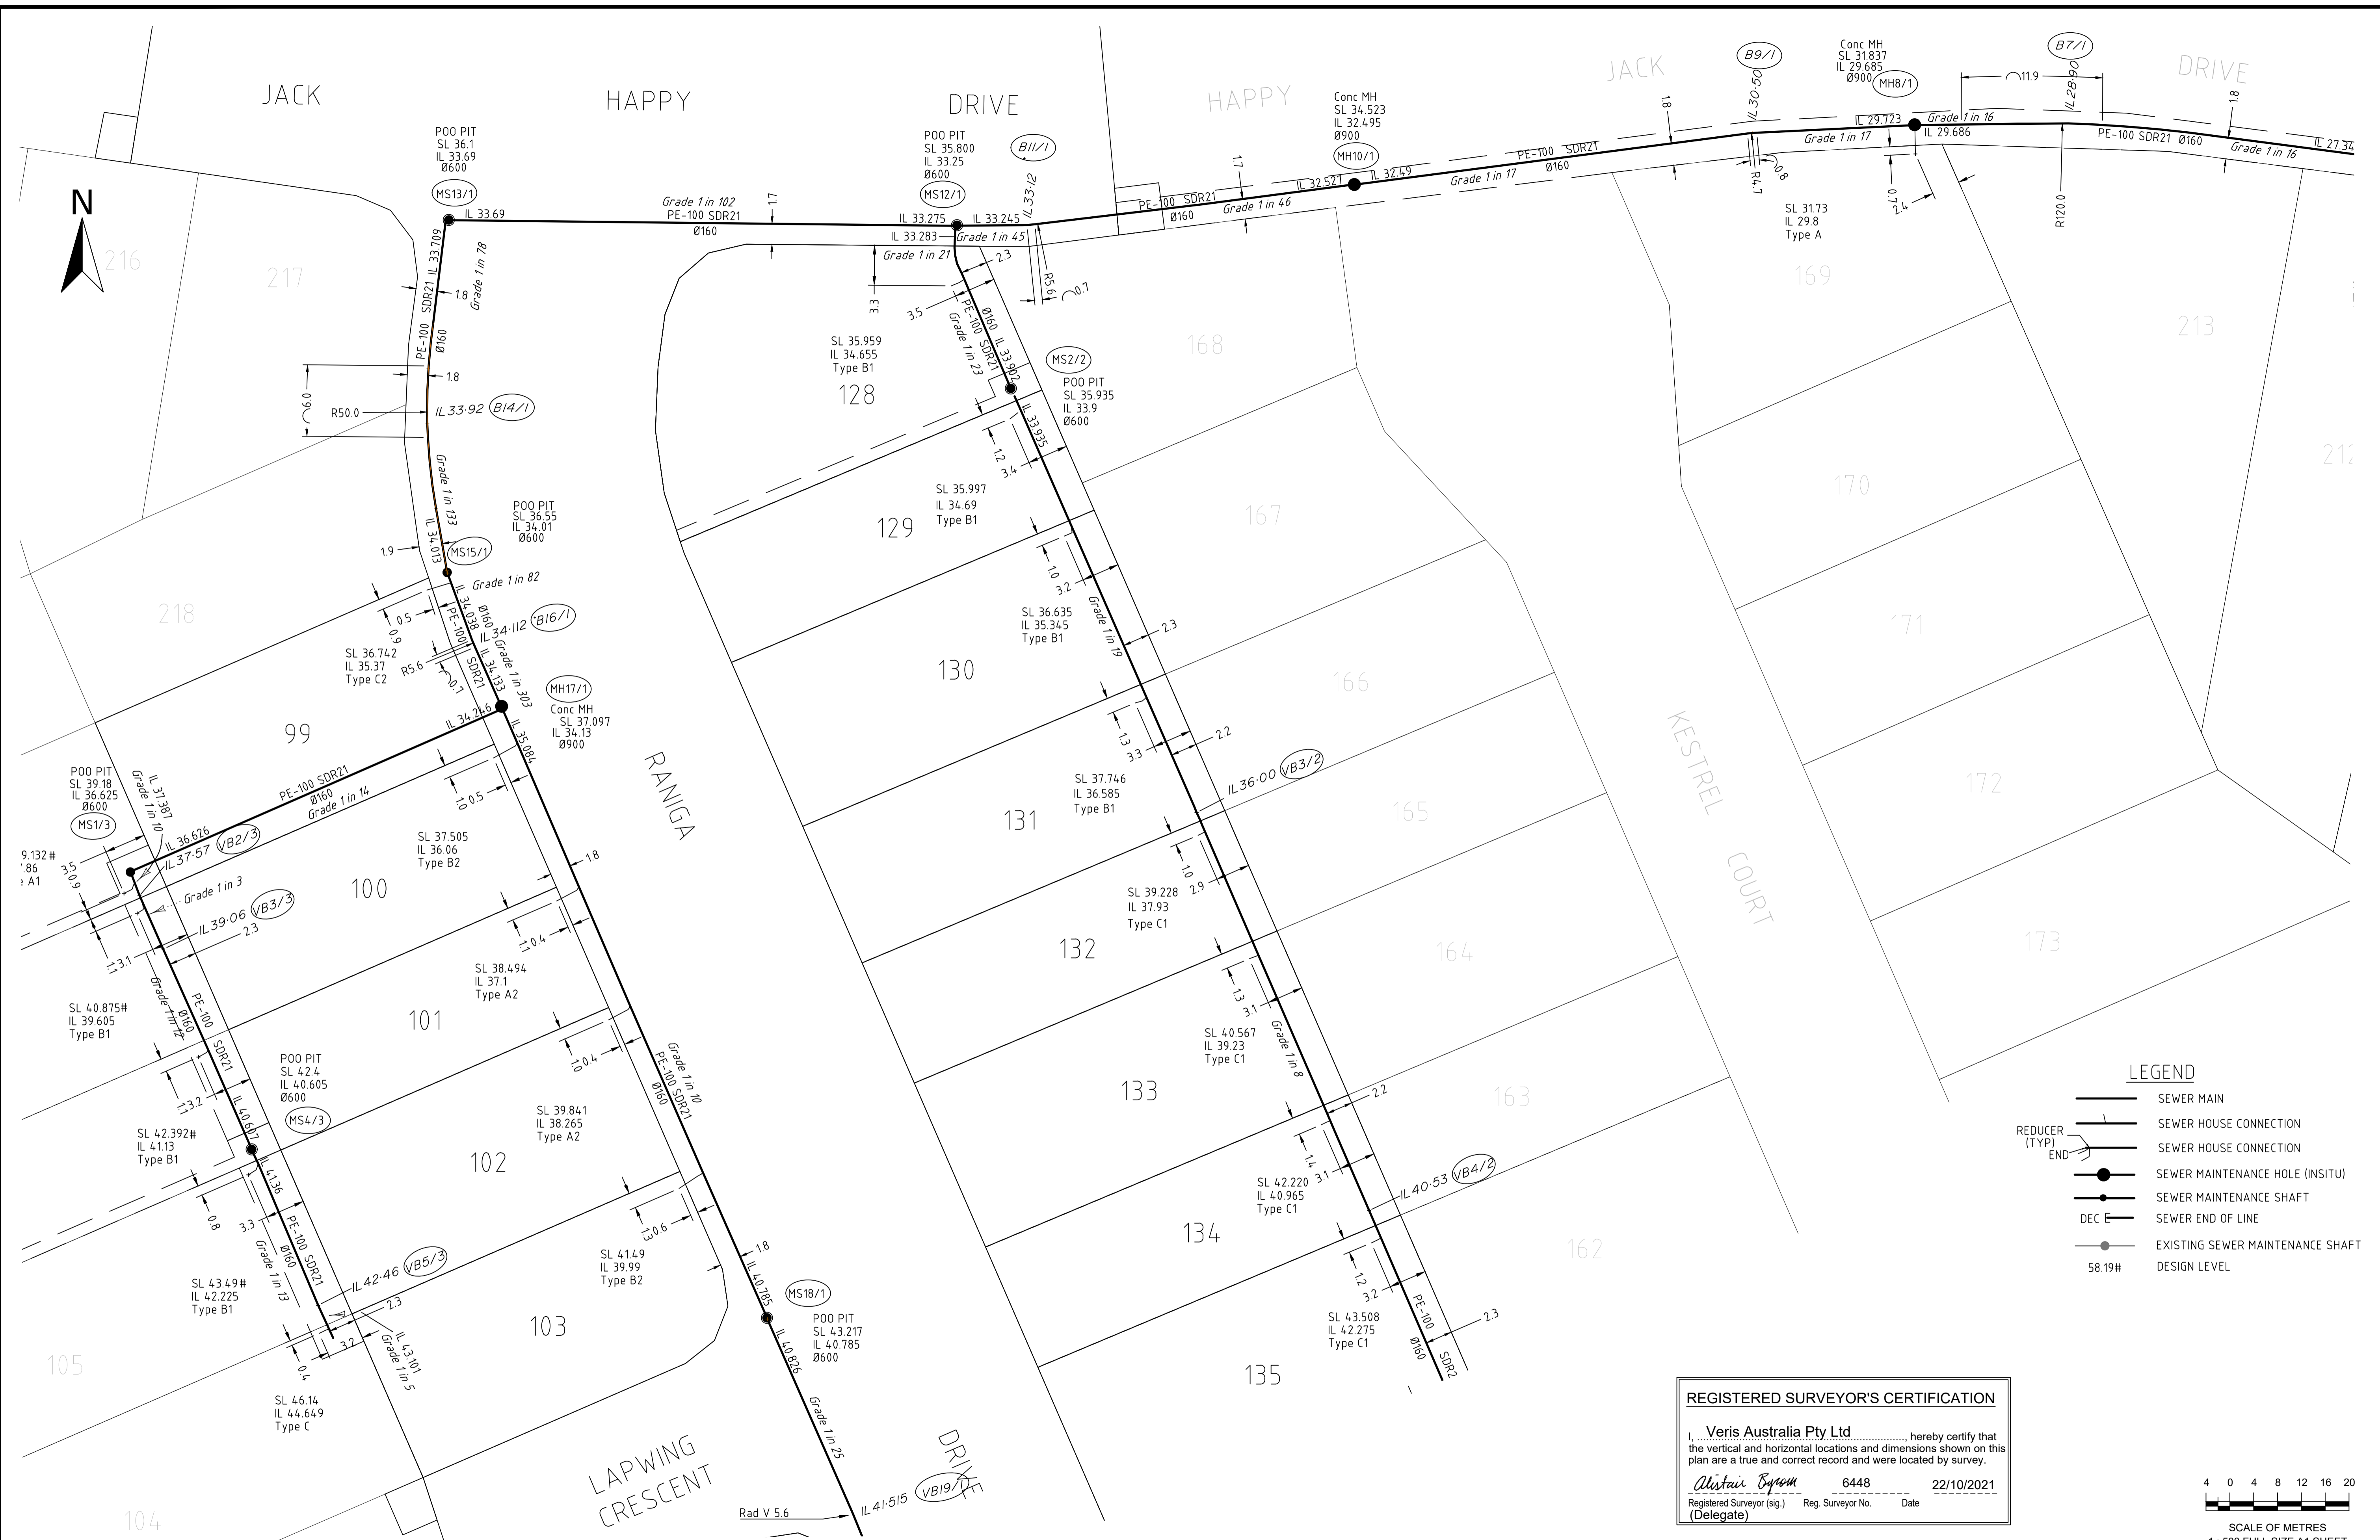

**LEGEND**

	SEWER MAIN
	SEWER HOUSE CONNECTION
	SEWER HOUSE CONNECTION
	SEWER MAINTENANCE HOLE (INSITU)
	SEWER MAINTENANCE SHAFT
	SEWER END OF LINE
	EXISTING SEWER MAINTENANCE SHAFT
	DESIGN LEVEL

**REGISTERED SURVEYOR'S CERTIFICATION**

I, Veris Australia Pty Ltd, hereby certify that the vertical and horizontal locations and dimensions shown on this plan are a true and correct record and were located by survey.

*Alister Byrom* 6448 22/10/2021  
 Registered Surveyor (sig.) Reg. Surveyor No. Date  
 (Delegate)


<b>A1</b>	F	19/10/2021	FINAL	MJT/GF			
	E	07/09/2021	PROGRESS PLOT	JMc			
	D	24/08/2021	SHEET 8 REMOVED	JMc	DRAWN	JMc	23/06/2021
	C	16/08/2021	PROGRESS PLOT	JMc	CHECKED		
	B	19/07/2021	PROGRESS PLOT	JMc	APPROVED		
REV NO	DATE	REVISION PURPOSE / DESCRIPTION		DRAWN	RPEQ	RPEQ No	INITIALS DATE

**veris** BRISBANE WHITSUNDAYS  
 (07) 3966 4700 (07) 4942 6000  
 MACKAY CAIRNS  
 (07) 4957 0700 (07) 4252 9400  
 veris.com.au  
 ACN 615 735 727  
 Veris Australia Pty Ltd




**BRENTWOOD FOREST**  
 7000 Jones Road, Bellbird Park  
**AS CONSTRUCTED SEWER STAGE 8**  
**SEWER**

<b>DRAWING STATUS</b>	
<b>AS CONSTRUCTED</b>	
SHEET 4 OF 7 SHEETS	
DRAWING NO.	REV.
400891-AS08	E

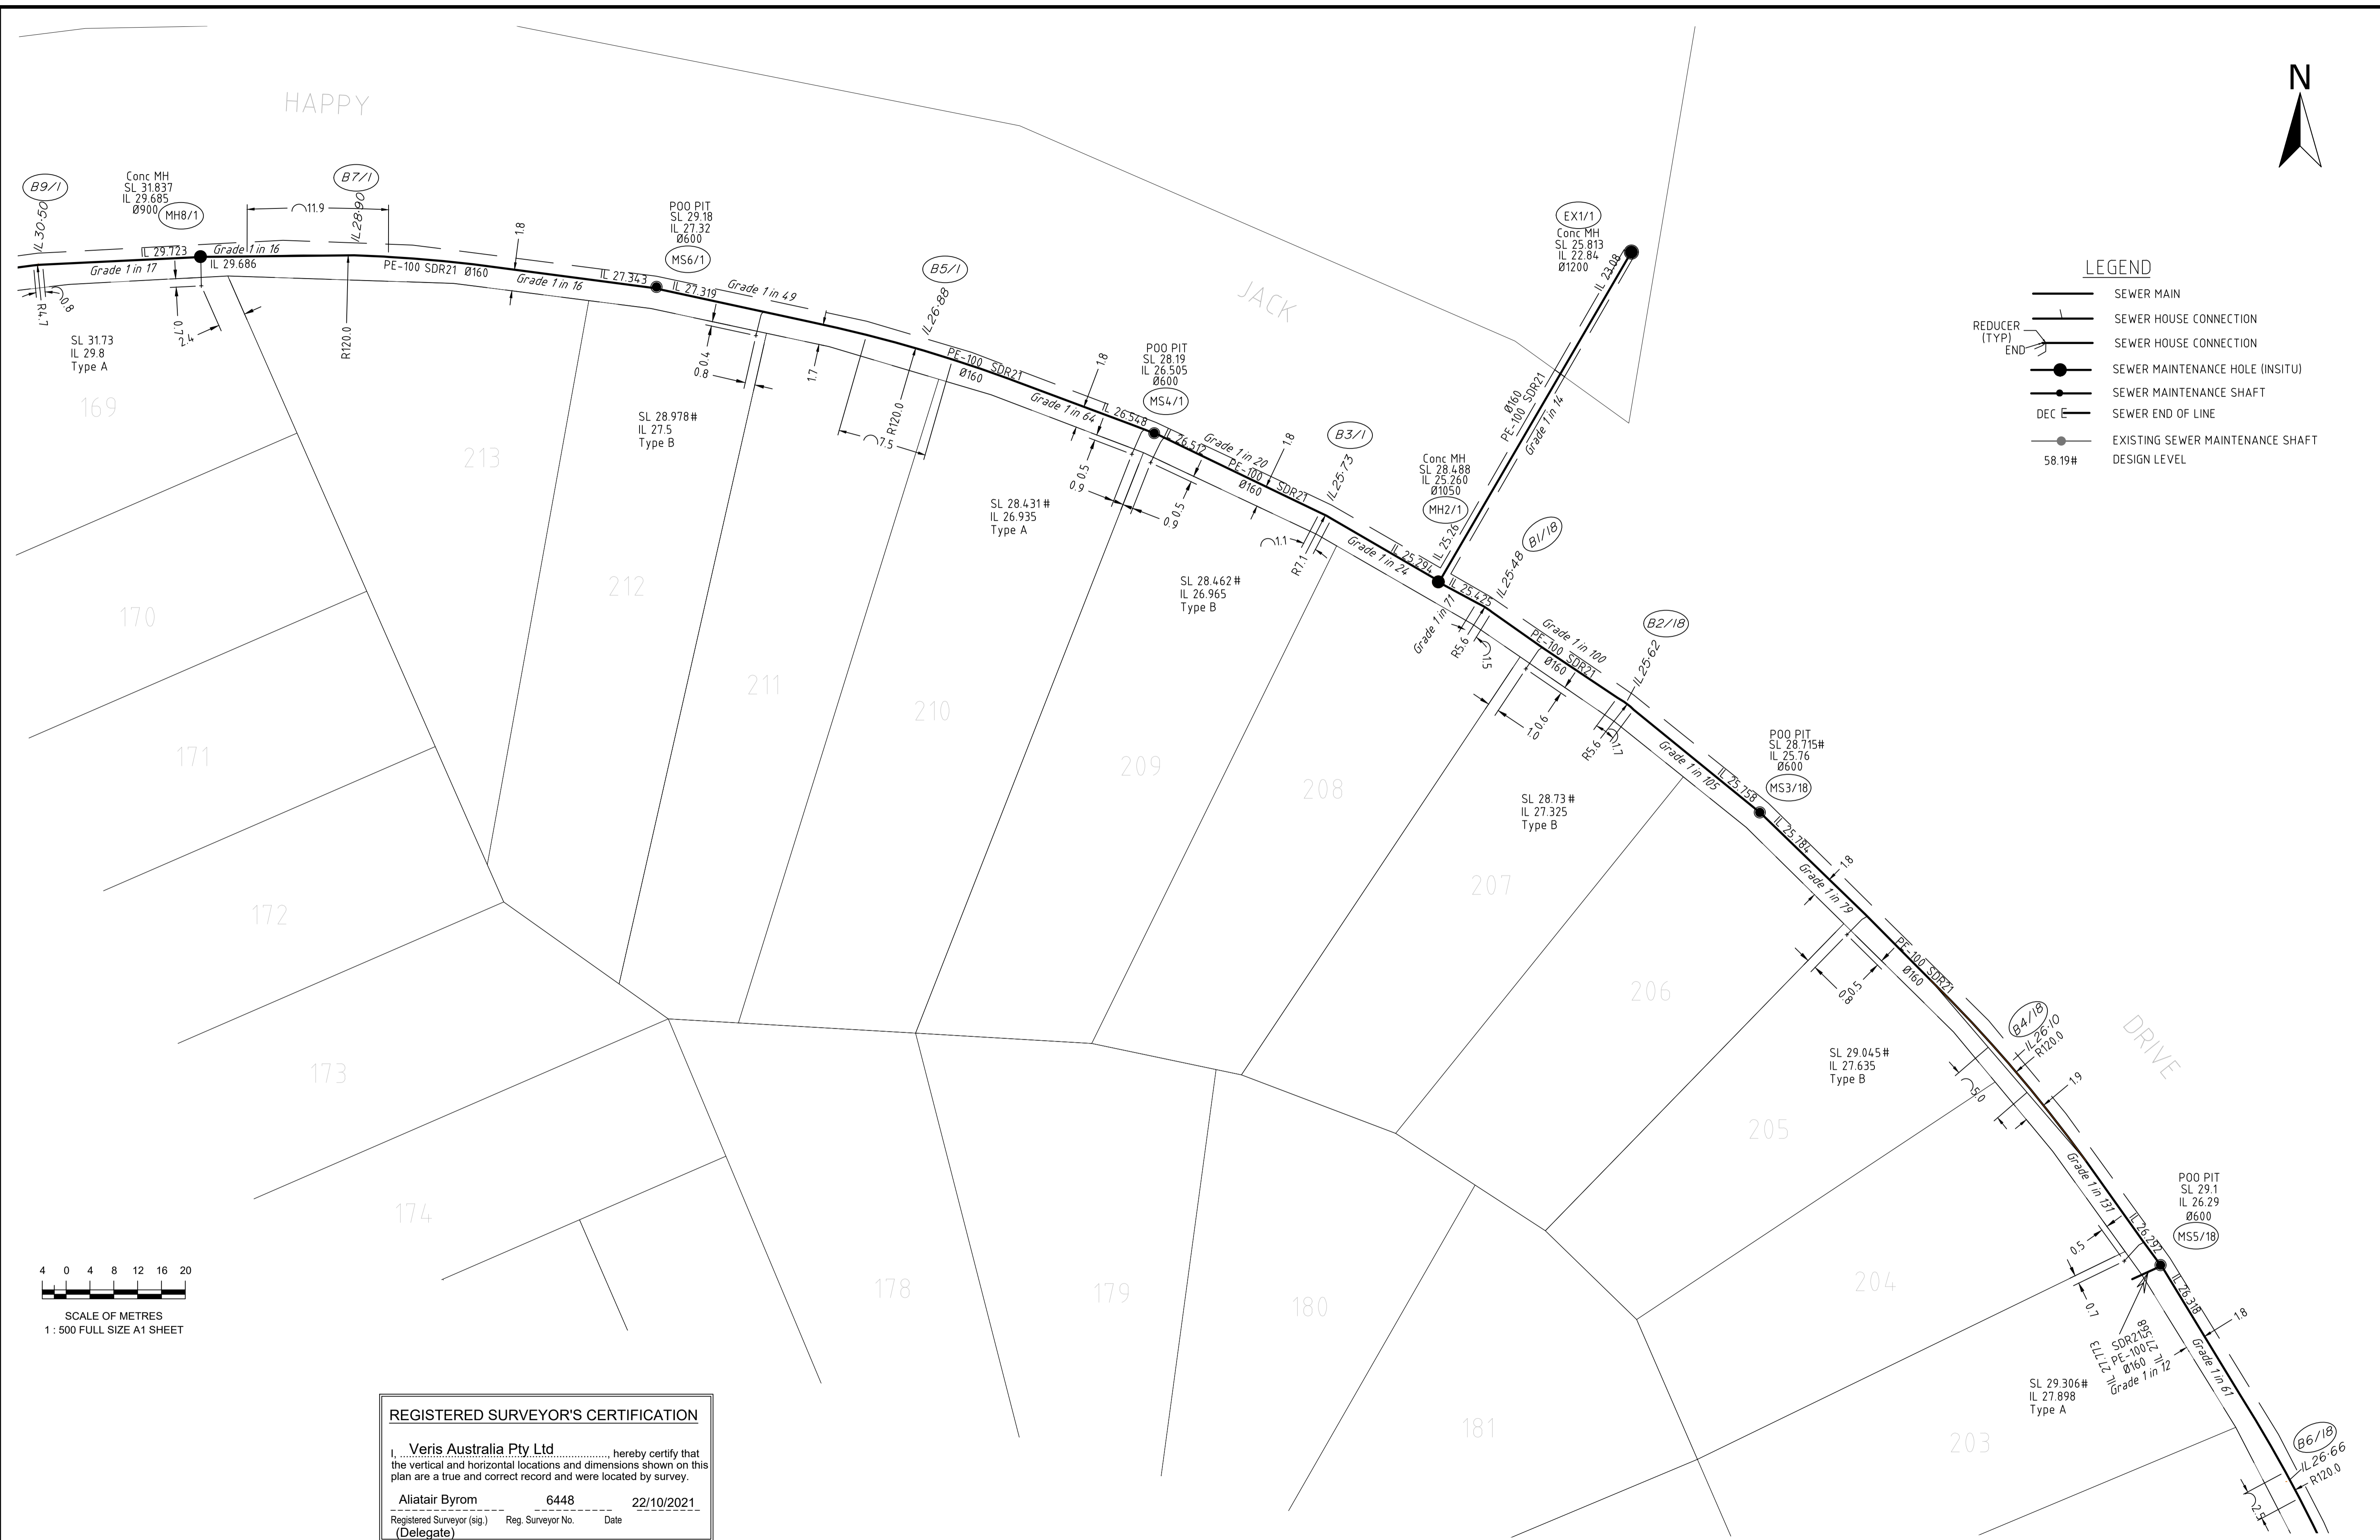

**LEGEND**

	SEWER MAIN
	SEWER HOUSE CONNECTION
	SEWER HOUSE CONNECTION
	SEWER MAINTENANCE HOLE (INSITU)
	SEWER MAINTENANCE SHAFT
	SEWER END OF LINE
	EXISTING SEWER MAINTENANCE SHAFT
	DESIGN LEVEL

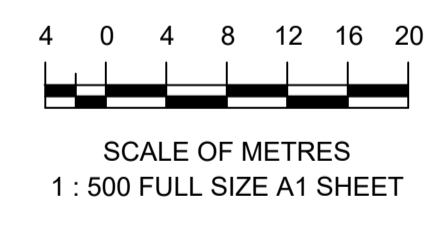

**REGISTERED SURVEYOR'S CERTIFICATION**

I, **Veris Australia Pty Ltd**, hereby certify that the vertical and horizontal locations and dimensions shown on this plan are a true and correct record and were located by survey.

**Alitair Byrom** 6448 22/10/2021  
 Registered Surveyor (sig.) Reg. Surveyor No. Date  
 (Delegate)

<b>A1</b>	F	19/10/2021	FINAL	MJT/GF			
	E	07/09/2021	PROGRESS PLOT	JMc			
	D	24/08/2021	SHEET 8 REMOVED	JMc	DRAWN	JMc	23/06/2021
	C	16/08/2021	PROGRESS PLOT	JMc	CHECKED		
	B	19/07/2021	PROGRESS PLOT	JMc	APPROVED		
	REV NO	DATE	REVISION PURPOSE / DESCRIPTION	DRAWN	RPEQ	RPEQ No	INITIALS




**BRENTWOOD FOREST**  
 7000 Jones Road, Bellbird Park  
**AS CONSTRUCTED SEWER STAGE 8**  
 SEWER

DRAWING STATUS <b>AS CONSTRUCTED</b>	
SHEET 5 OF 7 SHEETS	
DRAWING NO. <b>400891-AS08F</b>	REV. <b>F</b>



**REGISTERED SURVEYOR'S CERTIFICATION**  
 I, **Veris Australia Pty Ltd** hereby certify that the vertical and horizontal locations and dimensions shown on this plan are a true and correct record and were located by survey.  
*Alastair Byrom* 6448 22/10/2021  
 Registered Surveyor (sig.) Reg. Surveyor No. Date  
 (Delegate)

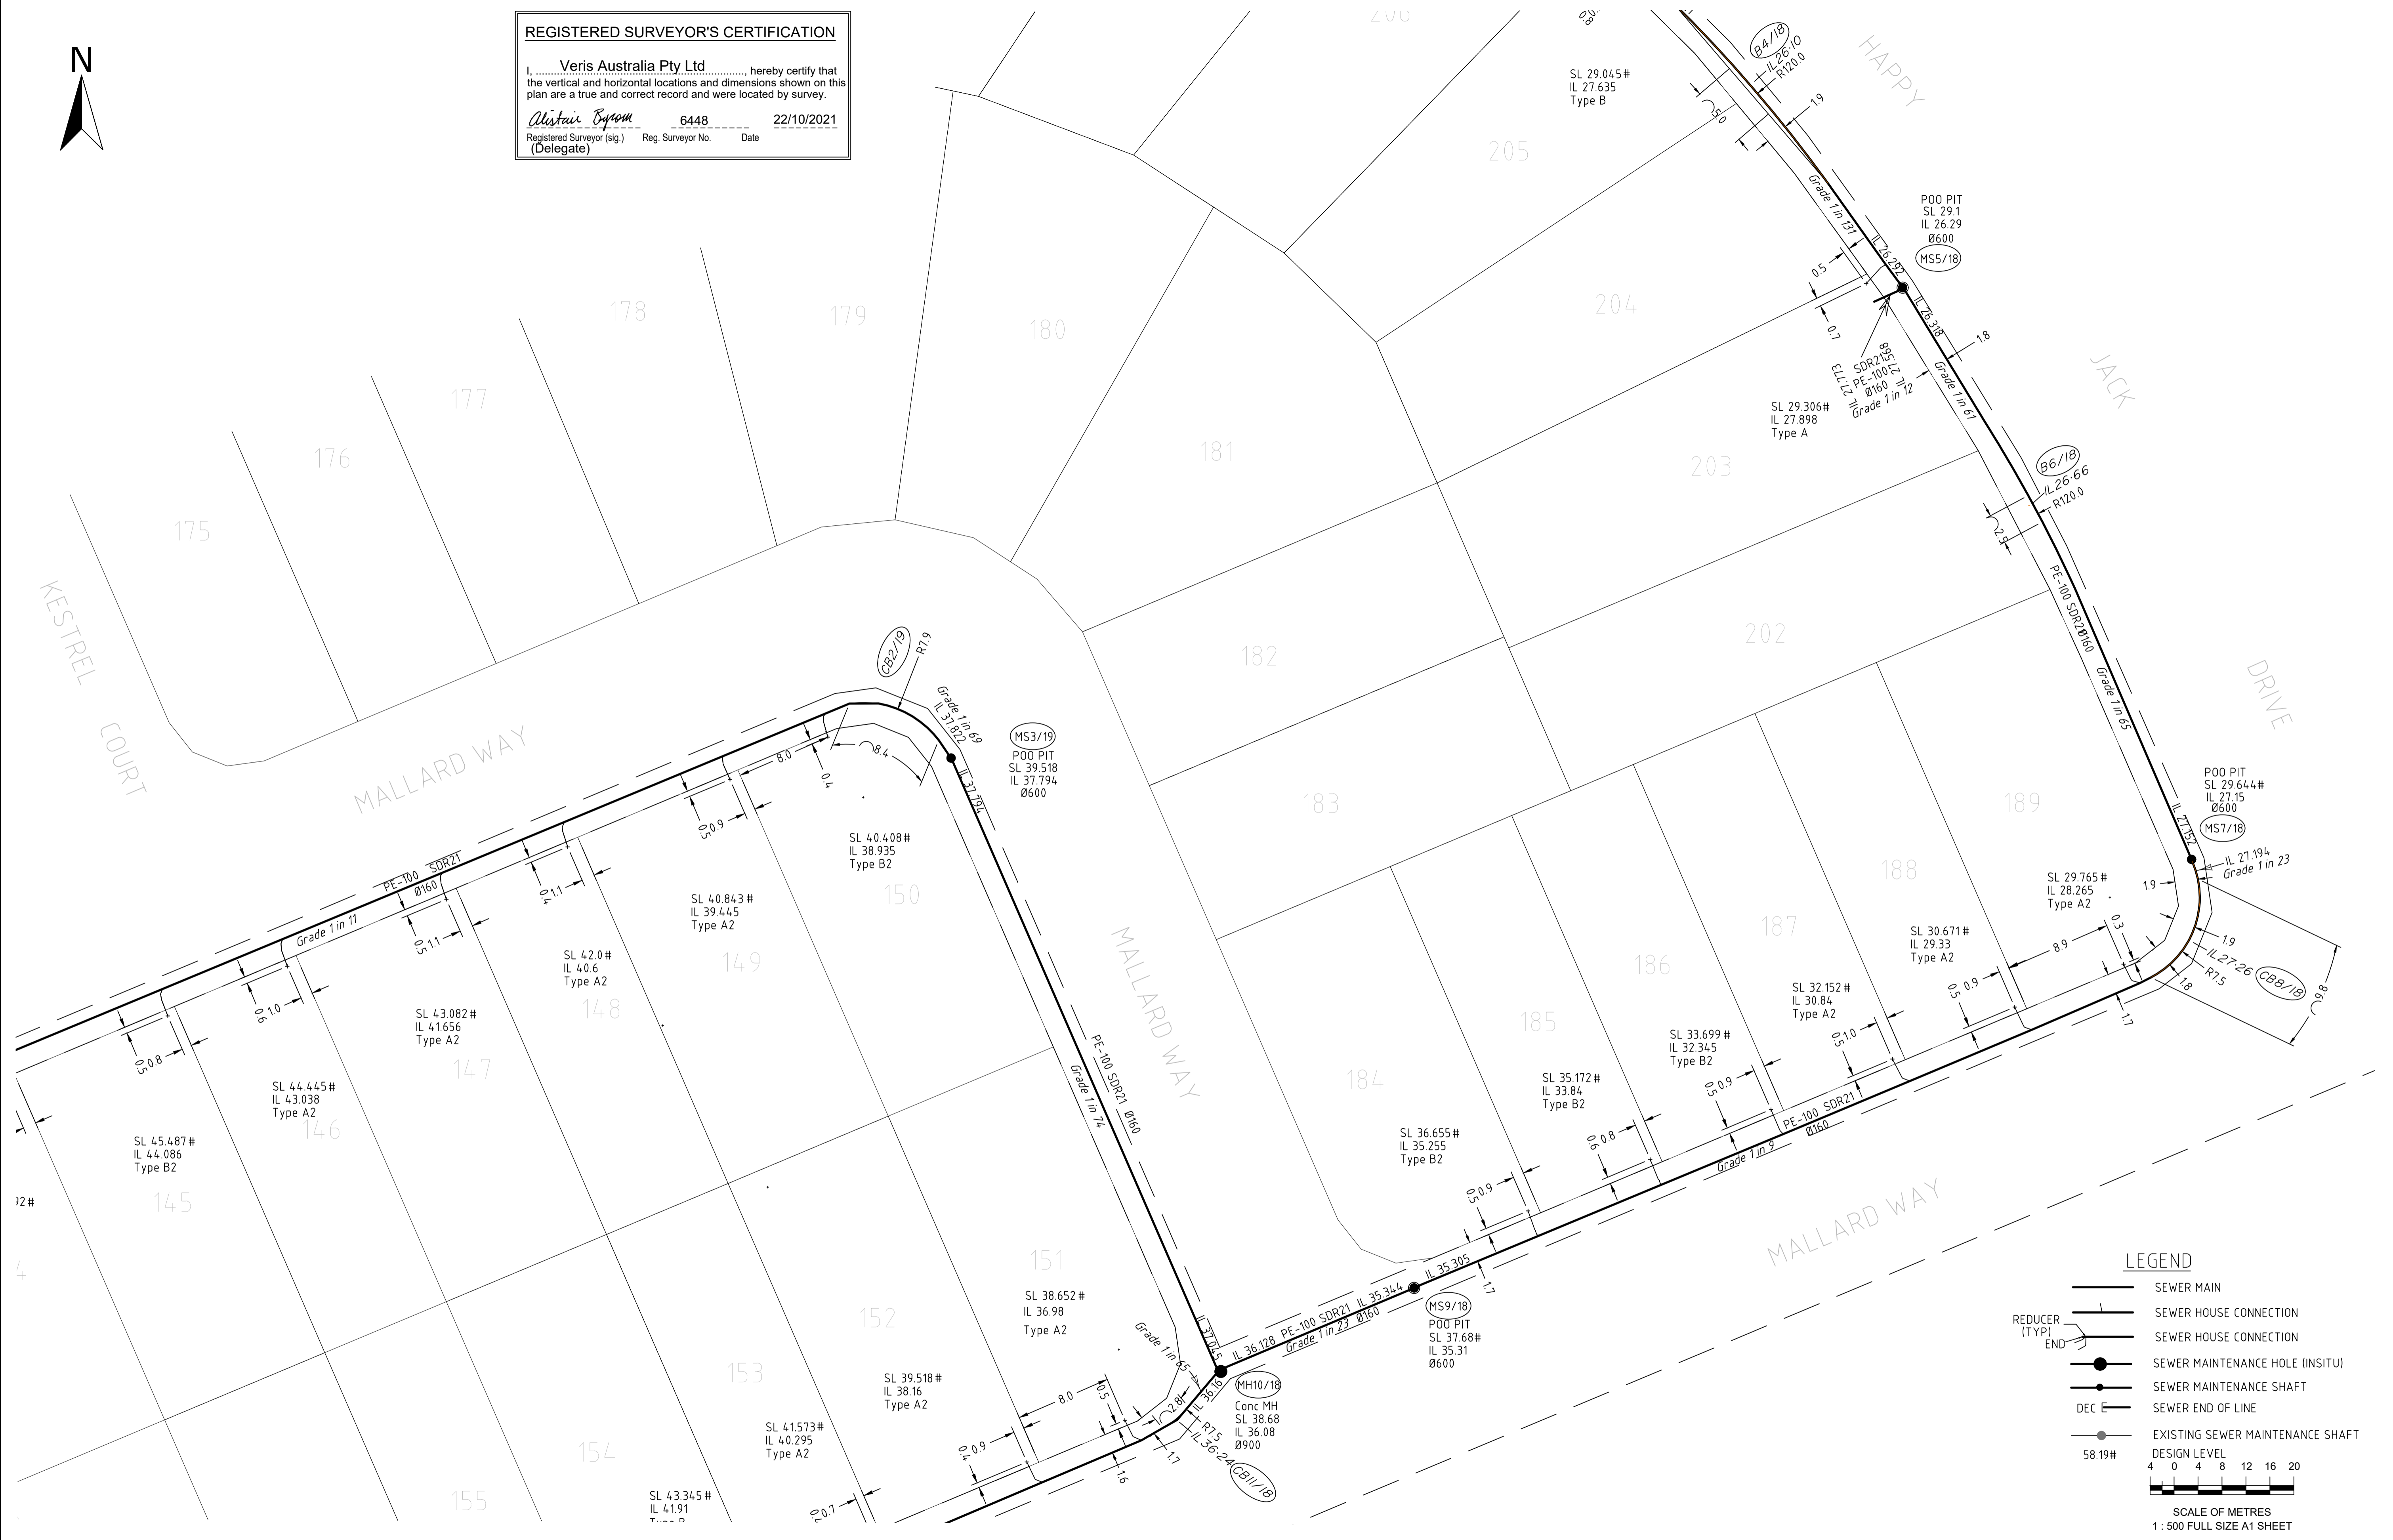

**LEGEND**

- SEWER MAIN
- SEWER HOUSE CONNECTION
- SEWER HOUSE CONNECTION
- SEWER MAINTENANCE HOLE (INSITU)
- SEWER MAINTENANCE SHAFT
- SEWER END OF LINE
- EXISTING SEWER MAINTENANCE SHAFT

DESIGN LEVEL  
 4 0 4 8 12 16 20

SCALE OF METRES  
 1: 500 FULL SIZE A1 SHEET

<b>A1</b>	F	19/10/2021	FINAL	MJT/GF				
	E	07/09/2021	PROGRESS PLOT	JMc				
	D	24/08/2021	SHEET 8 REMOVED	JMc		DRAWN	JMc	23/06/2021
	C	16/08/2021	PROGRESS PLOT	JMc		CHECKED		
	B	19/07/2021	PROGRESS PLOT	JMc		APPROVED		
	REV NO	DATE	REVISION PURPOSE / DESCRIPTION	DRAWN	RPEQ	RPEQ No	INITIALS	DATE

**veris**  
 BRISBANE WHITSUNDAYS  
 (07) 3966 4700 (07) 4942 6000  
 MACKAY CAIRNS  
 (07) 4967 9700 (07) 4252 9400  
 veris.com.au  
 ACN 615 732 727  
 Veris Australia Pty Ltd



**BRENTWOOD FOREST**  
 7000 Jones Road, Bellbird Park  
**AS CONSTRUCTED SEWER STAGE 8**  
 SEWER


DRAWING STATUS <b>AS CONSTRUCTED</b>	
SHEET 6 OF 7 SHEETS	
DRAWING NO. <b>400891-AS08F</b>	REV. <b>F</b>



REGISTERED SURVEYOR'S CERTIFICATION

Veris Australia Pty Ltd hereby certify that the vertical and horizontal locations and dimensions shown on this plan are a true and correct record and were located by survey.

Alister Symon 6448 22/10/2021  
Registered Surveyor (sig.) Reg. Surveyor No. Date  
(Delegate)

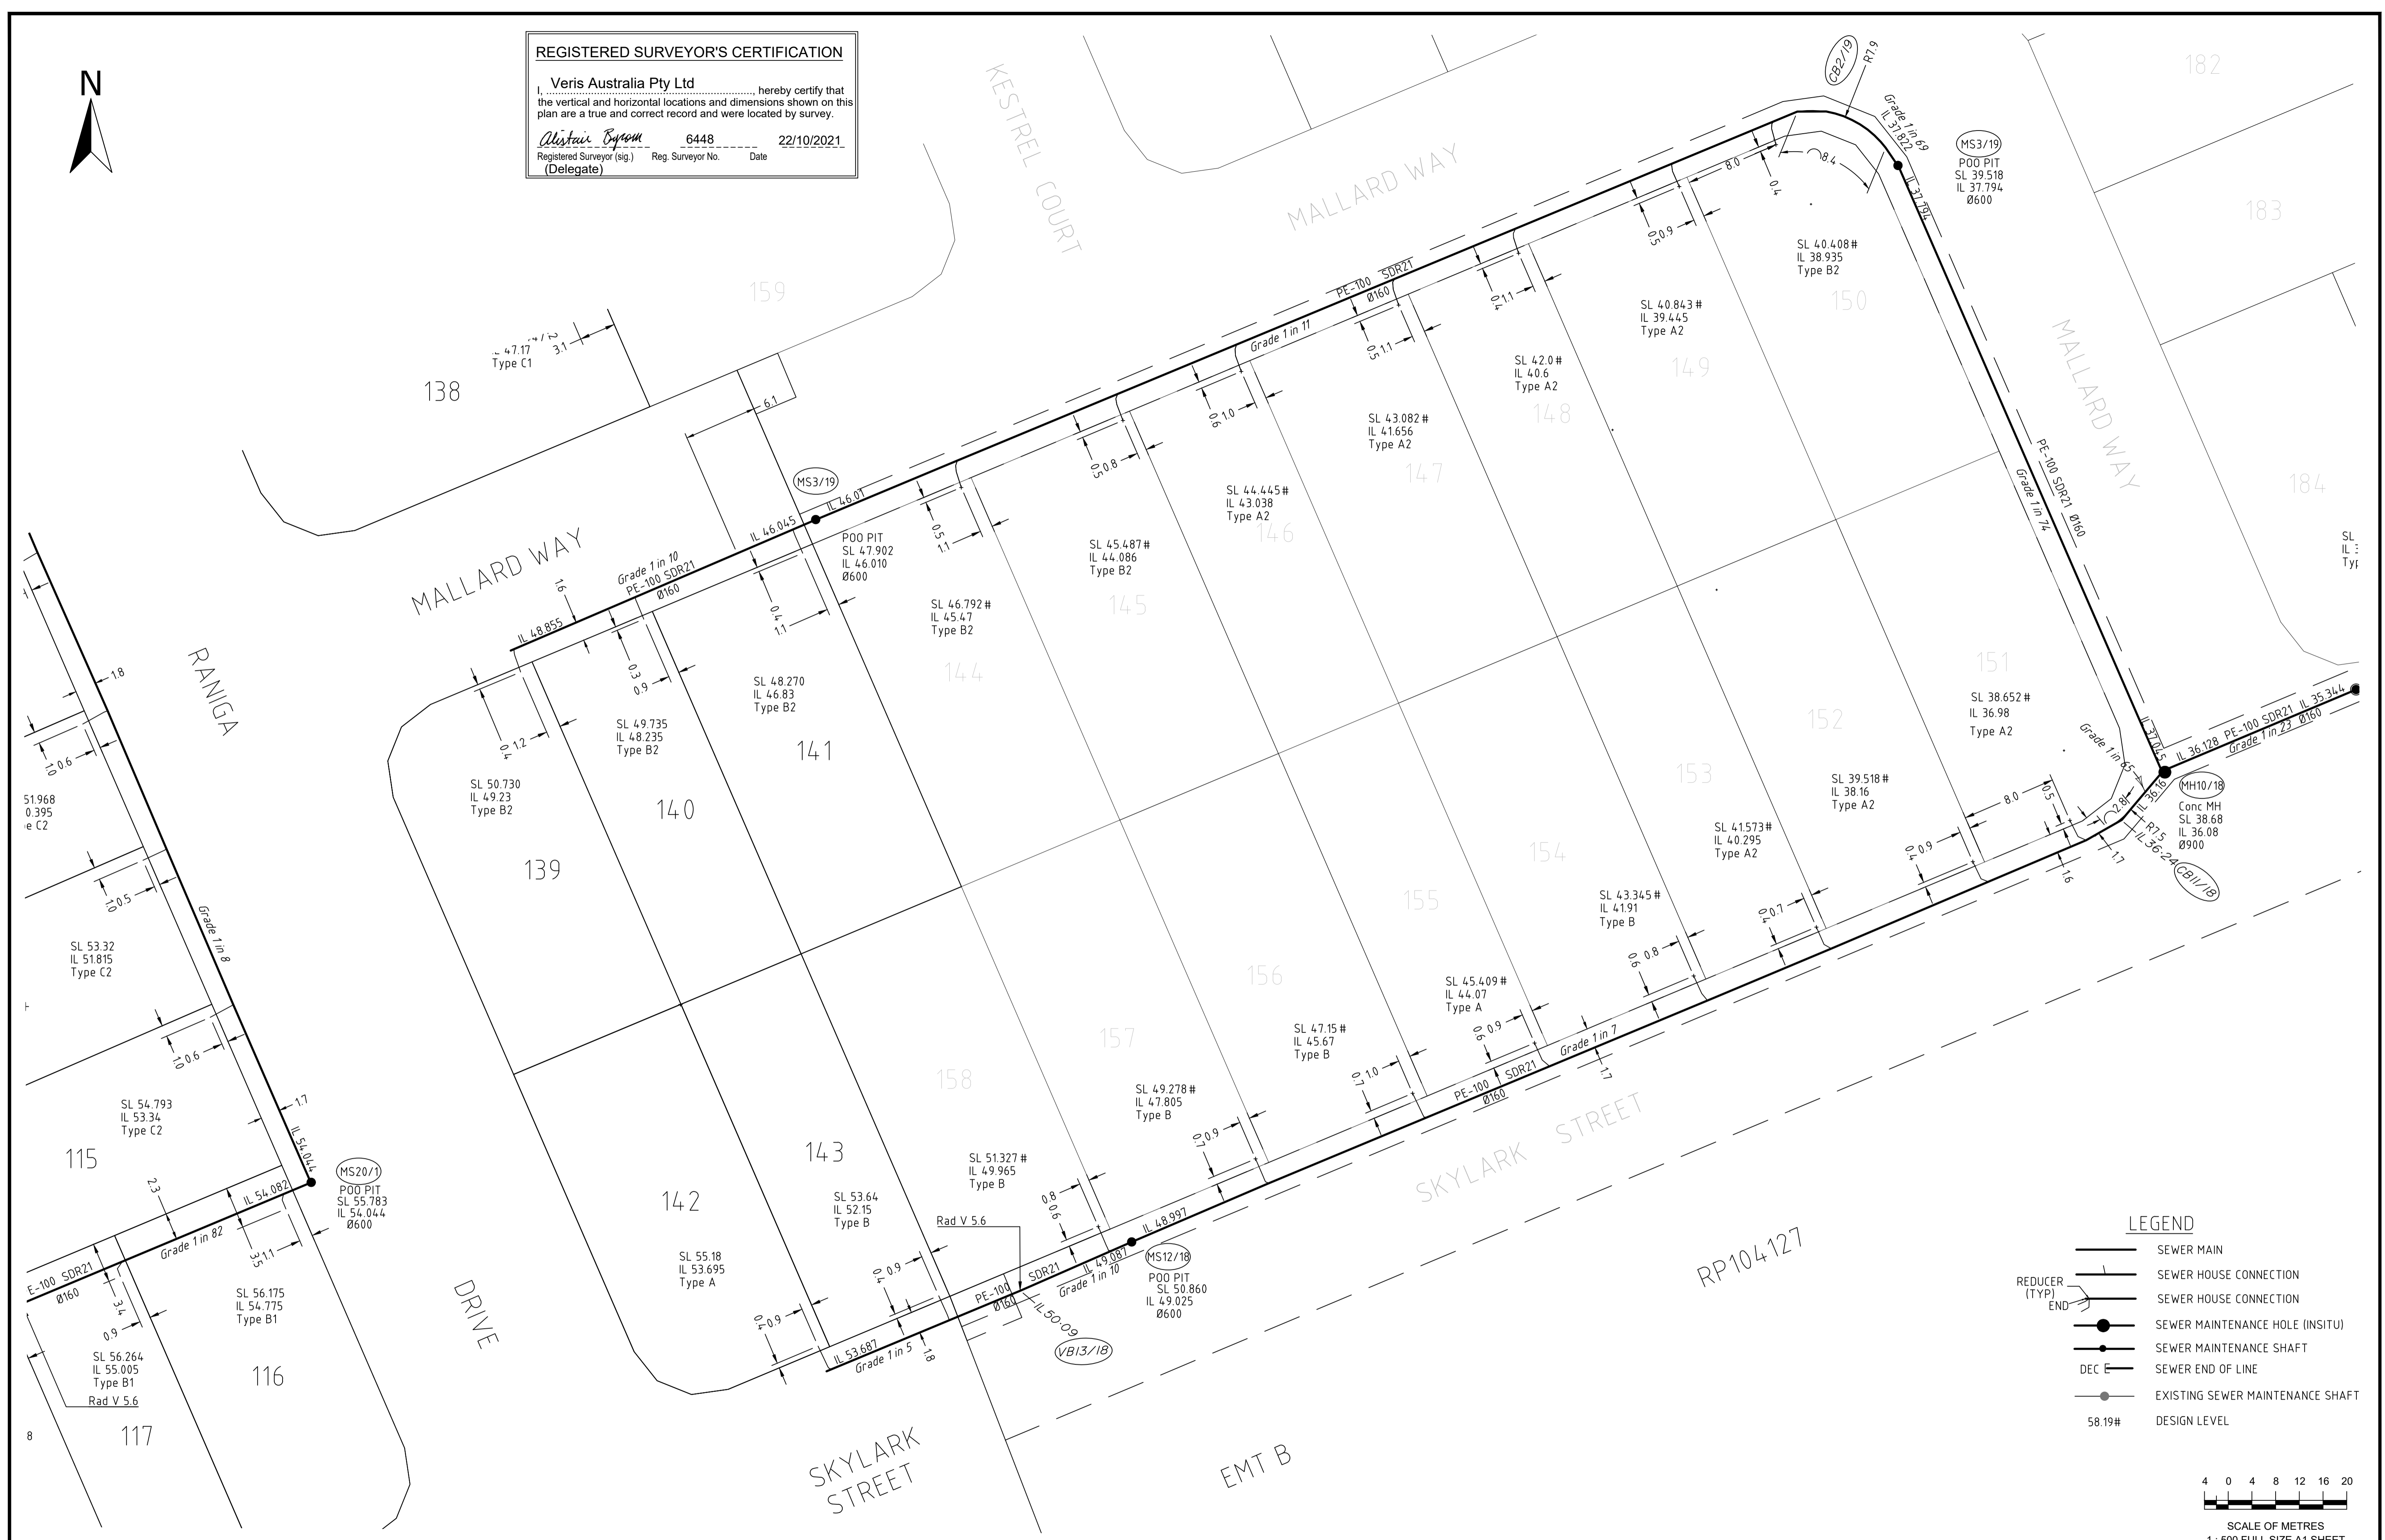

LEGEND

- SEWER MAIN
- SEWER HOUSE CONNECTION
- SEWER HOUSE CONNECTION
- SEWER MAINTENANCE HOLE (INSITU)
- SEWER MAINTENANCE SHAFT
- SEWER END OF LINE
- EXISTING SEWER MAINTENANCE SHAFT
- 58.19# DESIGN LEVEL



SCALE OF METRES  
1 : 500 FULL SIZE A1 SHEET

<b>A1</b>	F	19/10/2021	FINAL	MJT/GF				
	E	07/09/2021	PROGRESS PLOT	JMc				
	D	24/08/2021	SHEET 8 REMOVED	JMc		DRAWN	JMc	23/06/2021
	C	16/08/2021	PROGRESS PLOT	JMc		CHECKED		
	B	19/07/2021	PROGRESS PLOT	JMc		APPROVED		
	REV NO	DATE	REVISION PURPOSE / DESCRIPTION	DRAWN	RPEQ	RPEQ No	INITIALS	DATE

**veris**  
BRISBANE 071 3066 8700  
WHITSUNDAYS 071 4044 8600  
MACKAY 071 4967 8700  
CAIRNS 071 4252 9400  
veris.com.au  
ACN 615 732 727  
Veris Australia Pty Ltd

**QUEENSLAND UrbanUtilities**

**BRENTWOOD FOREST**  
7000 Jones Road, Bellbird Park  
**AS CONSTRUCTED SEWER STAGE 8**  
SEWER

DRAWING STATUS <b>AS CONSTRUCTED</b>	
SHEET 7 OF 7 SHEETS	
DRAWING NO. <b>400891-AS08F</b>	REV. <b>F</b>