


STAGE 11B

STAGE 10A

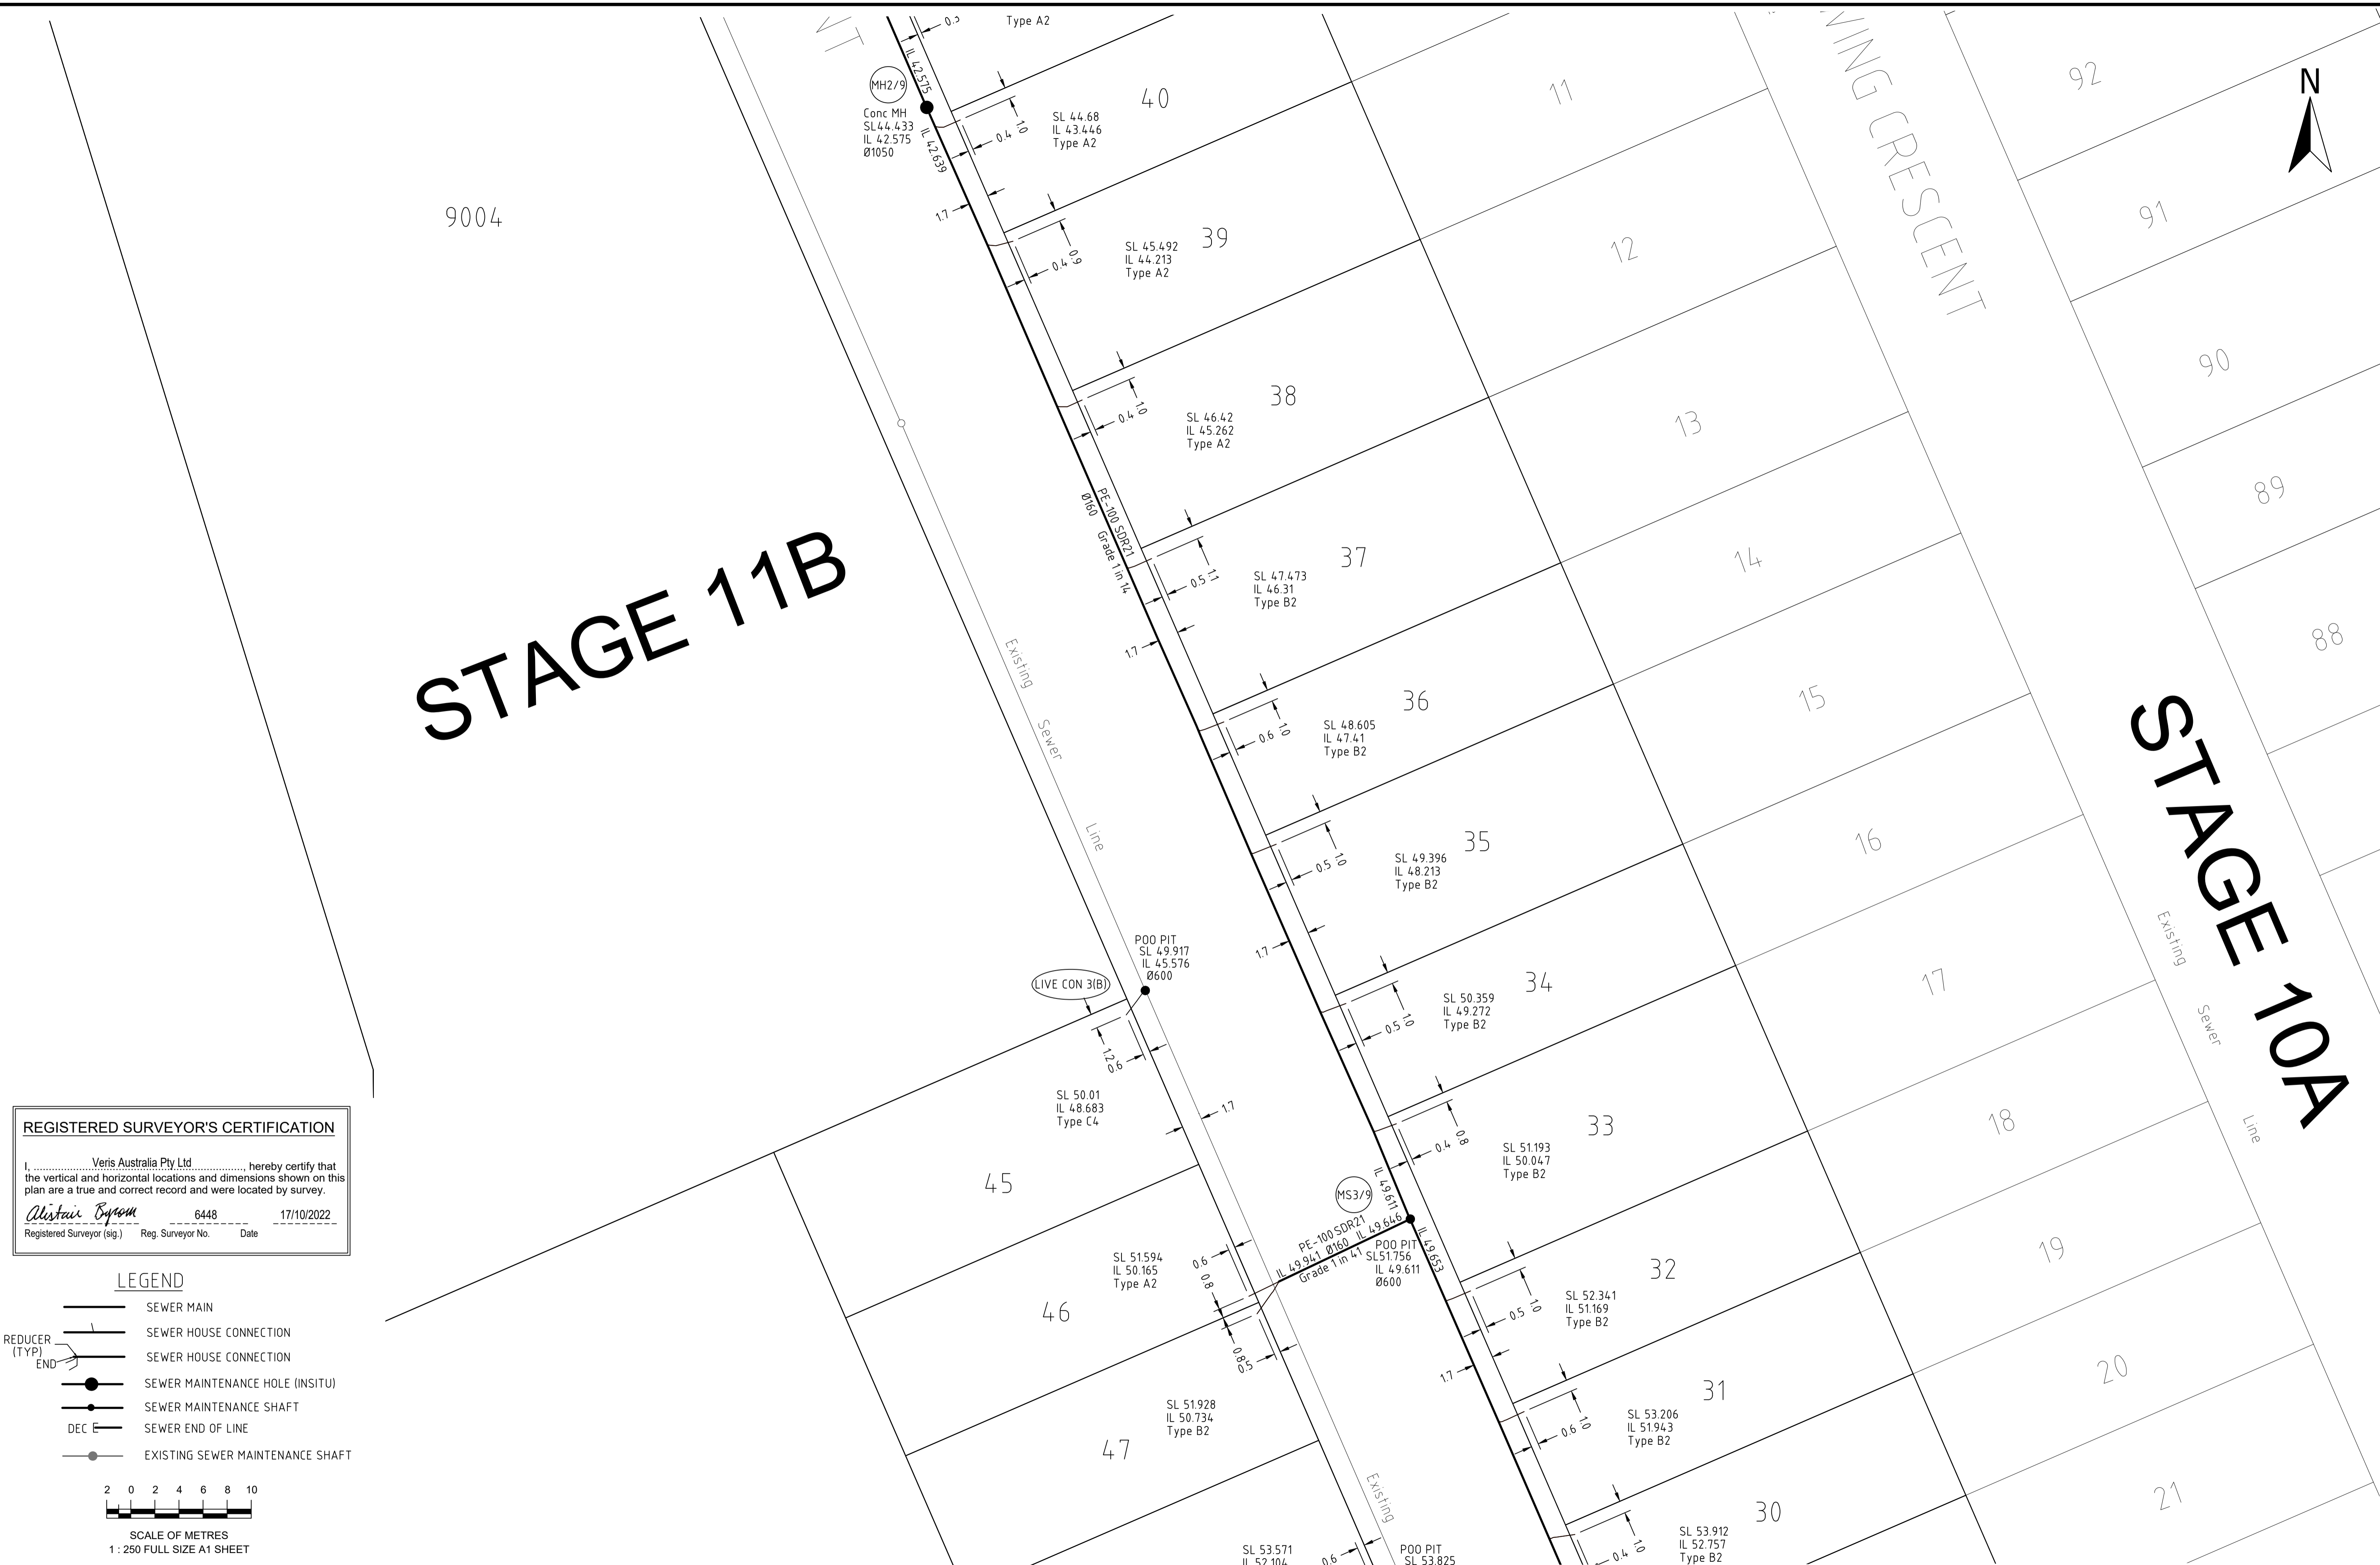

REGISTERED SURVEYOR'S CERTIFICATION

I, Veris Australia Pty Ltd, hereby certify that the vertical and horizontal locations and dimensions shown on this plan are a true and correct record and were located by survey.

Alistair Byron 6448 17/10/2022
 Registered Surveyor (sig.) Reg. Surveyor No. Date

LEGEND

- SEWER MAIN
- SEWER HOUSE CONNECTION
- SEWER HOUSE CONNECTION (REDUCER (TYP) END)
- SEWER MAINTENANCE HOLE (INSITU)
- SEWER MAINTENANCE SHAFT
- SEWER END OF LINE (DEC E)
- EXISTING SEWER MAINTENANCE SHAFT

2 0 2 4 6 8 10
 SCALE OF METRES
 1 : 250 FULL SIZE A1 SHEET

| | | | | | | | | |
|-----------|--------|------------|--------------------------------|-------|------|----------|----------|------------|
| A1 | D | 12/10/2022 | PROGRESS PLOT | JMc | | | | |
| | C | 06/10/2020 | PROGRESS PLOT | JMc | | DRAWN | JMc | 30/05/2022 |
| | B | 18/07/2022 | PROGRESS PLOT | JMc | | CHECKED | JH | 6/6/22 |
| | A | 30/05/2022 | PROGRESS PLOT | JMc | | APPROVED | | |
| | REV NO | DATE | REVISION PURPOSE / DESCRIPTION | DRAWN | RPEQ | RPEQ No | INITIALS | DATE |

veris

BRISBANE (07) 3664 4700 WHITSUNDAYS (07) 4945 6900
 MACKAY (07) 4957 9700 CAIRNS (07) 4252 9400
 veris.com.au
 ACN 615 735 727
 Veris Australia Pty Ltd

QUEENSLAND UrbanUtilities

BRENTWOOD FOREST
 7000 Jones Road, Bellbird Park
 AS CONSTRUCTED SEWER STAGE 11
 SEWER

DRAWING STATUS
 AS CONSTRUCTED
 SHEET 3 OF 4 SHEETS
 DRAWING NO. 400891-AS11 D
 REV. D

STAGE 11A

Lot 511
SP276300

REGISTERED SURVEYOR'S CERTIFICATION
 I, Veris Australia Pty Ltd, hereby certify that the vertical and horizontal locations and dimensions shown on this plan are a true and correct record and were located by survey.
Alistair Byron 6448 17/10/2022
 Registered Surveyor (sig.) Reg. Surveyor No. Date

LEGEND

- SEWER MAIN
- SEWER HOUSE CONNECTION
- REDUCER (TYP) END — SEWER HOUSE CONNECTION
- SEWER MAINTENANCE HOLE (INSITU)
- SEWER MAINTENANCE SHAFT
- DEC — SEWER END OF LINE
- EXISTING SEWER MAINTENANCE SHAFT

2 0 2 4 6 8 10
 SCALE OF METRES
 1 : 250 FULL SIZE A1 SHEET

| | | | | | | | | |
|-----------|--------|------------|--------------------------------|-------|------|----------|----------|------------|
| A1 | D | 12/10/2022 | PROGRESS PLOT | JMc | | | | |
| | C | 06/10/2022 | PROGRESS PLOT | JMc | | DRAWN | JMc | 30/05/2022 |
| | B | 18/07/2022 | PROGRESS PLOT | JMc | | CHECKED | JH | 6/6/22 |
| | A | 30/05/2022 | PROGRESS PLOT | JMc | | APPROVED | | |
| | REV NO | DATE | REVISION PURPOSE / DESCRIPTION | DRAWN | RPEQ | RPEQ No | INITIALS | DATE |

veris
 BRISBANE (07) 3664 4700 WHITSUNDAYS (07) 4945 6900
 MACKAY (07) 4957 9700 CAIRNS (07) 4252 9400
 veris.com.au
 ACN 615 735 727
 Veris Australia Pty Ltd

QUEENSLAND UrbanUtilities

BRENTWOOD FOREST
 7000 Jones Road, Bellbird Park
AS CONSTRUCTED SEWER STAGE 11 A

| | |
|--|------------------|
| DRAWING STATUS AS CONSTRUCTED | |
| SHEET 4 OF 4 SHEETS | |
| DRAWING NO. 400891-AS11 D | REV. D |

