

9008


SHEET 1

REGISTERED SURVEYOR'S CERTIFICATION

I, Veris Australia Pty Ltd hereby certify that the vertical and horizontal locations and dimensions shown on this plan are a true and correct record and were located by survey.
Alastair Byrom 6448 20/10/2022
Registered Surveyor (sig.) Reg. Surveyor No. Date

LEGEND

- SEWER MAIN
- SEWER HOUSE CONNECTION
- SEWER HOUSE CONNECTION
- SEWER MAINTENANCE HOLE (INSITU)
- SEWER MAINTENANCE SHAFT
- SEWER END OF LINE
- EXISTING SEWER MAINTENANCE SHAFT

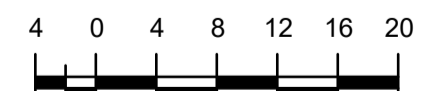

SCALE OF METRES
1 : 500 FULL SIZE A1 SHEET



| | | | | | | | |
|-----------|--------|------------|--------------------------------|-------|----------|---------|------------|
| A1 | C | 20/10/2022 | FINAL | MJT | DRAWN | JMc | 20/05/2022 |
| | B | 13/10/2022 | PROGRESS PLOT | JMc | CHECKED | | |
| | A | 20/05/2022 | PROGRESS PLOT | JMc | APPROVED | | |
| | REV NO | DATE | REVISION PURPOSE / DESCRIPTION | DRAWN | RPEQ | RPEQ No | INITIALS |

veris
BRISBANE (07) 3656 4700 WHITSUNDAYS (07) 4945 6900
MACKAY (07) 4957 9700 CAIRNS (07) 4252 9400
veris.com.au
ACN 615 735 727
Veris Australia Pty Ltd



BRENTWOOD FOREST
7000 Jones Road, Bellbird Park
AS CONSTRUCTED SEWER STAGE 13A(i)
SEWER


| | |
|---|------------------|
| DRAWING STATUS AS CONSTRUCTED | |
| SHEET 1 OF 2 SHEETS | |
| DRAWING NO. 400891-AS13 | REV. B |

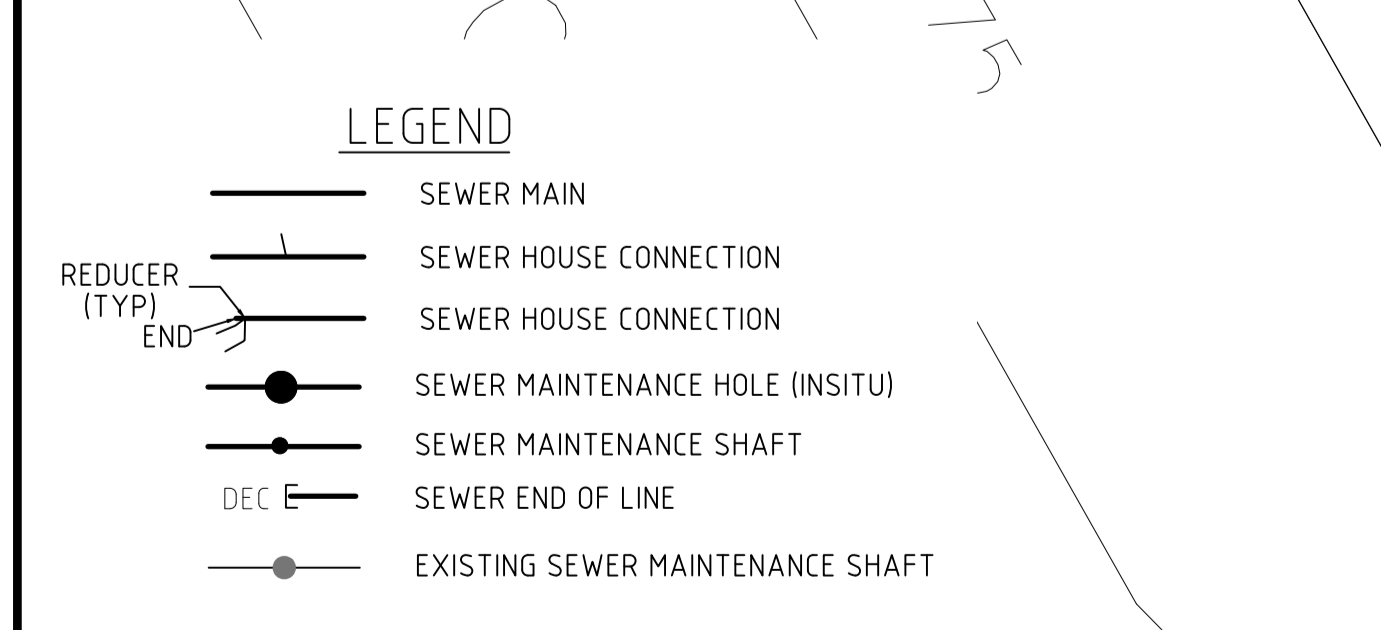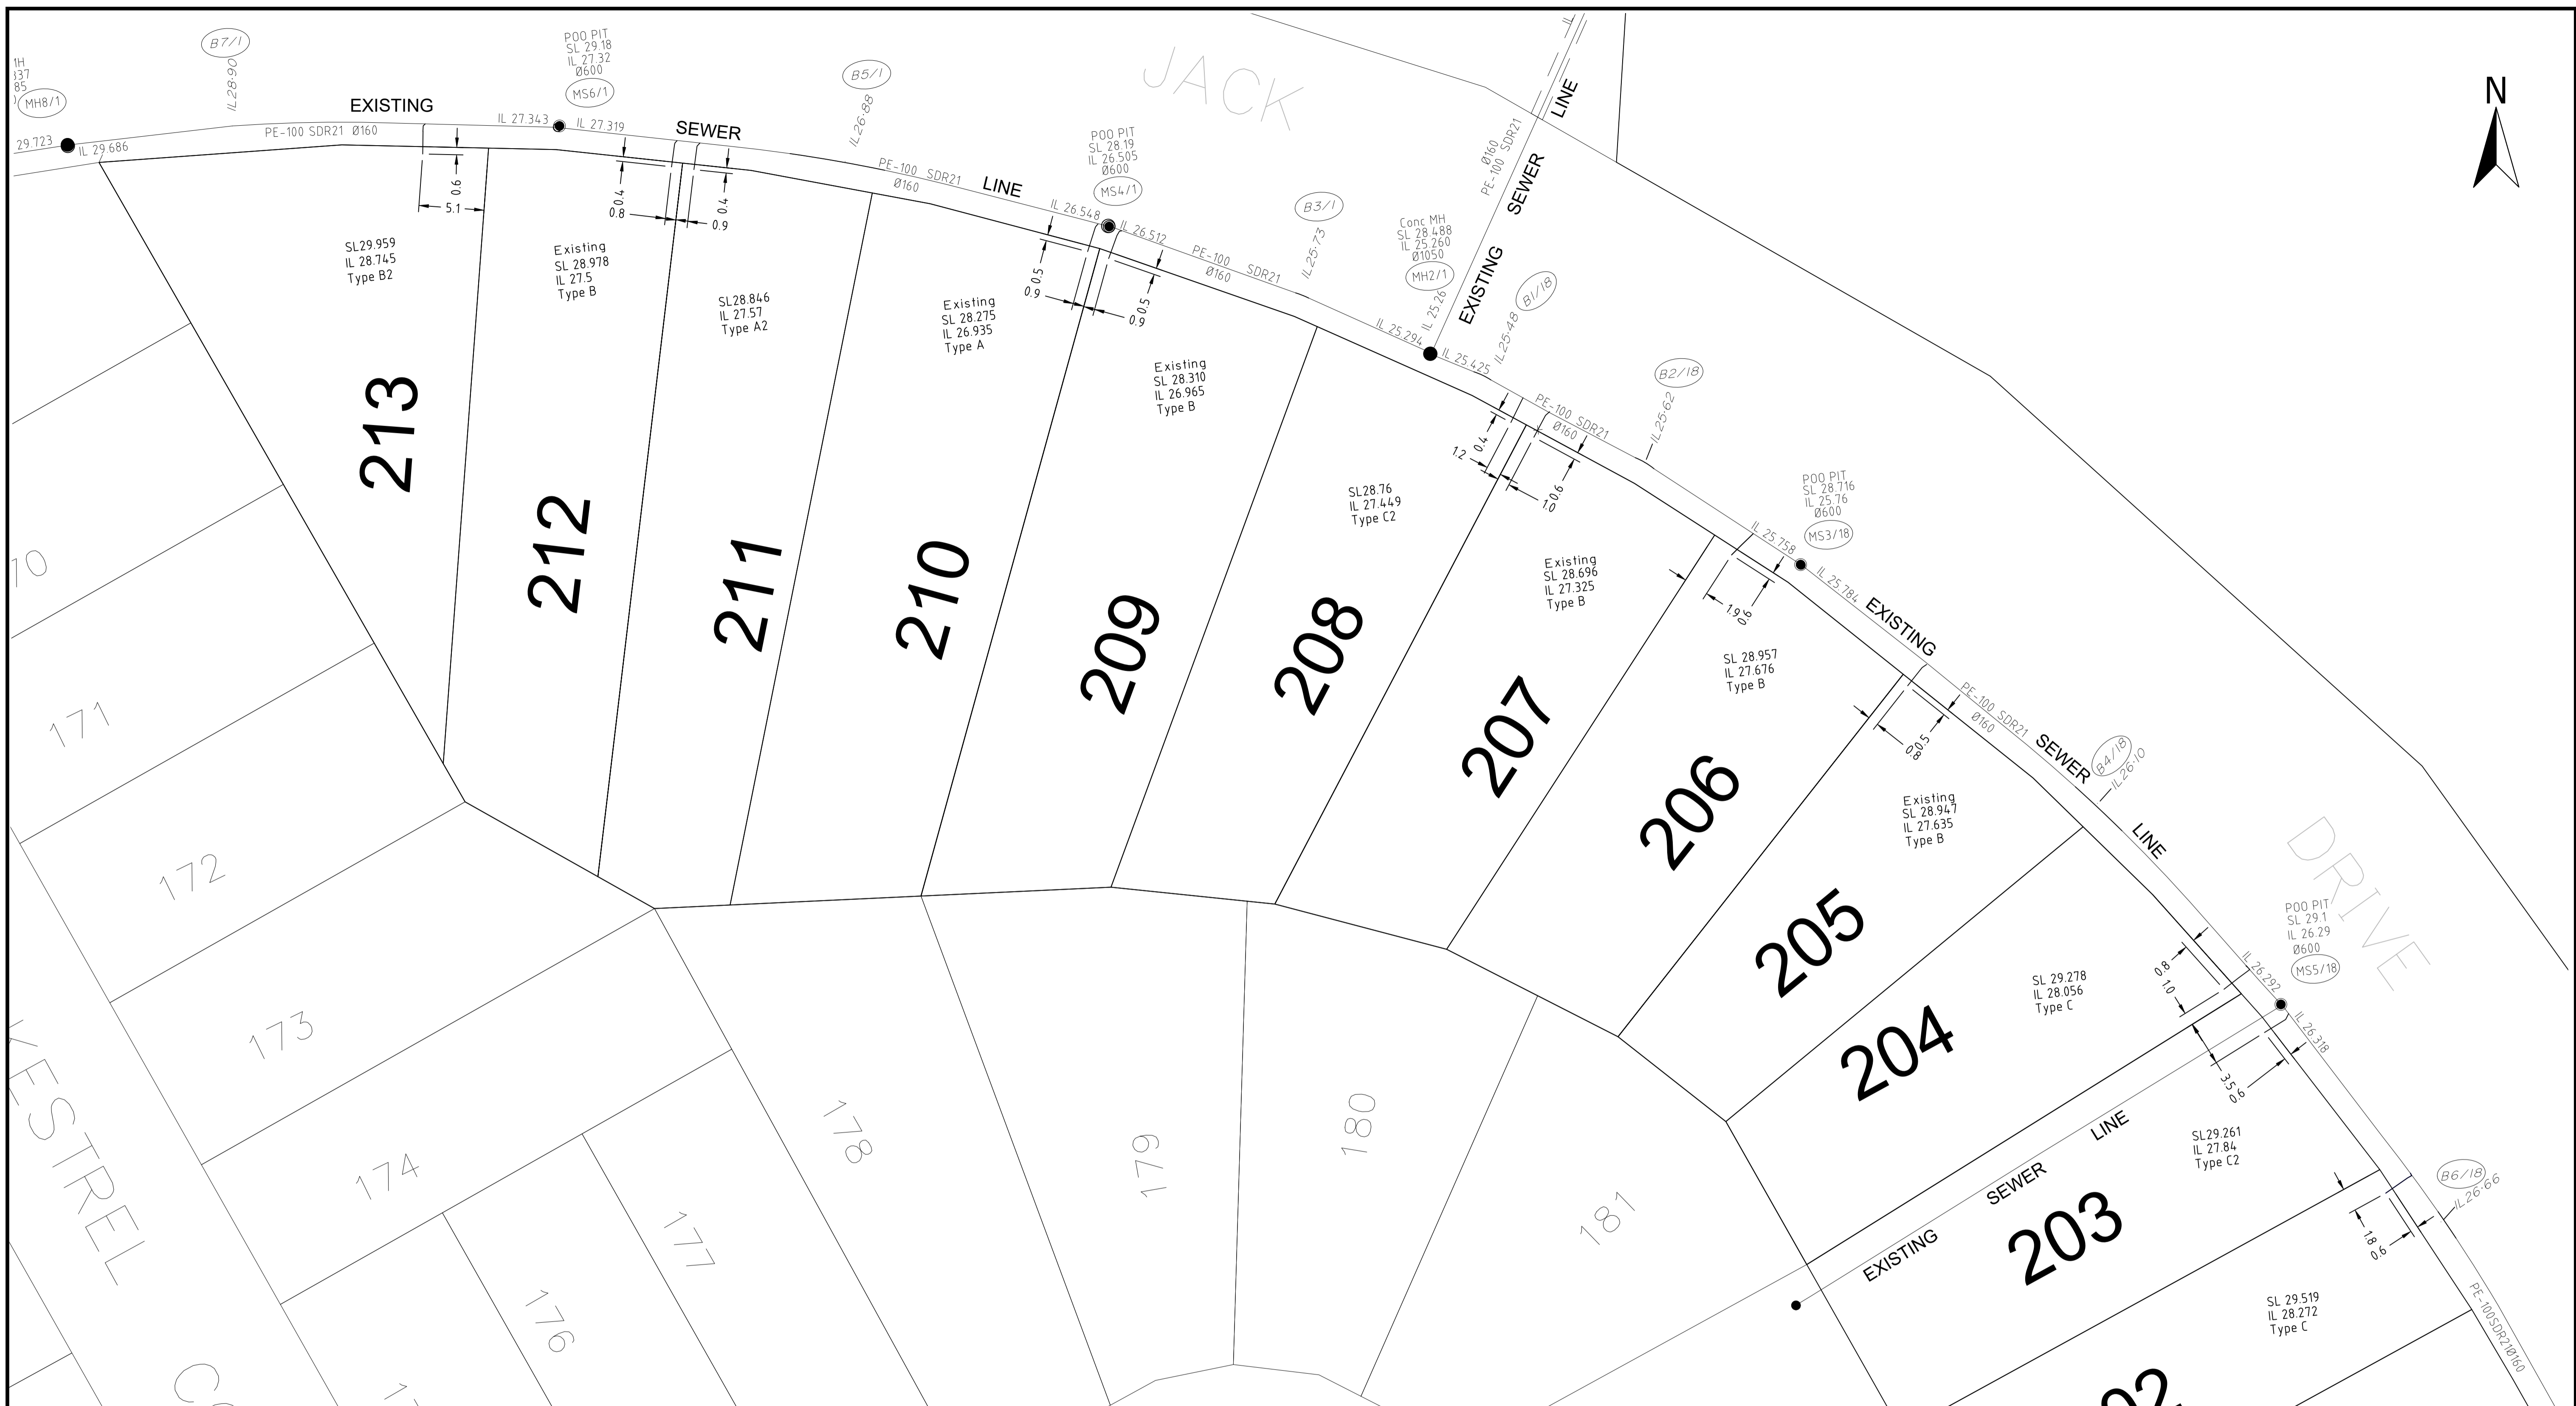

REGISTERED SURVEYOR'S CERTIFICATION

I, Veris Australia Pty Ltd, hereby certify that the vertical and horizontal locations and dimensions shown on this plan are a true and correct record and were located by survey.

Alistair Byrom 6448 20/10/2022
 Registered Surveyor (sig.) Reg. Surveyor No. Date

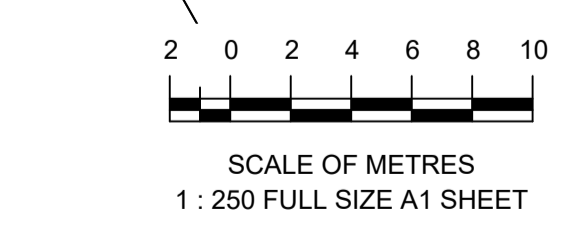

| | | | | | | | |
|-----------|--------|------------|--------------------------------|-------|----------|---------|------------|
| A1 | C | 20/10/2022 | FINAL | MJT | DRAWN | JMc | 20/05/2022 |
| | B | 13/10/2022 | PROGRESS PLOT | JMc | CHECKED | | |
| | A | 20/05/2022 | PROGRESS PLOT | JMc | APPROVED | | |
| | REV NO | DATE | REVISION PURPOSE / DESCRIPTION | DRAWN | RPEQ | RPEQ No | INITIALS |

veris

BRISBANE (07) 3656 4700 WHITSUNDAYS (07) 4945 6900
 MACKAY (07) 4957 9700 CAIRNS (07) 4252 9400
 veris.com.au
 ACN 615 735 727
 Veris Australia Pty Ltd

QUEENSLAND UrbanUtilities

BRENTWOOD FOREST
 7000 Jones Road, Bellbird Park
AS CONSTRUCTED SEWER STAGE 13A(i)
 SEWER

| | |
|-----------------------------------|------------------|
| DRAWING STATUS | |
| AS CONSTRUCTED | |
| SHEET 2 OF 2 SHEETS | |
| DRAWING NO. 400891-AS13 | REV. B |