



REGISTERED SURVEYOR'S CERTIFICATION

I, **VERIS AUSTRALIA PTY LTD**, hereby certify that the vertical and horizontal locations and dimensions shown on this plan are a true and correct record and were located by survey.
Alistair Byrom
 Registered Surveyor (sig) Reg. Surveyor No. 6448 Date: 26/11/2021

COORDINATE DATUM NOTE:
 HORIZONTAL COORDINATES (E,N) SUPPLIED ARE MAPPING GRID OF AUSTRALIA (MGA), ZONE 56 BASED ON THE UNIVERSAL TRANSVERSE MERCATOR PROJECTION AND THE GEOCENTRIC DATUM OF AUSTRALIA 2020.

A1	F	26/11/2021	FINAL										
	E	24/11/2021	AMEND PIPE 2/4-OUT/4, 1/2-2/2, 6/53-2/2, 3/51-4/51 & PIT SLs 1/6A & 7/51										
	D	03/11/2021	PROGRESS PLOT										
	C	22/10/2021	PROGRESS PLOT										
	B	18/08/2021	PROGRESS PLOT										
	INDEX	DATE	REVISIONS	DRAWN	CHECKED	PASSED							

DRAWN	JMc	21/07/2021
CHECKED	MJT	21/07/2021
PASSED		
INITIALS		DATE


veris
 BRISBANE (07) 3800 4700
 MACKAY (07) 4807 9700
 WHITSUNDAYS (07) 4945 0900
 CAIRNS (07) 4532 9400
 veris.com.au
 ACN 616 735 727
 Veris Australia Pty Ltd



IPSWICH CITY COUNCIL

BRENTWOOD STAGE 8
 AS CONSTRUCTED
 DRAINAGE

SCALE	1:600 @A1
SHEET	1 OF 5 SHEETS
DRAWING NO.	400891-ASW08
	F
	E
	D
	C
	B

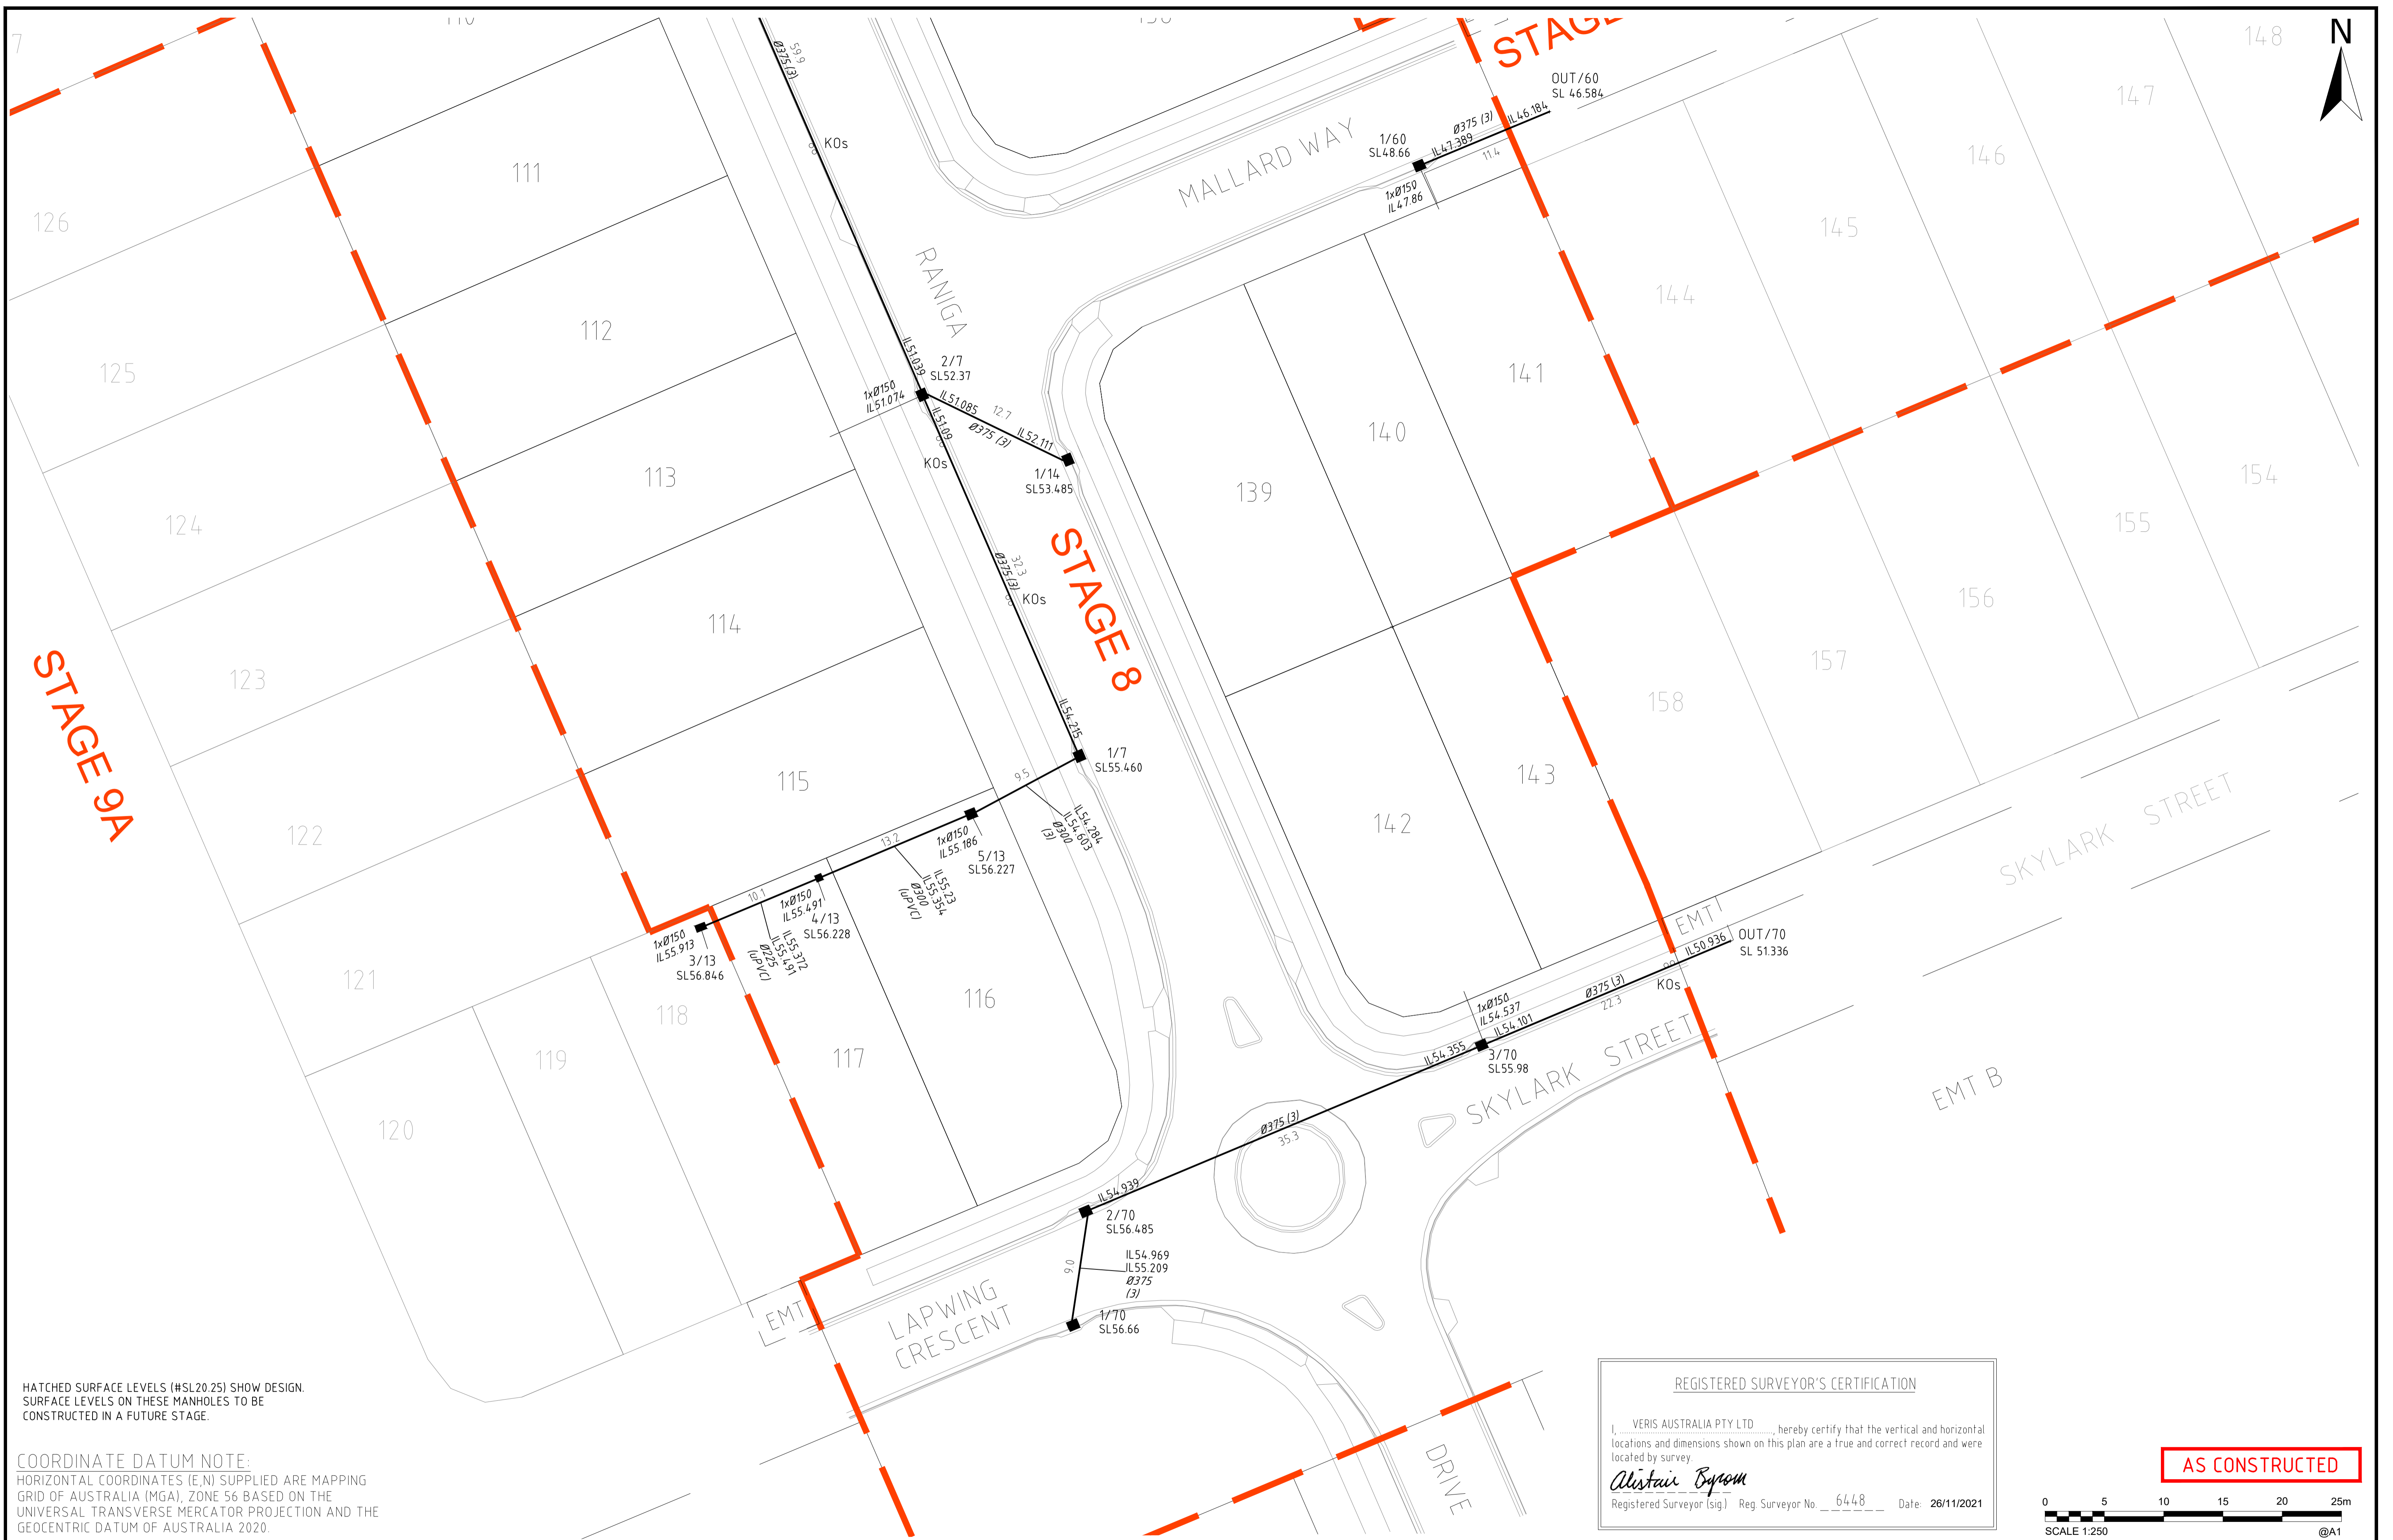


HATCHED SURFACE LEVELS (#SL20.25) SHOW DESIGN. SURFACE LEVELS ON THESE MANHOLES TO BE CONSTRUCTED IN A FUTURE STAGE.

COORDINATE DATUM NOTE:
HORIZONTAL COORDINATES (E,N) SUPPLIED ARE MAPPING GRID OF AUSTRALIA (MGA), ZONE 56 BASED ON THE UNIVERSAL TRANSVERSE MERCATOR PROJECTION AND THE GEOCENTRIC DATUM OF AUSTRALIA 2020.

REGISTERED SURVEYOR'S CERTIFICATION
I, VERIS AUSTRALIA PTY LTD, hereby certify that the vertical and horizontal locations and dimensions shown on this plan are a true and correct record and were located by survey.
Alastair Byrom
Registered Surveyor (sig) Reg. Surveyor No. 6448 Date: 26/11/2021

AS CONSTRUCTED

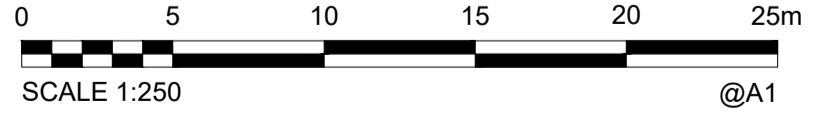

A1	E	26/11/2021	FINAL	MJT		
	E	03/11/2021	AMEND PIPE 2/4-OUT/4, 1/2-2/2, 6/53-2/2, 3/51-4/51 & PIT SLs 1/6A & 7/51	GJF		
	D	03/11/2021	PROGRESS PLOT	GJF		
	C	22/10/2021	PROGRESS PLOT	GJF		
	B	18/08/2021	PROGRESS PLOT	JMc		
	INDEX	DATE	REVISIONS	DRAWN	CHECKED	PASSED

DRAWN	JMc	21/07/2021
CHECKED	MJT	21/07/2021
PASSED		
INITIALS		DATE

veris
BRISBANE 071 3664 4700
MACKAY 071 4601 9100
WHITSUNDAYS 071 4945 0600
CAIRNS 071 4522 9400
veris.com.au
ACN 615 735 727
Veris Australia Pty Ltd



IPSWICH CITY COUNCIL

BRENTWOOD STAGE 8
AS CONSTRUCTED
DRAINAGE

SCALE	1:250 @A1
SHEET	2 OF 5 SHEETS
DRAWING NO.	400891-ASW08
	F
	E
	D
	C
	B




HATCHED SURFACE LEVELS (#SL20.25) SHOW DESIGN SURFACE LEVELS ON THESE MANHOLES TO BE CONSTRUCTED IN A FUTURE STAGE.

REGISTERED SURVEYOR'S CERTIFICATION
 I, VERIS AUSTRALIA PTY LTD, hereby certify that the vertical and horizontal locations and dimensions shown on this plan are a true and correct record and were located by survey.
Alastair Byrom
 Registered Surveyor (s/g) Reg. Surveyor No. 6448 Date: 26/11/2021

COORDINATE DATUM NOTE:
 HORIZONTAL COORDINATES (E,N) SUPPLIED ARE MAPPING GRID OF AUSTRALIA (MGA), ZONE 56 BASED ON THE UNIVERSAL TRANSVERSE MERCATOR PROJECTION AND THE GEOCENTRIC DATUM OF AUSTRALIA 2020.

AS CONSTRUCTED

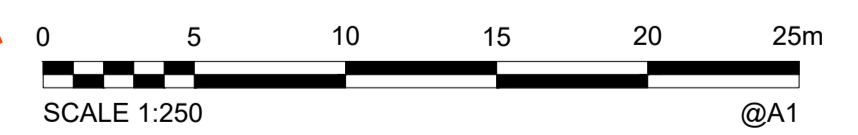


A1	F	26/11/2021	FINAL						
	E	24/11/2021	AMEND PIPE 2/4-OUT/4, 1/2-2/2, 6/53-2/2, 3/51-4/51 & PIT SLs 1/6A & 7/51						
	D	03/11/2021	PROGRESS PLOT						
	C	22/10/2021	PROGRESS PLOT						
	B	18/08/2021	PROGRESS PLOT						
INDEX	DATE	REVISIONS	DRAWN	CHECKED	PASSED				

DRAWN	JM	21/07/2021
CHECKED	MJT	21/07/2021
PASSED		
INITIALS		DATE



IPSWICH CITY COUNCIL
 BRENTWOOD STAGE 8
 AS CONSTRUCTED
 DRAINAGE

SCALE	1:250 @A1
SHEET	3 OF 5 SHEETS
DRAWING NO.	400891-ASW08
	F
	E
	D
	C
	B

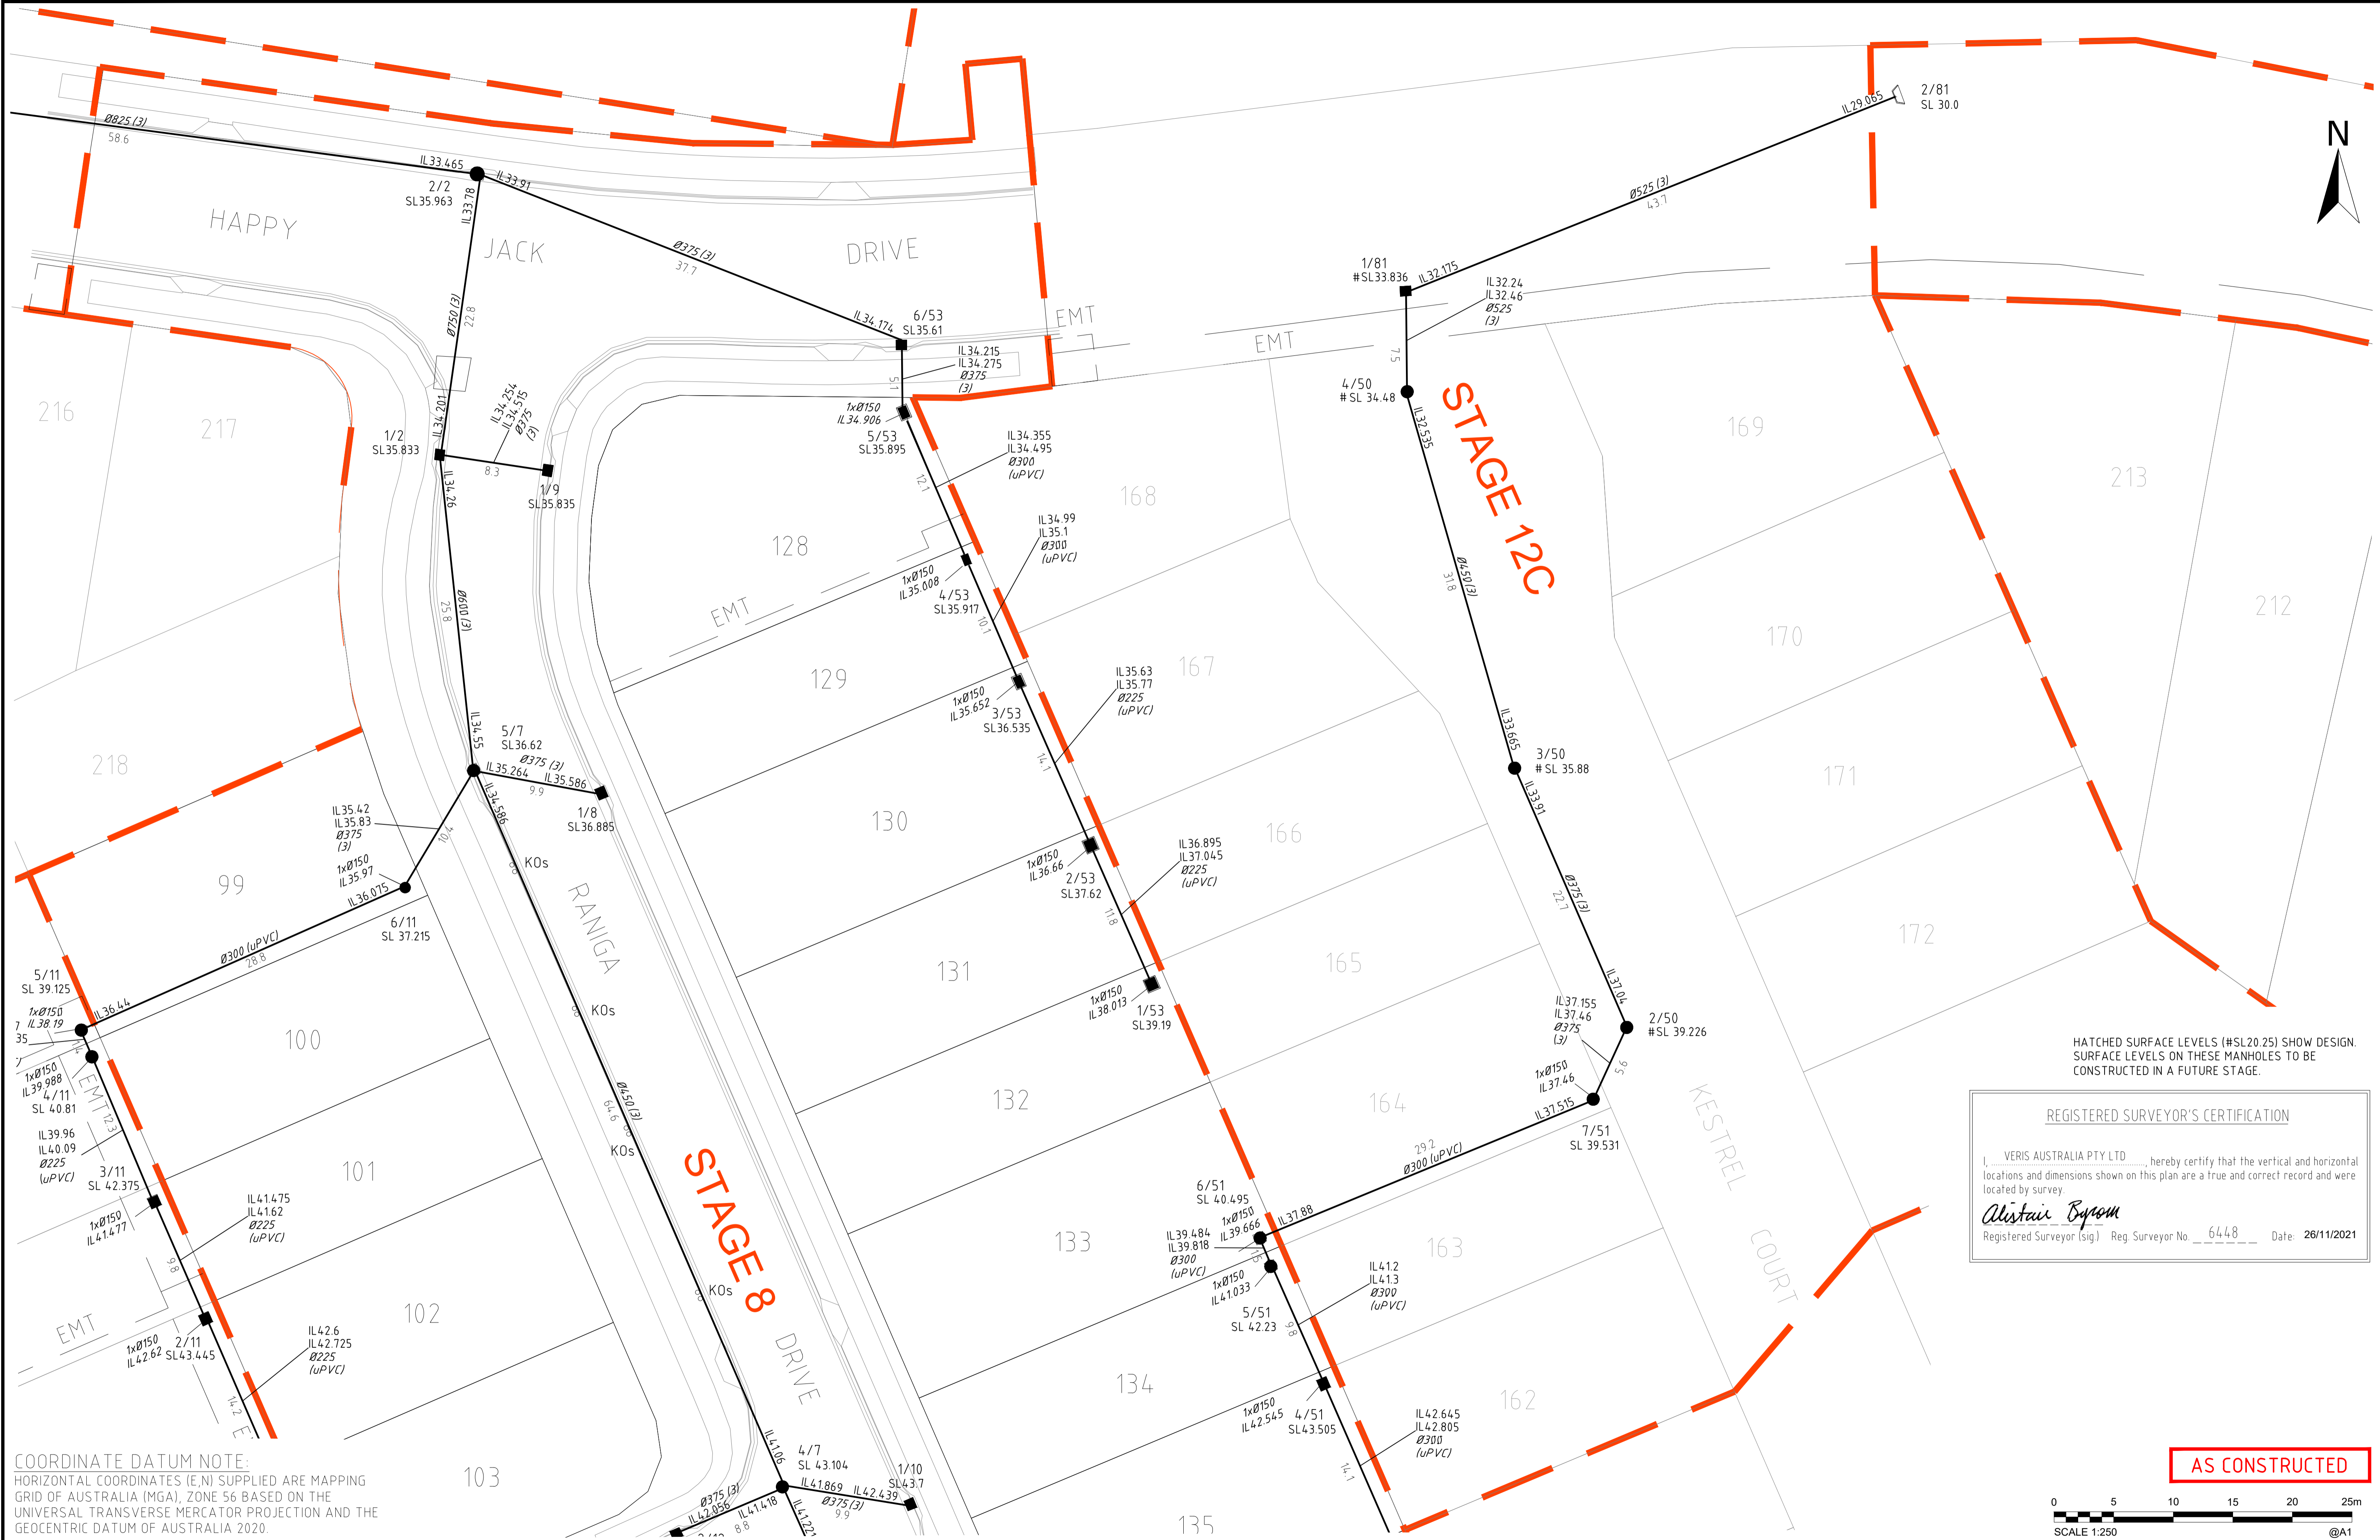

HATCHED SURFACE LEVELS (#SL20.25) SHOW DESIGN. SURFACE LEVELS ON THESE MANHOLES TO BE CONSTRUCTED IN A FUTURE STAGE.


REGISTERED SURVEYOR'S CERTIFICATION

I, VERIS AUSTRALIA PTY LTD, hereby certify that the vertical and horizontal locations and dimensions shown on this plan are a true and correct record and were located by survey.

Alistair Byrom
 Registered Surveyor (Sig.) Reg. Surveyor No. 6448 Date: 26/11/2021

COORDINATE DATUM NOTE:
 HORIZONTAL COORDINATES (E,N) SUPPLIED ARE MAPPING GRID OF AUSTRALIA (MGA), ZONE 56 BASED ON THE UNIVERSAL TRANSVERSE MERCATOR PROJECTION AND THE GEOCENTRIC DATUM OF AUSTRALIA 2020.

AS CONSTRUCTED

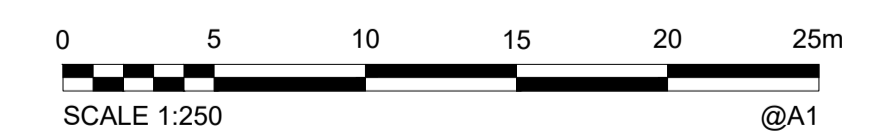

A1	F	26/11/2021	FINAL	MJT			
	E	24/11/2021	AMEND PIPE 2/4-OUT/4, 1/2-2/2, 6/53-2/2, 3/51-4/51 & PIT SLS 1/6A & 7/51	GJF			
	D	03/11/2021	PROGRESS PLOT	GJF			
	C	22/10/2021	PROGRESS PLOT	GJF			
	B	18/08/2021	PROGRESS PLOT				
INDEX	DATE	REVISIONS		DRAWN	CHECKED	PASSED	

DRAWN	MJT	21/07/2021
CHECKED	MJT	21/07/2021
PASSED		
INITIALS	DATE	

veris



BRISBANE (07) 3664 4700 WHITSUNDAYS (07) 4945 0000
 MACKAY (07) 4957 9700 CAIRNS (07) 4252 9400
 veris.com.au
 ACN 616 736 727
 Veris Australia Pty Ltd



IPSWICH CITY COUNCIL

BRENTWOOD STAGE 8
 AS CONSTRUCTED
 DRAINAGE


SCALE	1:250 @A1
SHEET	4 OF 5 SHEETS
DRAWING NO.	
400891-ASW08	

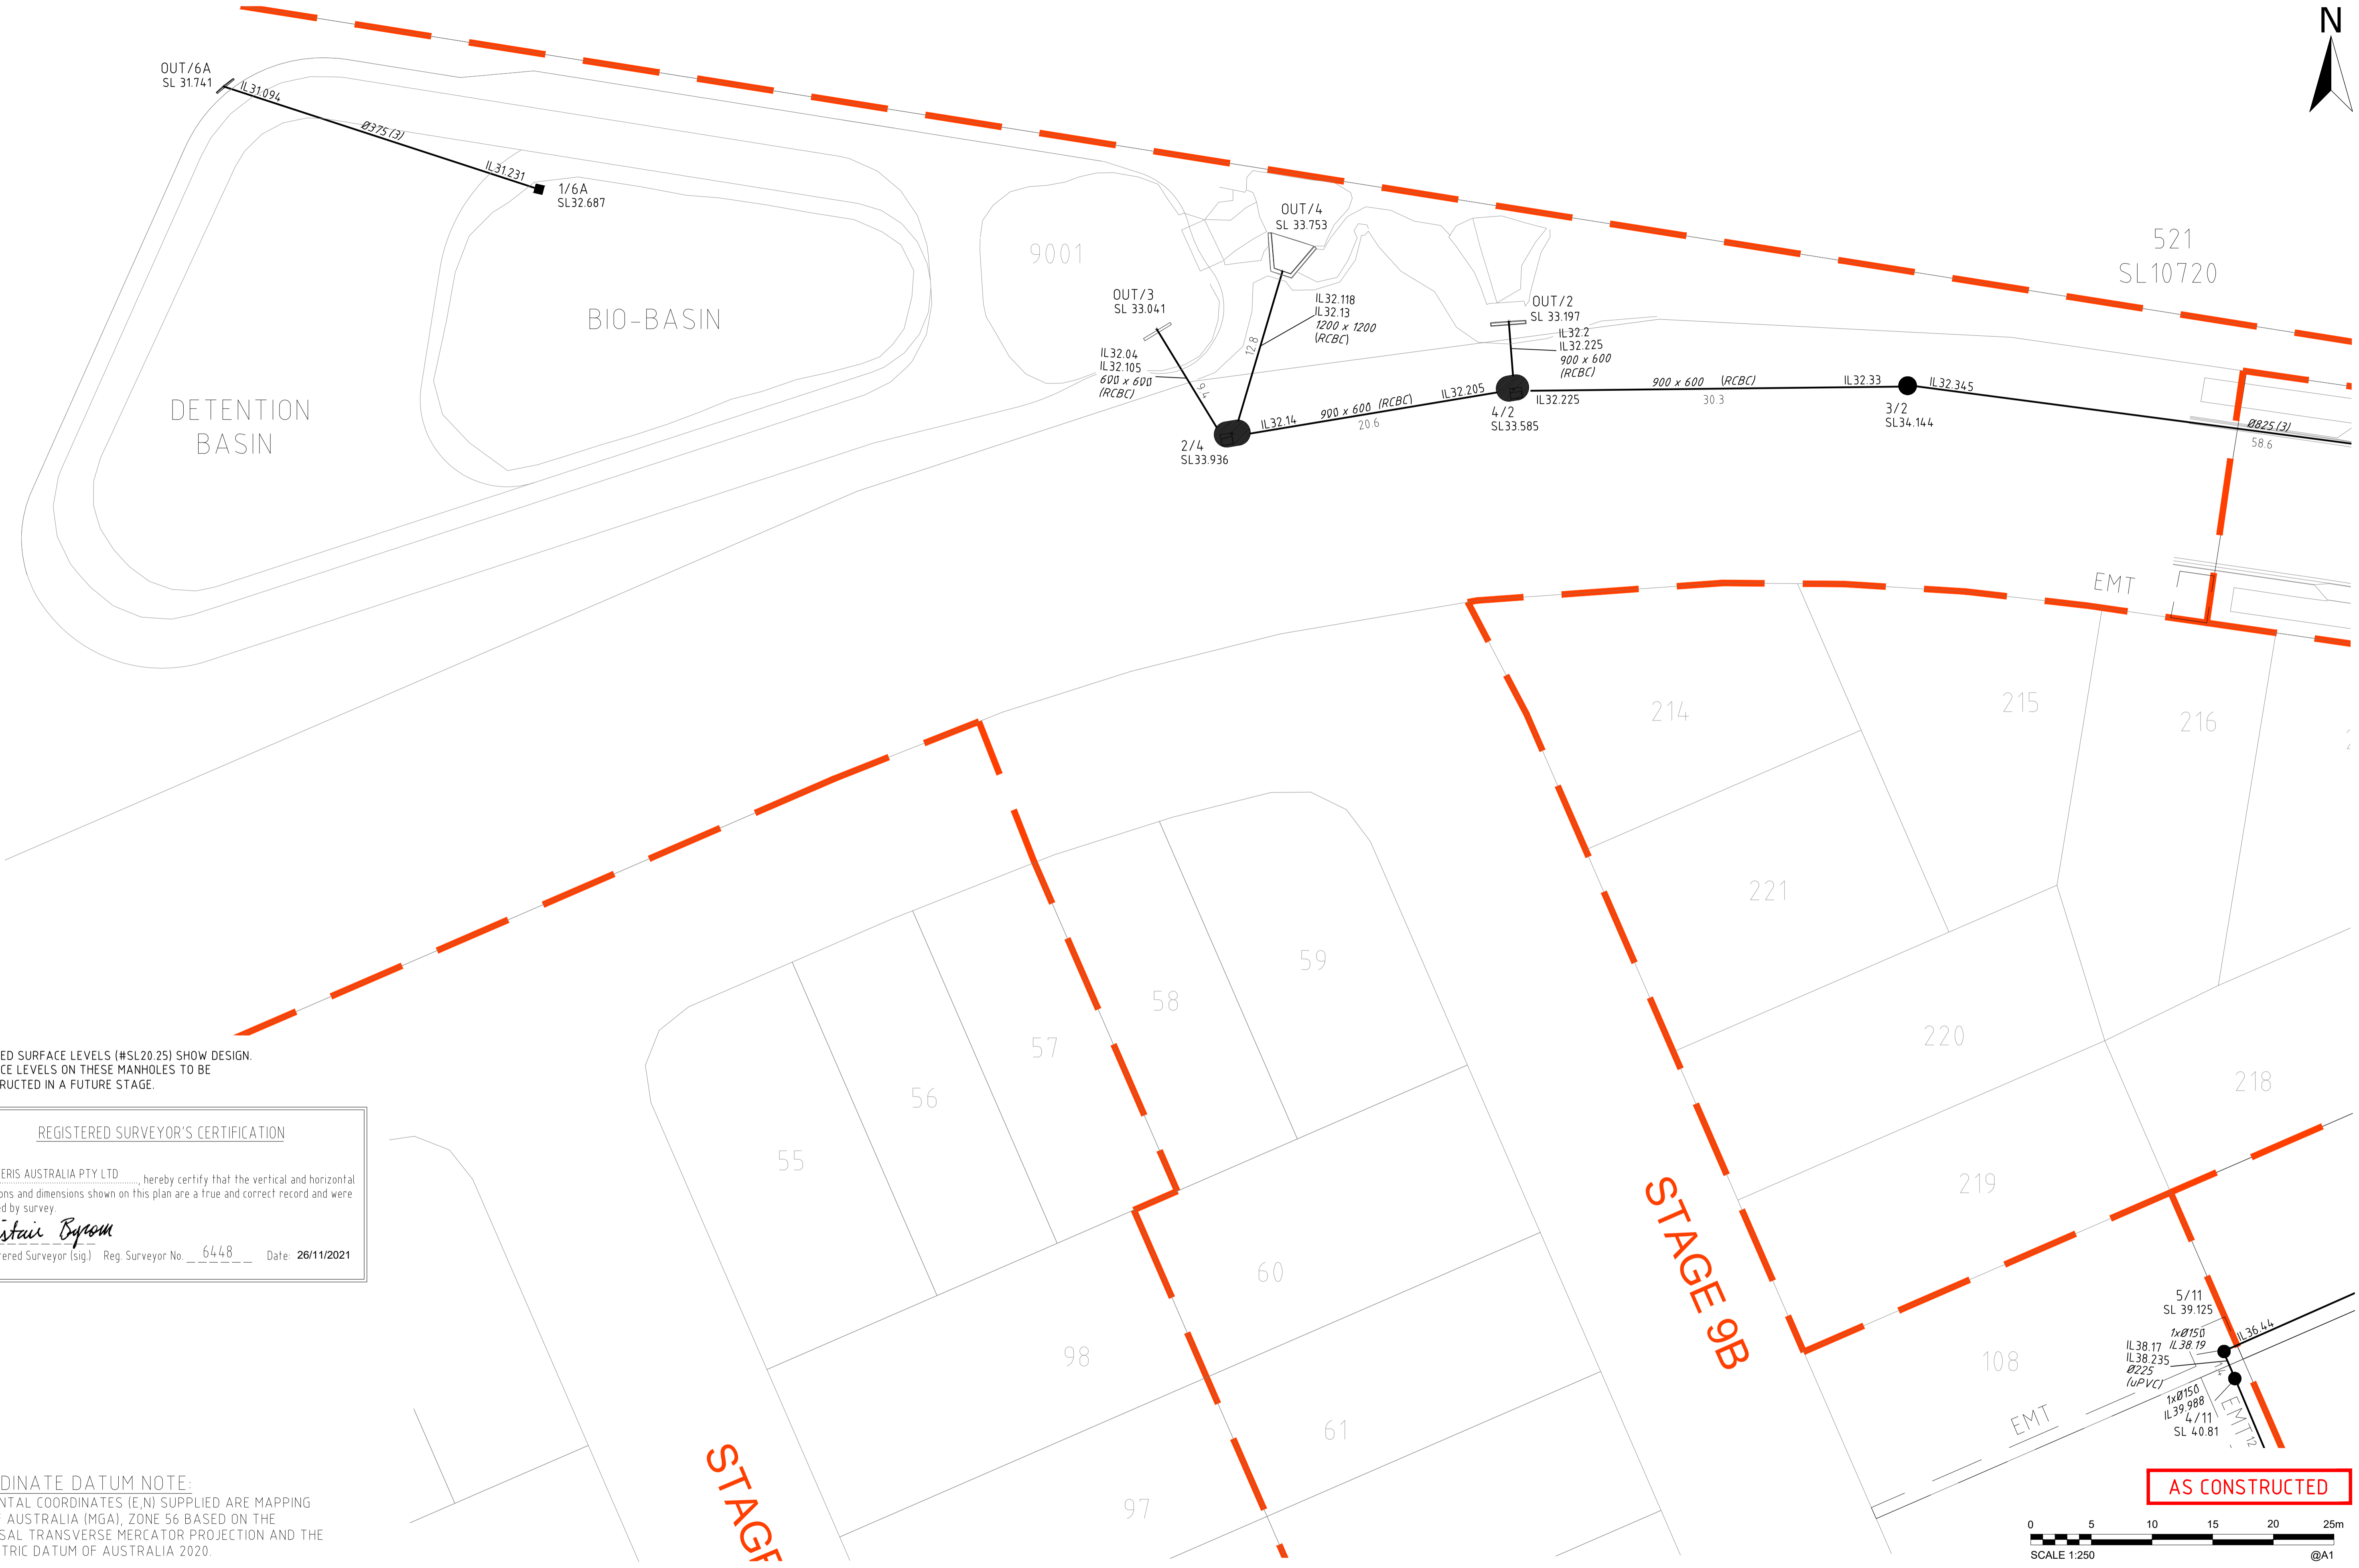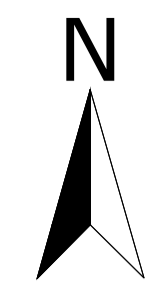

HATCHED SURFACE LEVELS (#SL20.25) SHOW DESIGN. SURFACE LEVELS ON THESE MANHOLES TO BE CONSTRUCTED IN A FUTURE STAGE.

REGISTERED SURVEYOR'S CERTIFICATION
I, VERIS AUSTRALIA PTY LTD, hereby certify that the vertical and horizontal locations and dimensions shown on this plan are a true and correct record and were located by survey.
Alistair Byrom
Registered Surveyor (sig.) Reg. Surveyor No. 6448 Date: 26/11/2021

COORDINATE DATUM NOTE:
HORIZONTAL COORDINATES (E,N) SUPPLIED ARE MAPPING GRID OF AUSTRALIA (MGA), ZONE 56 BASED ON THE UNIVERSAL TRANSVERSE MERCATOR PROJECTION AND THE GEOCENTRIC DATUM OF AUSTRALIA 2020.

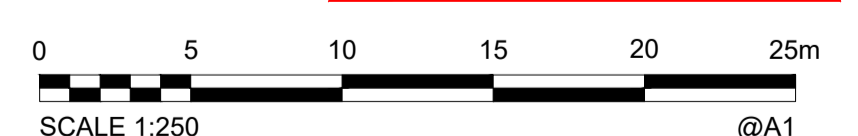


AS CONSTRUCTED

A1	F	26/11/2021	FINAL	MJT			
	E	24/11/2021	AMEND PIPE 2/4-OUT/4, 1/2-2/2, 6/53-2/2, 3/51-4/51 & PIT SLs 1/6A & 7/51	GJF			
	D	03/11/2021	PROGRESS PLOT	GJF			
	C	22/10/2021	PROGRESS PLOT	JMc			
	B	18/08/2021	PROGRESS PLOT	JMc			
INDEX	DATE	REVISIONS		DRAWN	CHECKED	PASSED	

DRAWN	JMc	21/07/2021
CHECKED	MJT	21/07/2021
PASSED		
INITIALS	DATE	

veris

BRISBANE (07) 3064 4700 WHITSUNDAYS (07) 4648 9000
MACKAY (07) 4567 6700 CAIRNS (07) 4252 3400
veris.com.au
ACN 615 735 727
Veris Australia Pty Ltd

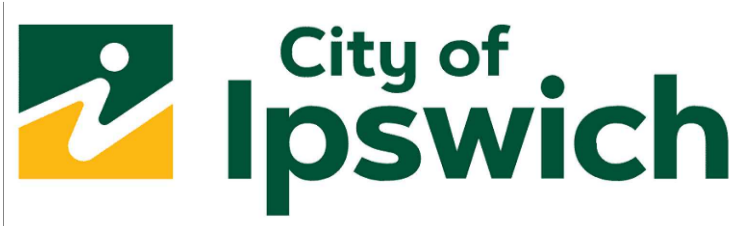

IPSWICH CITY COUNCIL

BRENTWOOD STAGE 8
AS CONSTRUCTED
DRAINAGE

SCALE	1:250 @A1
SHEET	5 OF 5 SHEETS
DRAWING NO.	400891-ASW08
	F
	E
	D
	C
	B