


521  
SL10720

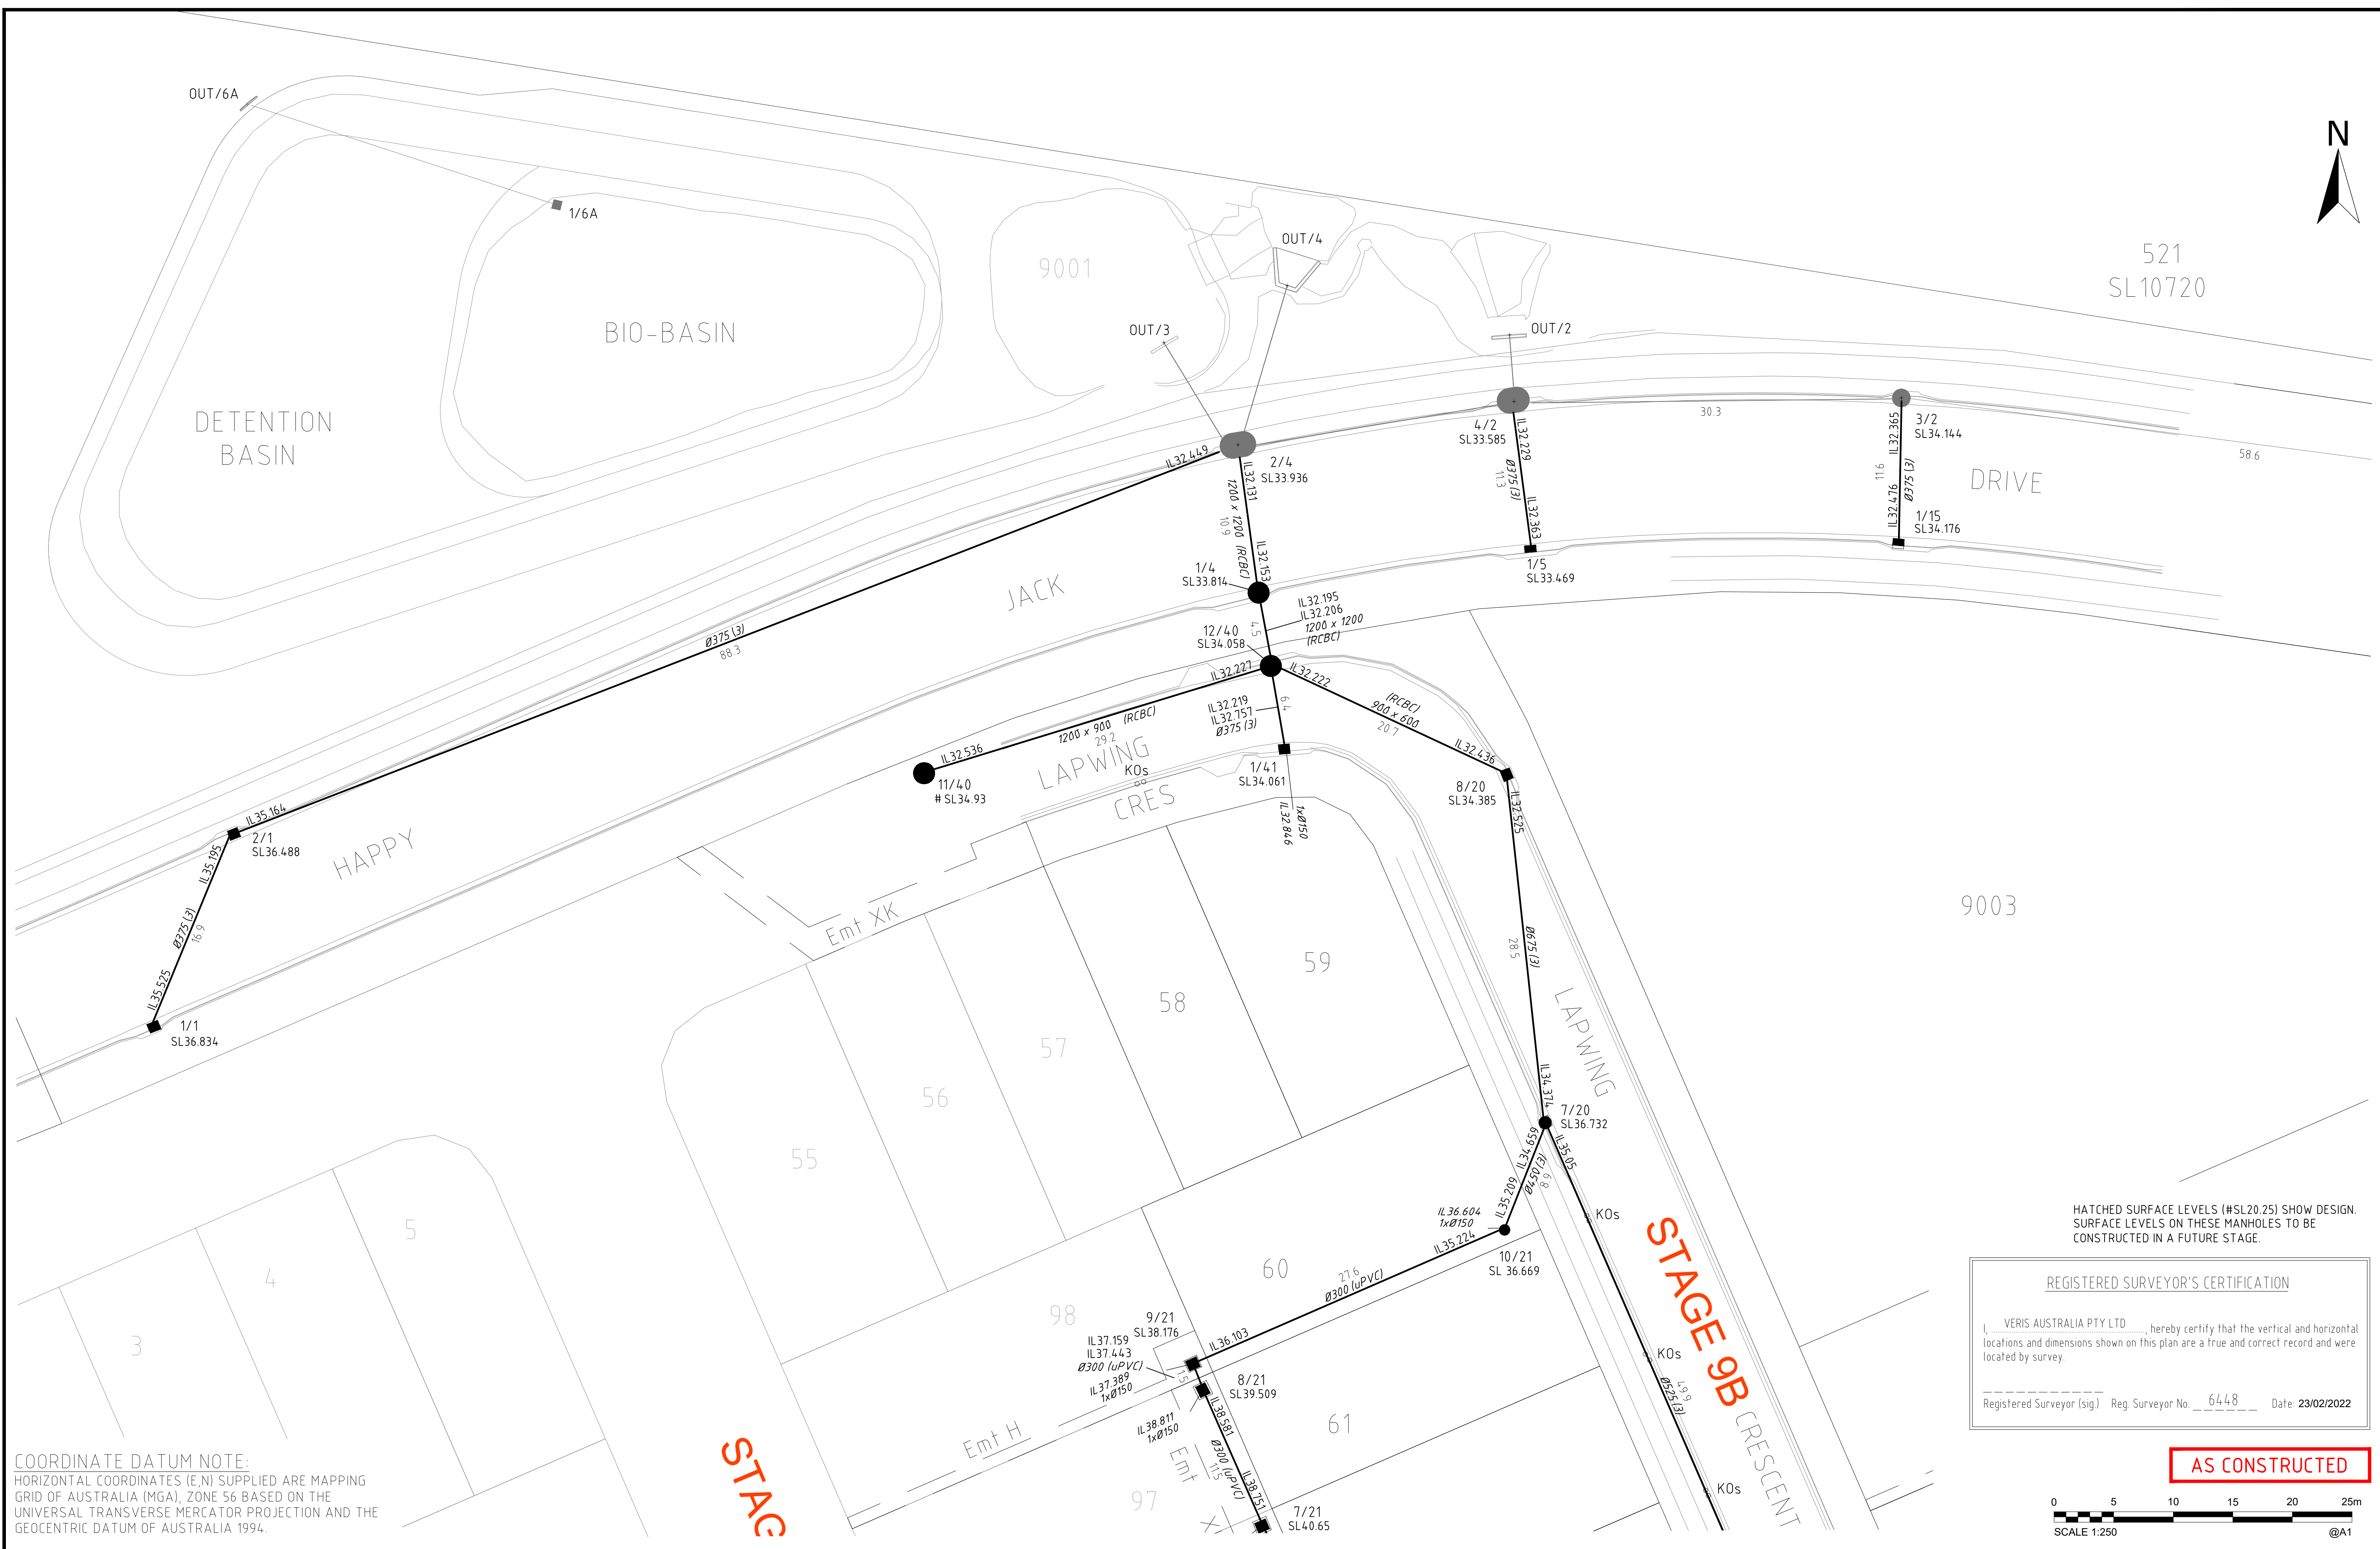


COORDINATE DATUM NOTE:  
HORIZONTAL COORDINATES (E,N) SUPPLIED ARE MAPPING GRID OF AUSTRALIA (MGA), ZONE 56 BASED ON THE UNIVERSAL TRANSVERSE MERCATOR PROJECTION AND THE GEOCENTRIC DATUM OF AUSTRALIA 1994.

HATCHED SURFACE LEVELS (#SL20.25) SHOW DESIGN. SURFACE LEVELS ON THESE MANHOLES TO BE CONSTRUCTED IN A FUTURE STAGE.

REGISTERED SURVEYOR'S CERTIFICATION  
I, VERIS AUSTRALIA PTY LTD, hereby certify that the vertical and horizontal locations and dimensions shown on this plan are a true and correct record and were located by survey.  
Registered Surveyor (sig.) Reg. Surveyor No. 6448 Date: 23/02/2022

AS CONSTRUCTED

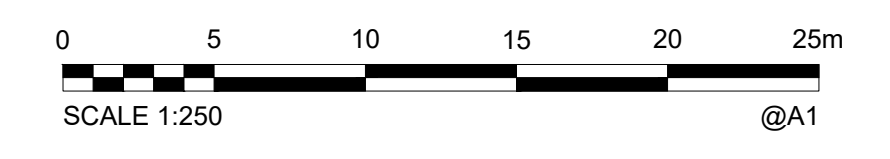

A1	D	22/02/2022	PROGRESS PLOT	GJF		
	C	17/02/2022	PROGRESS PLOT	GJF		
	B	02/02/2022	PROGRESS PLOT	GJF		
	A	27/01/2022	PROGRESS PLOT	GJF		
	INDEX	DATE	REVISIONS	DRAWN	CHECKED	PASSED

DRAWN	GJF	27/01/2022
CHECKED		
PASSED		
INITIALS		DATE

**veris**  
BRISBANE (07) 3664 4700 WHITSUNDAYS (07) 4945 0000  
MACKAY (07) 4957 9700 CAIRNS (07) 4252 9400  
www.veris.com.au  
ACN 616 736 727  
Veris Australia Pty Ltd



IPSWICH CITY COUNCIL

BRENTWOOD STAGE 9  
AS CONSTRUCTED  
DRAINAGE

SCALE	1:250 @A1
SHEET	4 OF 4 SHEETS
DRAWING NO.	400891-ASW09
	D
	C
	B
	A