




COORDINATE DATUM NOTE:
 HORIZONTAL COORDINATES (E,N) SUPPLIED ARE MAPPING GRID OF AUSTRALIA (MGA), ZONE 56 BASED ON THE UNIVERSAL TRANSVERSE MERCATOR PROJECTION AND THE GEOCENTRIC DATUM OF AUSTRALIA 2020.

REGISTERED SURVEYOR'S CERTIFICATION

I, **VERIS AUSTRALIA PTY LTD**, hereby certify that the vertical and horizontal locations and dimensions shown on this plan are a true and correct record and were located by survey.

Registered Surveyor (sig.) Reg. Surveyor No. **6448** Date: **03/11/2022**

AS CONSTRUCTED

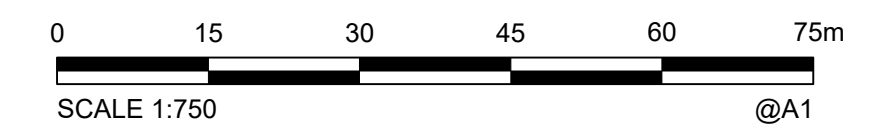

A1	C	03/11/2022	FINAL DRAINAGE PLOT	JH		
	B	20/10/2022	PROGRESS PLOT	JMc		
	A	05/04/2022	PROGRESS PLOT	JMc		
	INDEX	DATE	REVISIONS	DRAWN	CHECKED	PASSED

DRAWN	JMc	05/10/2022
CHECKED	JH	03/11/2022
PASSED		
INITIALS		DATE


veris BRISBANE (07) 3668 4700 WHITSUNDAYS (07) 4945 6600
 MACKAY (07) 4691 8700 CAIRNS (07) 4522 3400
 veris.com.au
 ACN 615 735 727
 Veris Australia Pty Ltd



IPSWICH CITY COUNCIL

BRENTWOOD STAGE 11
 AS CONSTRUCTED
 DRAINAGE

SCALE	1:750 @A1
SHEET	1 OF 4 SHEETS
DRAWING NO.	400891-ASW11
	B
	A

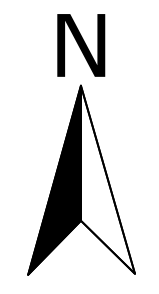


REGISTERED SURVEYOR'S CERTIFICATION

I, **VERIS AUSTRALIA PTY LTD**, hereby certify that the vertical and horizontal locations and dimensions shown on this plan are a true and correct record and were located by survey.

Alistair Byrom
Registered Surveyor (sig.) Reg. Surveyor No. **6448** Date: **03/11/2022**

COORDINATE DATUM NOTE:
HORIZONTAL COORDINATES (E,N) SUPPLIED ARE MAPPING GRID OF AUSTRALIA (MGA), ZONE 56 BASED ON THE UNIVERSAL TRANSVERSE MERCATOR PROJECTION AND THE GEOCENTRIC DATUM OF AUSTRALIA 2020.

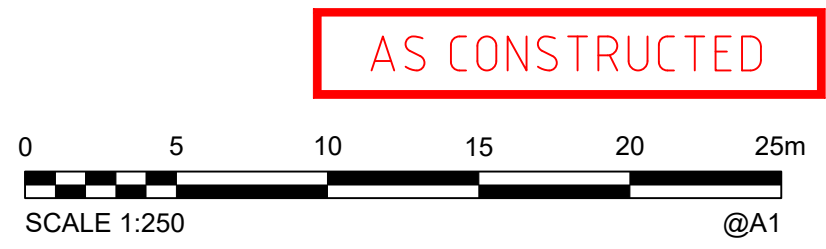

AS CONSTRUCTED

A1	C	03/11/2022	FINAL DRAINAGE PLOT	JH		
	B	20/10/2022	PROGRESS PLOT	JMc		
	A	05/10/2022	PROGRESS PLOT	JMc		
	INDEX	DATE	REVISIONS	DRAWN	CHECKED	PASSED

DRAWN	JMc	05/10/2022
CHECKED	JH	03/11/2022
PASSED		
INITIALS		DATE

veris

BRISBANE (07) 3664 4700
MACKAY (07) 461 9700
WHITSUNDAYS (07) 4945 9600
CAIRNS (07) 4522 3400
veris.com.au
ACN 615 735 727
Veris Australia Pty Ltd



IPSWICH CITY COUNCIL

BRENTWOOD STAGE 11
AS CONSTRUCTED
DRAINAGE

SCALE	1:250 @A1
SHEET	2 OF 4 SHEETS
DRAWING NO.	400891-ASW11
	C
	B
	A



9004




REGISTERED SURVEYOR'S CERTIFICATION

I, **VERIS AUSTRALIA PTY LTD**, hereby certify that the vertical and horizontal locations and dimensions shown on this plan are a true and correct record and were located by survey.

Alistair Bayson
Registered Surveyor (sig.) Reg. Surveyor No. **6448** Date: 03/11/2022

COORDINATE DATUM NOTE:
HORIZONTAL COORDINATES (E.N) SUPPLIED ARE MAPPING GRID OF AUSTRALIA (MGA), ZONE 56 BASED ON THE UNIVERSAL TRANSVERSE MERCATOR PROJECTION AND THE GEOCENTRIC DATUM OF AUSTRALIA 2020.

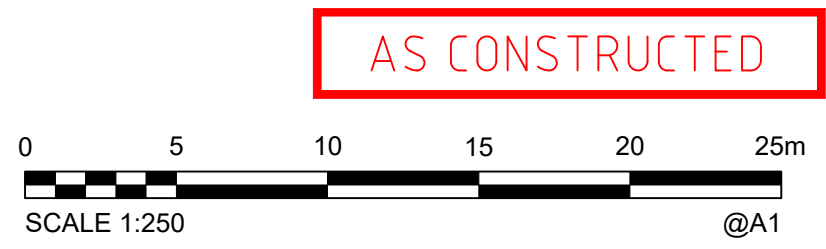

A1	C	03/11/2022	FINAL DRAINAGE PLOT	JH		
	B	20/10/2022	PROGRESS PLOT	JMc		
	A	05/10/2022	PROGRESS PLOT	JMc		
	INDEX	DATE	REVISIONS	DRAWN	CHECKED	PASSED

DRAWN	JMc	05/10/2022
CHECKED	JH	03/11/2022
PASSED		
INITIALS		DATE

veris

BRISBANE (07) 3664 4700 WHITSUNDAYS (07) 4945 9600
MACKAY (07) 491 9700 CAIRNS (07) 4022 3400
veris.com.au
ACN 615 735 727
Veris Australia Pty Ltd



IPSWICH CITY COUNCIL

BRENTWOOD STAGE 11
AS CONSTRUCTED
DRAINAGE

SCALE	1:250 @A1
SHEET	3 OF 4 SHEETS
DRAWING NO.	400891-ASW11
	C B A




Lot 511
SP276300

REGISTERED SURVEYOR'S CERTIFICATION
 I, **VERIS AUSTRALIA PTY LTD**, hereby certify that the vertical and horizontal locations and dimensions shown on this plan are a true and correct record and were located by survey.
Alistair Byrom
 Registered Surveyor (sig.) Reg. Surveyor No. **6448** Date: **03/11/2022**

COORDINATE DATUM NOTE:
 HORIZONTAL COORDINATES (E,N) SUPPLIED ARE MAPPING GRID OF AUSTRALIA (MGA), ZONE 56 BASED ON THE UNIVERSAL TRANSVERSE MERCATOR PROJECTION AND THE GEOCENTRIC DATUM OF AUSTRALIA 2020.

AS CONSTRUCTED

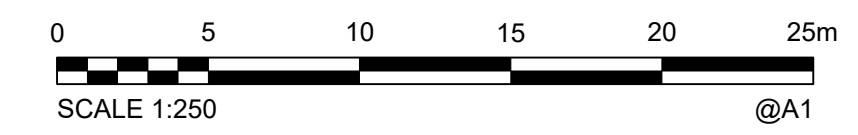

A1	C	03/11/2022	FINAL DRAINAGE PLOT	JH		
	B	20/10/2022	PROGRESS PLOT	JMc		
	A	05/04/2022	PROGRESS PLOT	JMc		
	INDEX	DATE	REVISIONS	DRAWN	CHECKED	PASSED

DRAWN	JMc	05/10/2022
CHECKED	JH	03/11/2022
PASSED		
INITIALS		DATE

veris
 BRISBANE (07) 3668 4700 WHITSUNDAYS (07) 4945 9600
 MACKAY (07) 4951 9700 CAIRNS (07) 4522 3400
 veris.com.au
 ACN 615 735 727
 Veris Australia Pty Ltd



IPSWICH CITY COUNCIL

BRENTWOOD STAGE 11
 AS CONSTRUCTED
 DRAINAGE

SCALE	1:250 @A1
SHEET	4 OF 4 SHEETS
DRAWING NO.	400891-ASW11
	C
	B
	A