




COORDINATE DATUM NOTE:
 HORIZONTAL COORDINATES (E,N) SUPPLIED ARE MAPPING
 GRID OF AUSTRALIA (MGA), ZONE 56 BASED ON THE
 UNIVERSAL TRANSVERSE MERCATOR PROJECTION AND THE
 GEOCENTRIC DATUM OF AUSTRALIA 2020.

REGISTERED SURVEYOR'S CERTIFICATION

I, **VERIS AUSTRALIA PTY LTD**, hereby certify that the vertical and horizontal
 locations and dimensions shown on this plan are a true and correct record and were
 located by survey.

Alastair Byrom
 Registered Surveyor (sig) Reg. Surveyor No. **6448** Date: 03/11/2022

AS CONSTRUCTED

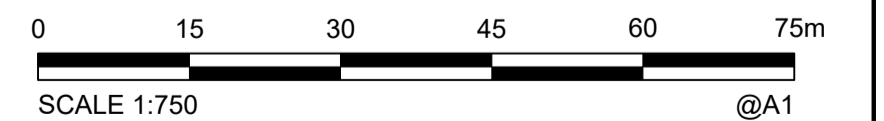

A1

INDEX	DATE	REVISIONS	DRAWN	CHECKED	PASSED
C	03/11/2022	FINAL DRAINAGE PLOT	JH		
B	20/10/2022	PROGRESS PLOT	JMc		
A	05/04/2022	PROGRESS PLOT	JMc		

INITIALS	DATE
DRAWN JMc	05/10/2022
CHECKED JH	03/11/2022
PASSED	

veris
 BRISBANE (07) 3668 4700 WHITSUNDAYS (07) 4945 6600
 MACKAY (07) 4611 3000 CAIRNS (07) 4122 3400
 veris.com.au
 ACN 615 735 727
 Veris Australia Pty Ltd



IPSWICH CITY COUNCIL

BRENTWOOD STAGE 11
 AS CONSTRUCTED
 DRAINAGE

SCALE	1:750 @A1
SHEET 1 OF 4 SHEETS	
DRAWING NO.	
400891-ASW11	




REGISTERED SURVEYOR'S CERTIFICATION

I, **VERIS AUSTRALIA PTY LTD**, hereby certify that the vertical and horizontal locations and dimensions shown on this plan are a true and correct record and were located by survey.

Alistair Byrom
Registered Surveyor (sig.) Reg. Surveyor No. **6448** Date: **03/11/2022**

COORDINATE DATUM NOTE:
HORIZONTAL COORDINATES (E,N) SUPPLIED ARE MAPPING GRID OF AUSTRALIA (MGA), ZONE 56 BASED ON THE UNIVERSAL TRANSVERSE MERCATOR PROJECTION AND THE GEOCENTRIC DATUM OF AUSTRALIA 2020.

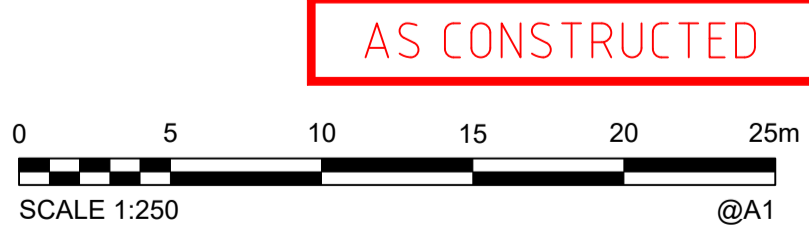

A1	C	03/11/2022	FINAL DRAINAGE PLOT	JH		
	B	20/10/2022	PROGRESS PLOT	JMc		
	A	05/10/2022	PROGRESS PLOT	JMc		
	INDEX	DATE	REVISIONS	DRAWN	CHECKED	PASSED

DRAWN	JMc	05/10/2022
CHECKED	JH	03/11/2022
PASSED		
INITIALS		DATE

veris

BRISBANE (07) 3664 4700 WHITSUNDAYS (07) 4945 9600
MACKAY (07) 4941 9700 CAIRNS (07) 4522 3400
veris.com.au
ACN 615 735 727
Veris Australia Pty Ltd



IPSWICH CITY COUNCIL

BRENTWOOD STAGE 11
AS CONSTRUCTED
DRAINAGE

SCALE	1:250 @A1
SHEET	2 OF 4 SHEETS
DRAWING NO.	400891-ASW11
	C B A



9004



REGISTERED SURVEYOR'S CERTIFICATION

I, **VERIS AUSTRALIA PTY LTD**, hereby certify that the vertical and horizontal locations and dimensions shown on this plan are a true and correct record and were located by survey.

Alistair Bayson
Registered Surveyor (sig.) Reg. Surveyor No. **6448** Date: **03/11/2022**

COORDINATE DATUM NOTE:
HORIZONTAL COORDINATES (E.N) SUPPLIED ARE MAPPING GRID OF AUSTRALIA (MGA), ZONE 56 BASED ON THE UNIVERSAL TRANSVERSE MERCATOR PROJECTION AND THE GEOCENTRIC DATUM OF AUSTRALIA 2020.



A1	C	03/11/2022	FINAL DRAINAGE PLOT	JH		
	B	20/10/2022	PROGRESS PLOT	JMc		
	A	05/10/2022	PROGRESS PLOT	JMc		
	INDEX	DATE	REVISIONS	DRAWN	CHECKED	PASSED

DRAWN	CHECKED	DATE
JMc	JH	05/10/2022
		03/11/2022
PASSED		
INITIALS	DATE	

veris
BRISBANE (07) 3664 4700 WHITSUNDAYS (07) 4945 9600
MACKAY (07) 491 9700 CAIRNS (07) 4322 3400
veris.com.au
ACN 615 735 727
Veris Australia Pty Ltd



IPSWICH CITY COUNCIL

BRENTWOOD STAGE 11
AS CONSTRUCTED
DRAINAGE

SCALE	1:250 @A1
SHEET	3 OF 4 SHEETS
DRAWING NO.	400891-ASW11
	C
	B
	A




Lot 511
SP276300

REGISTERED SURVEYOR'S CERTIFICATION
 I, **VERIS AUSTRALIA PTY LTD**, hereby certify that the vertical and horizontal locations and dimensions shown on this plan are a true and correct record and were located by survey.
Alistair Byrom
 Registered Surveyor (sig.) Reg. Surveyor No. **6448** Date: **03/11/2022**

COORDINATE DATUM NOTE:
 HORIZONTAL COORDINATES (E,N) SUPPLIED ARE MAPPING GRID OF AUSTRALIA (MGA), ZONE 56 BASED ON THE UNIVERSAL TRANSVERSE MERCATOR PROJECTION AND THE GEOCENTRIC DATUM OF AUSTRALIA 2020.

AS CONSTRUCTED

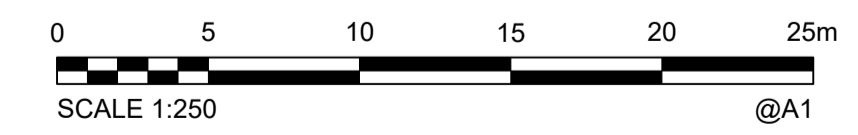

A1	C	03/11/2022	FINAL DRAINAGE PLOT	JH		
	B	20/10/2022	PROGRESS PLOT	JMc		
	A	05/04/2022	PROGRESS PLOT	JMc		
	INDEX	DATE	REVISIONS	DRAWN	CHECKED	PASSED

DRAWN	JMc	05/10/2022
CHECKED	JH	03/11/2022
PASSED		
INITIALS		DATE

veris
 BRISBANE (07) 3668 4700 WHITSUNDAYS (07) 4945 9600
 MACKAY (07) 4951 9700 CAIRNS (07) 4522 3400
 veris.com.au
 ACN 615 735 727
 Veris Australia Pty Ltd



IPSWICH CITY COUNCIL

BRENTWOOD STAGE 11
 AS CONSTRUCTED
 DRAINAGE

SCALE	1:250 @A1
SHEET	4 OF 4 SHEETS
DRAWING NO.	400891-ASW11
	C
	B
	A