




REGISTERED SURVEYOR'S CERTIFICATION


I, VERIS AUSTRALIA PTY LTD, hereby certify that the vertical and horizontal locations and dimensions shown on this plan are a true and correct record and were located by survey.

*Alistair Byron*  
Reg Surveyor Delegate Reg. Surveyor No. 6448 Date: 07/11/2022

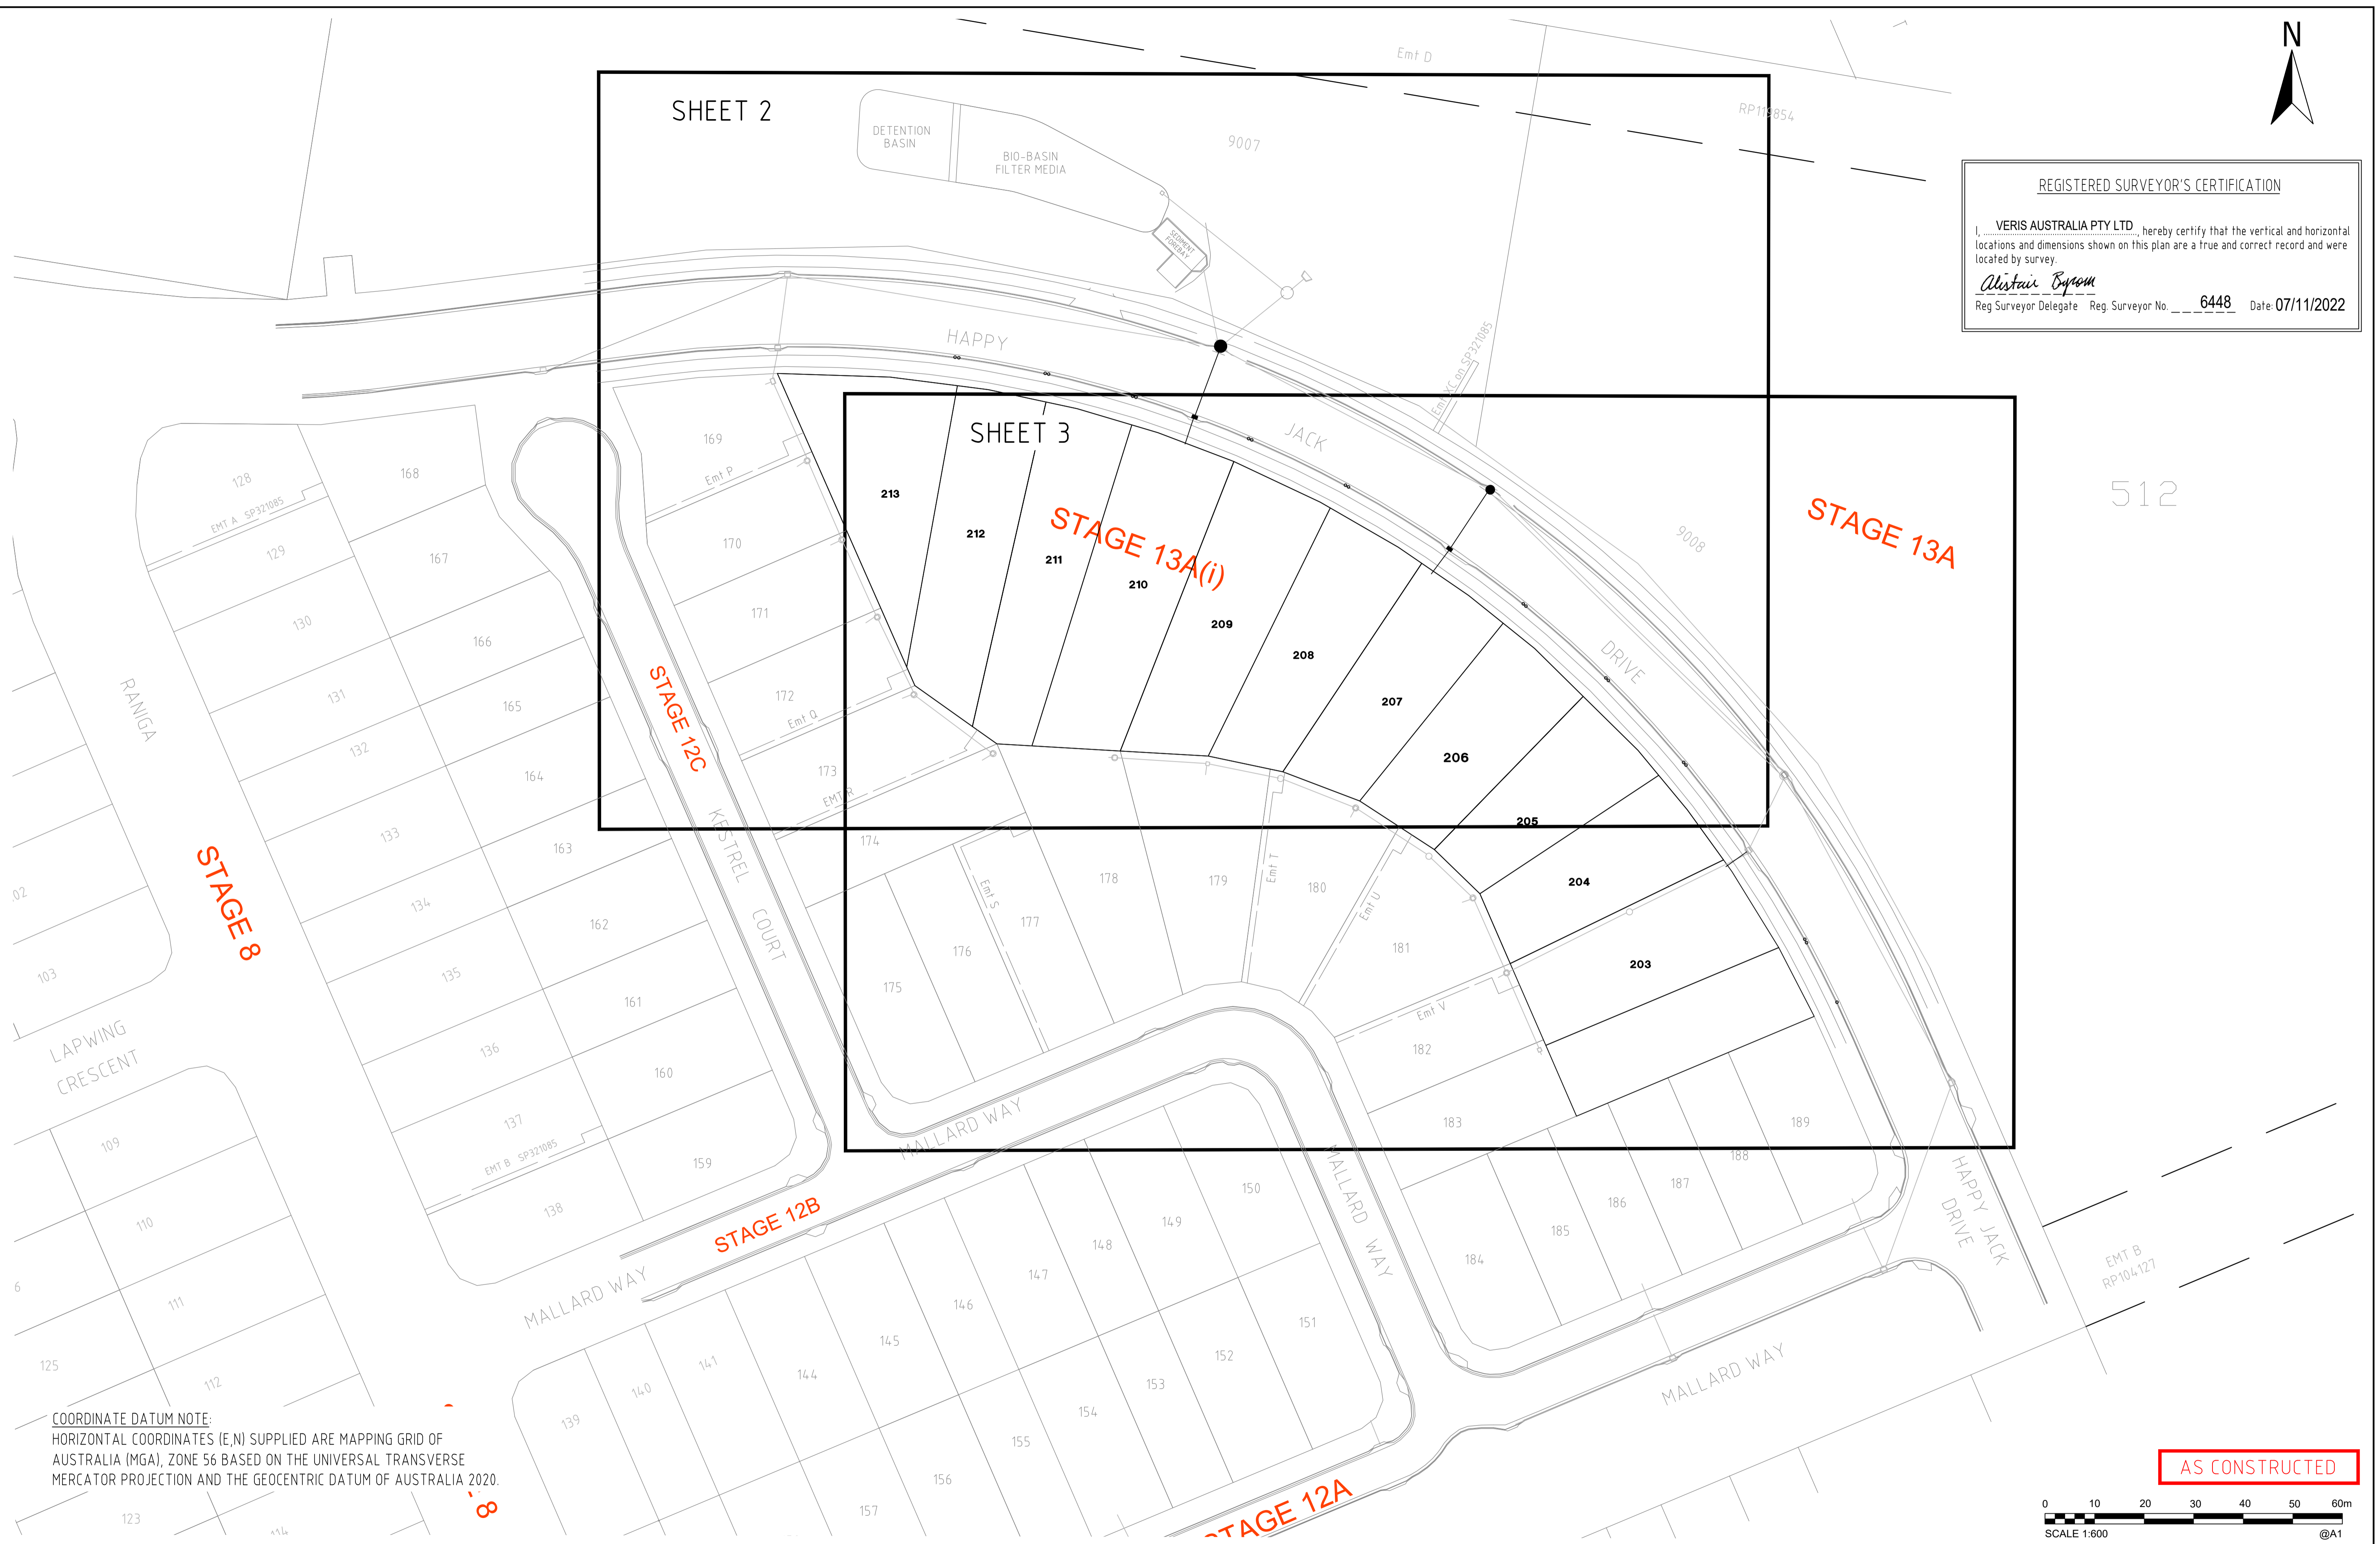

COORDINATE DATUM NOTE:  
HORIZONTAL COORDINATES (E,N) SUPPLIED ARE MAPPING GRID OF AUSTRALIA (MGA), ZONE 56 BASED ON THE UNIVERSAL TRANSVERSE MERCATOR PROJECTION AND THE GEOCENTRIC DATUM OF AUSTRALIA 2020.

AS CONSTRUCTED

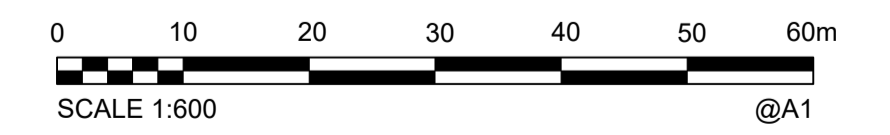

A1

INDEX	DATE	REVISIONS	DRAWN	CHECKED	PASSED
A	01/11/2022	FINAL DRAINAGE PLOT	JMc		

DRAWN	INITIALS	DATE
JMc		01/11/2022
JH		07/11/2022

**veris**  
BRISBANE (07) 3666 4700 WHITSUNDAYS (07) 4945 9600  
MACKAY (07) 4661 9700 CAIRNS (07) 4522 3400  
veris.com.au  
ACN 615 735 727  
Veris Australia Pty Ltd



IPSWICH CITY COUNCIL

BRENTWOOD STAGE 13  
AS CONSTRUCTED  
DRAINAGE


SCALE	SHEET	DRAWING NO.
1:600 @A1	1 OF 3 SHEETS	400891-ASW13

**REGISTERED SURVEYOR'S CERTIFICATION**

I, **VERIS AUSTRALIA PTY LTD**, hereby certify that the vertical and horizontal locations and dimensions shown on this plan are a true and correct record and were located by survey.

*Alistair Byrom*  
 Reg Surveyor Delegate Reg. Surveyor No. **6448** Date: **07/11/2022**

**COORDINATE DATUM NOTE:**  
 HORIZONTAL COORDINATES (E,N) SUPPLIED ARE MAPPING GRID OF AUSTRALIA (MGA), ZONE 56 BASED ON THE UNIVERSAL TRANSVERSE MERCATOR PROJECTION AND THE GEOCENTRIC DATUM OF AUSTRALIA 2020.

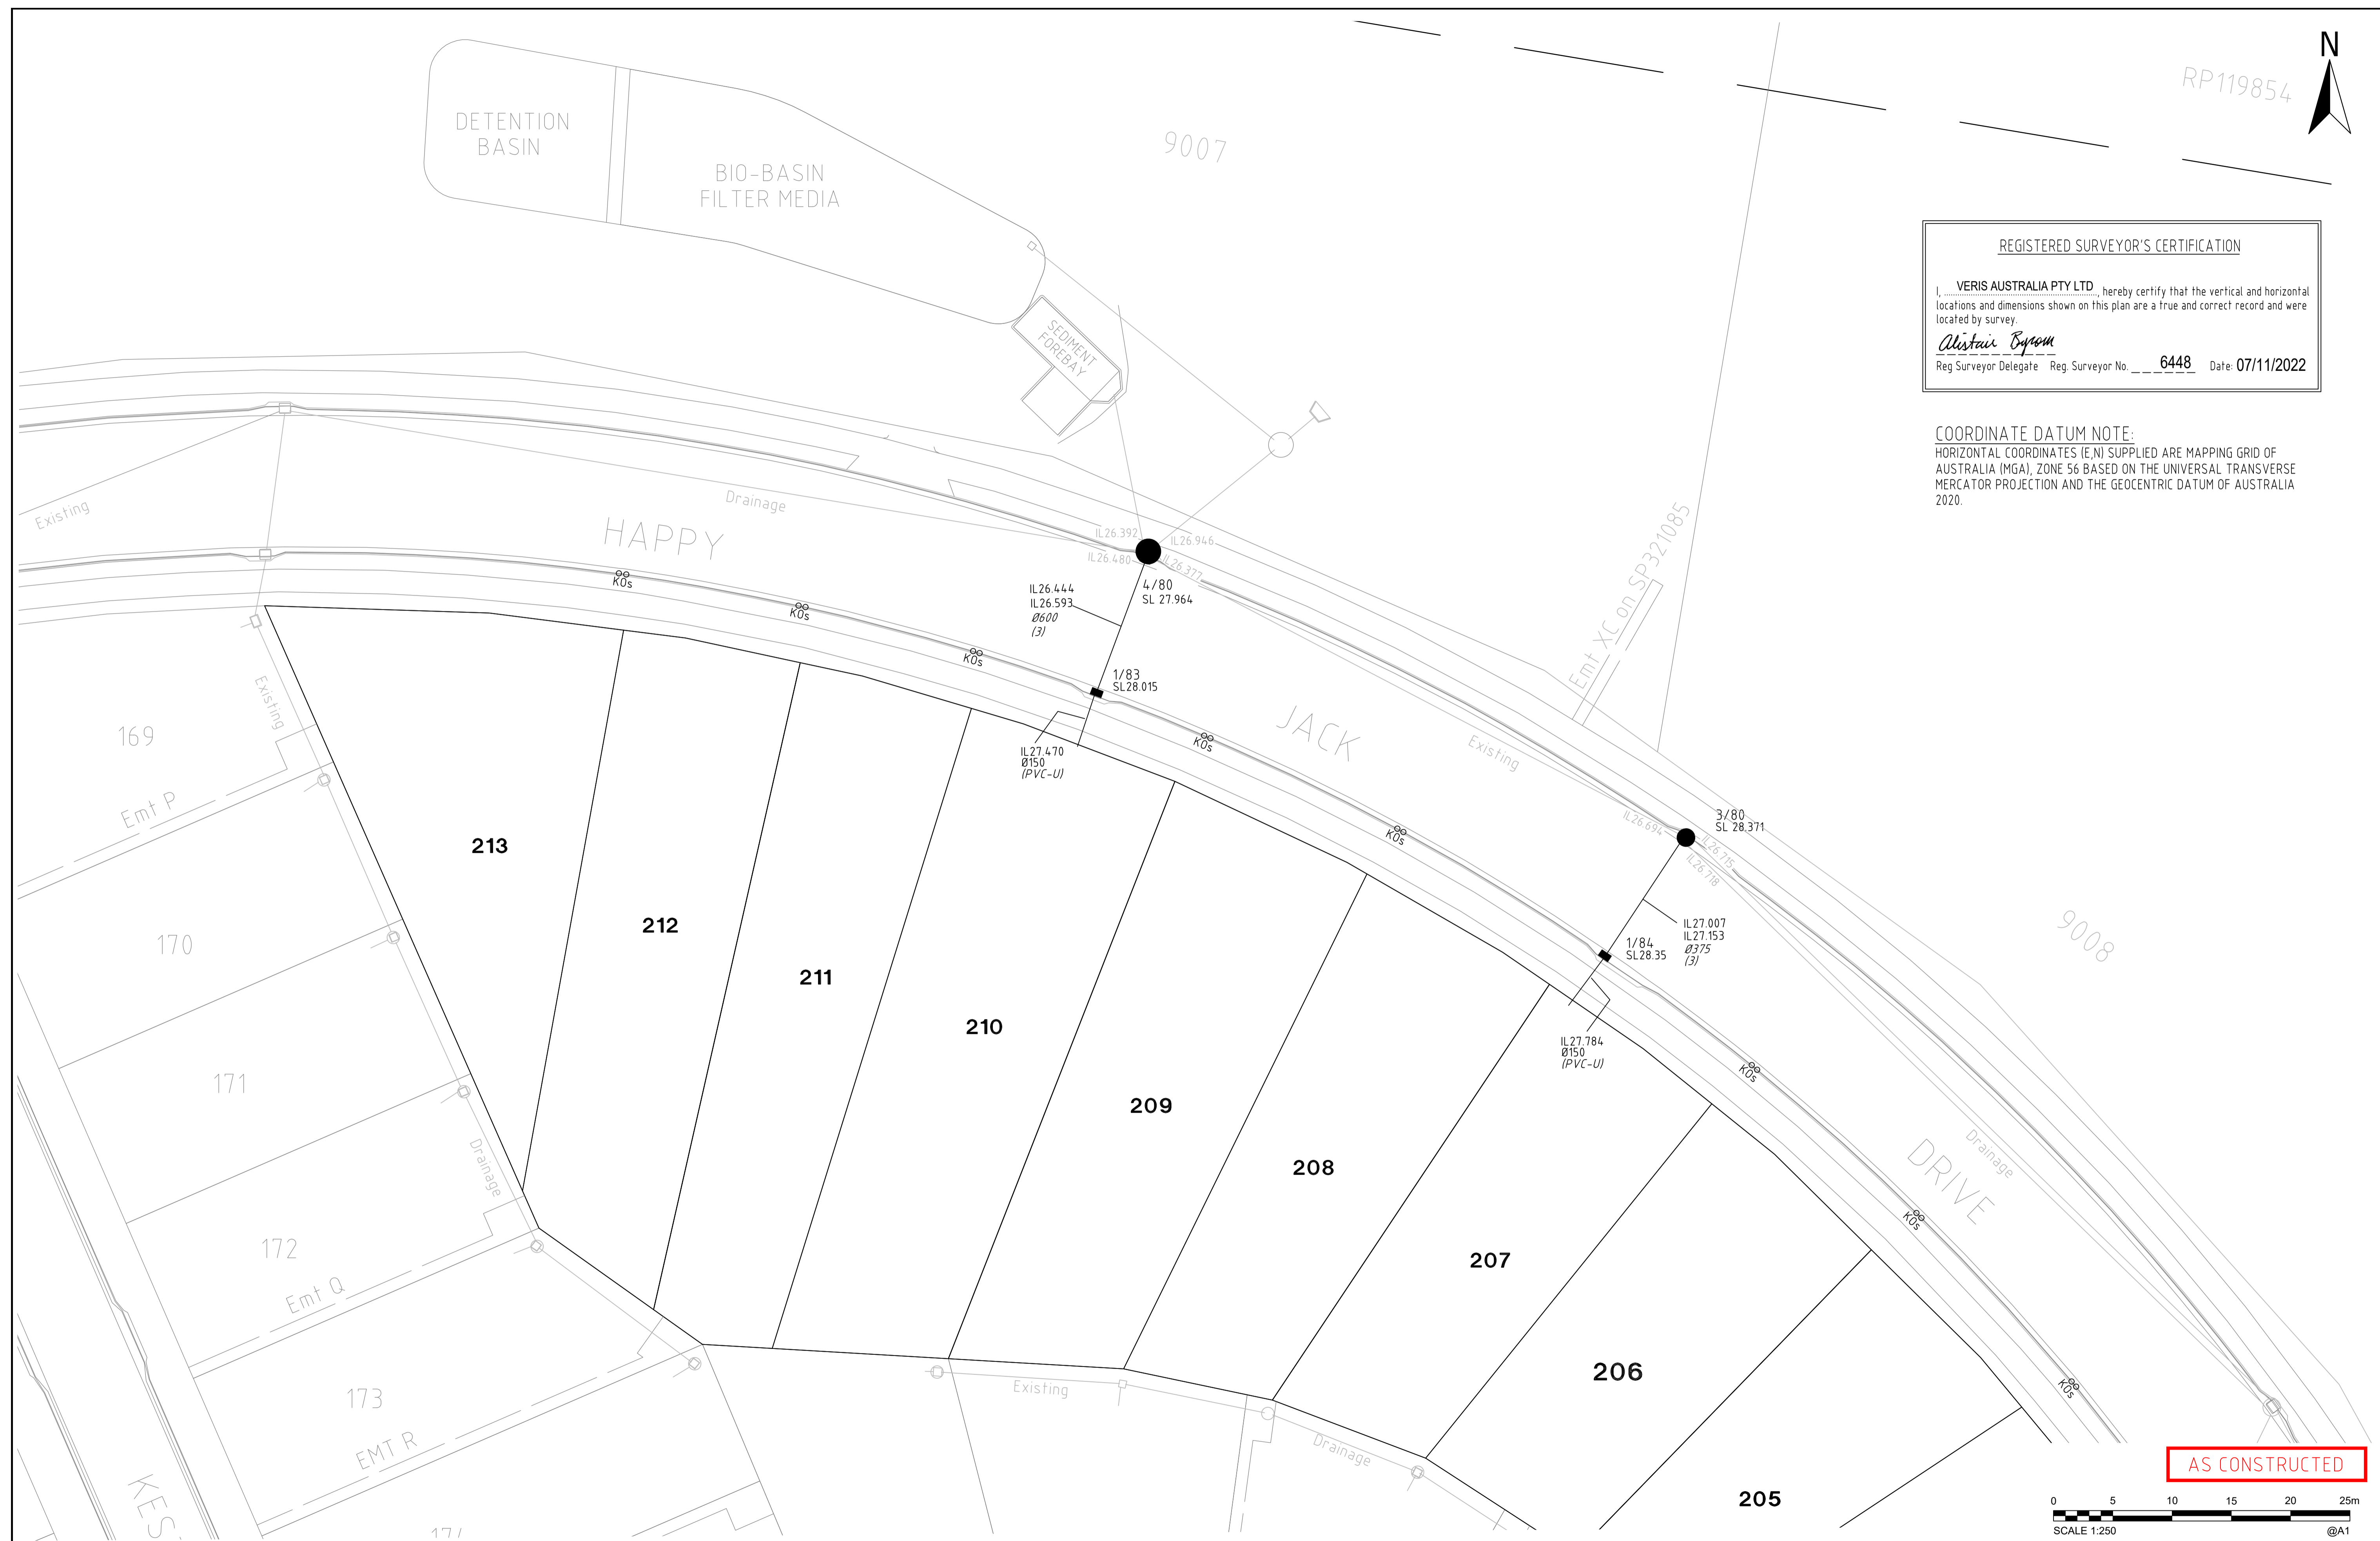


<b>A1</b>						
	A	01/11/2022	FINAL DRAINAGE PLOT	JMC		
	INDEX	DATE	REVISIONS	DRAWN	CHECKED	PASSED

DRAWN	JMC	01/11/2022
CHECKED	JH	07/11/2022
PASSED		
INITIALS		DATE

**veris**


BRISBANE (07) 3668 4700 WHITSUNDAYS (07) 4945 6600  
 MACKAY (07) 4951 9700 CAIRNS (07) 4522 3400  
 veris.com.au  
 ACN 615 735 727  
 Veris Australia Pty Ltd

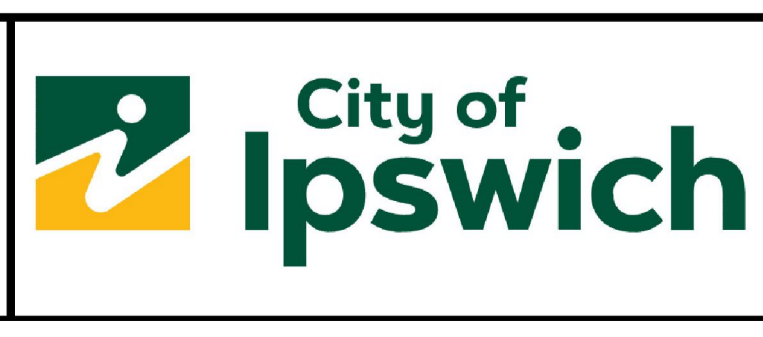

**IPSWICH CITY COUNCIL**

BRENTWOOD STAGE 13  
 AS CONSTRUCTED  
 DRAINAGE

SCALE	1:250 @A1
SHEET	2 OF 3 SHEETS
DRAWING NO.	400891-ASW13

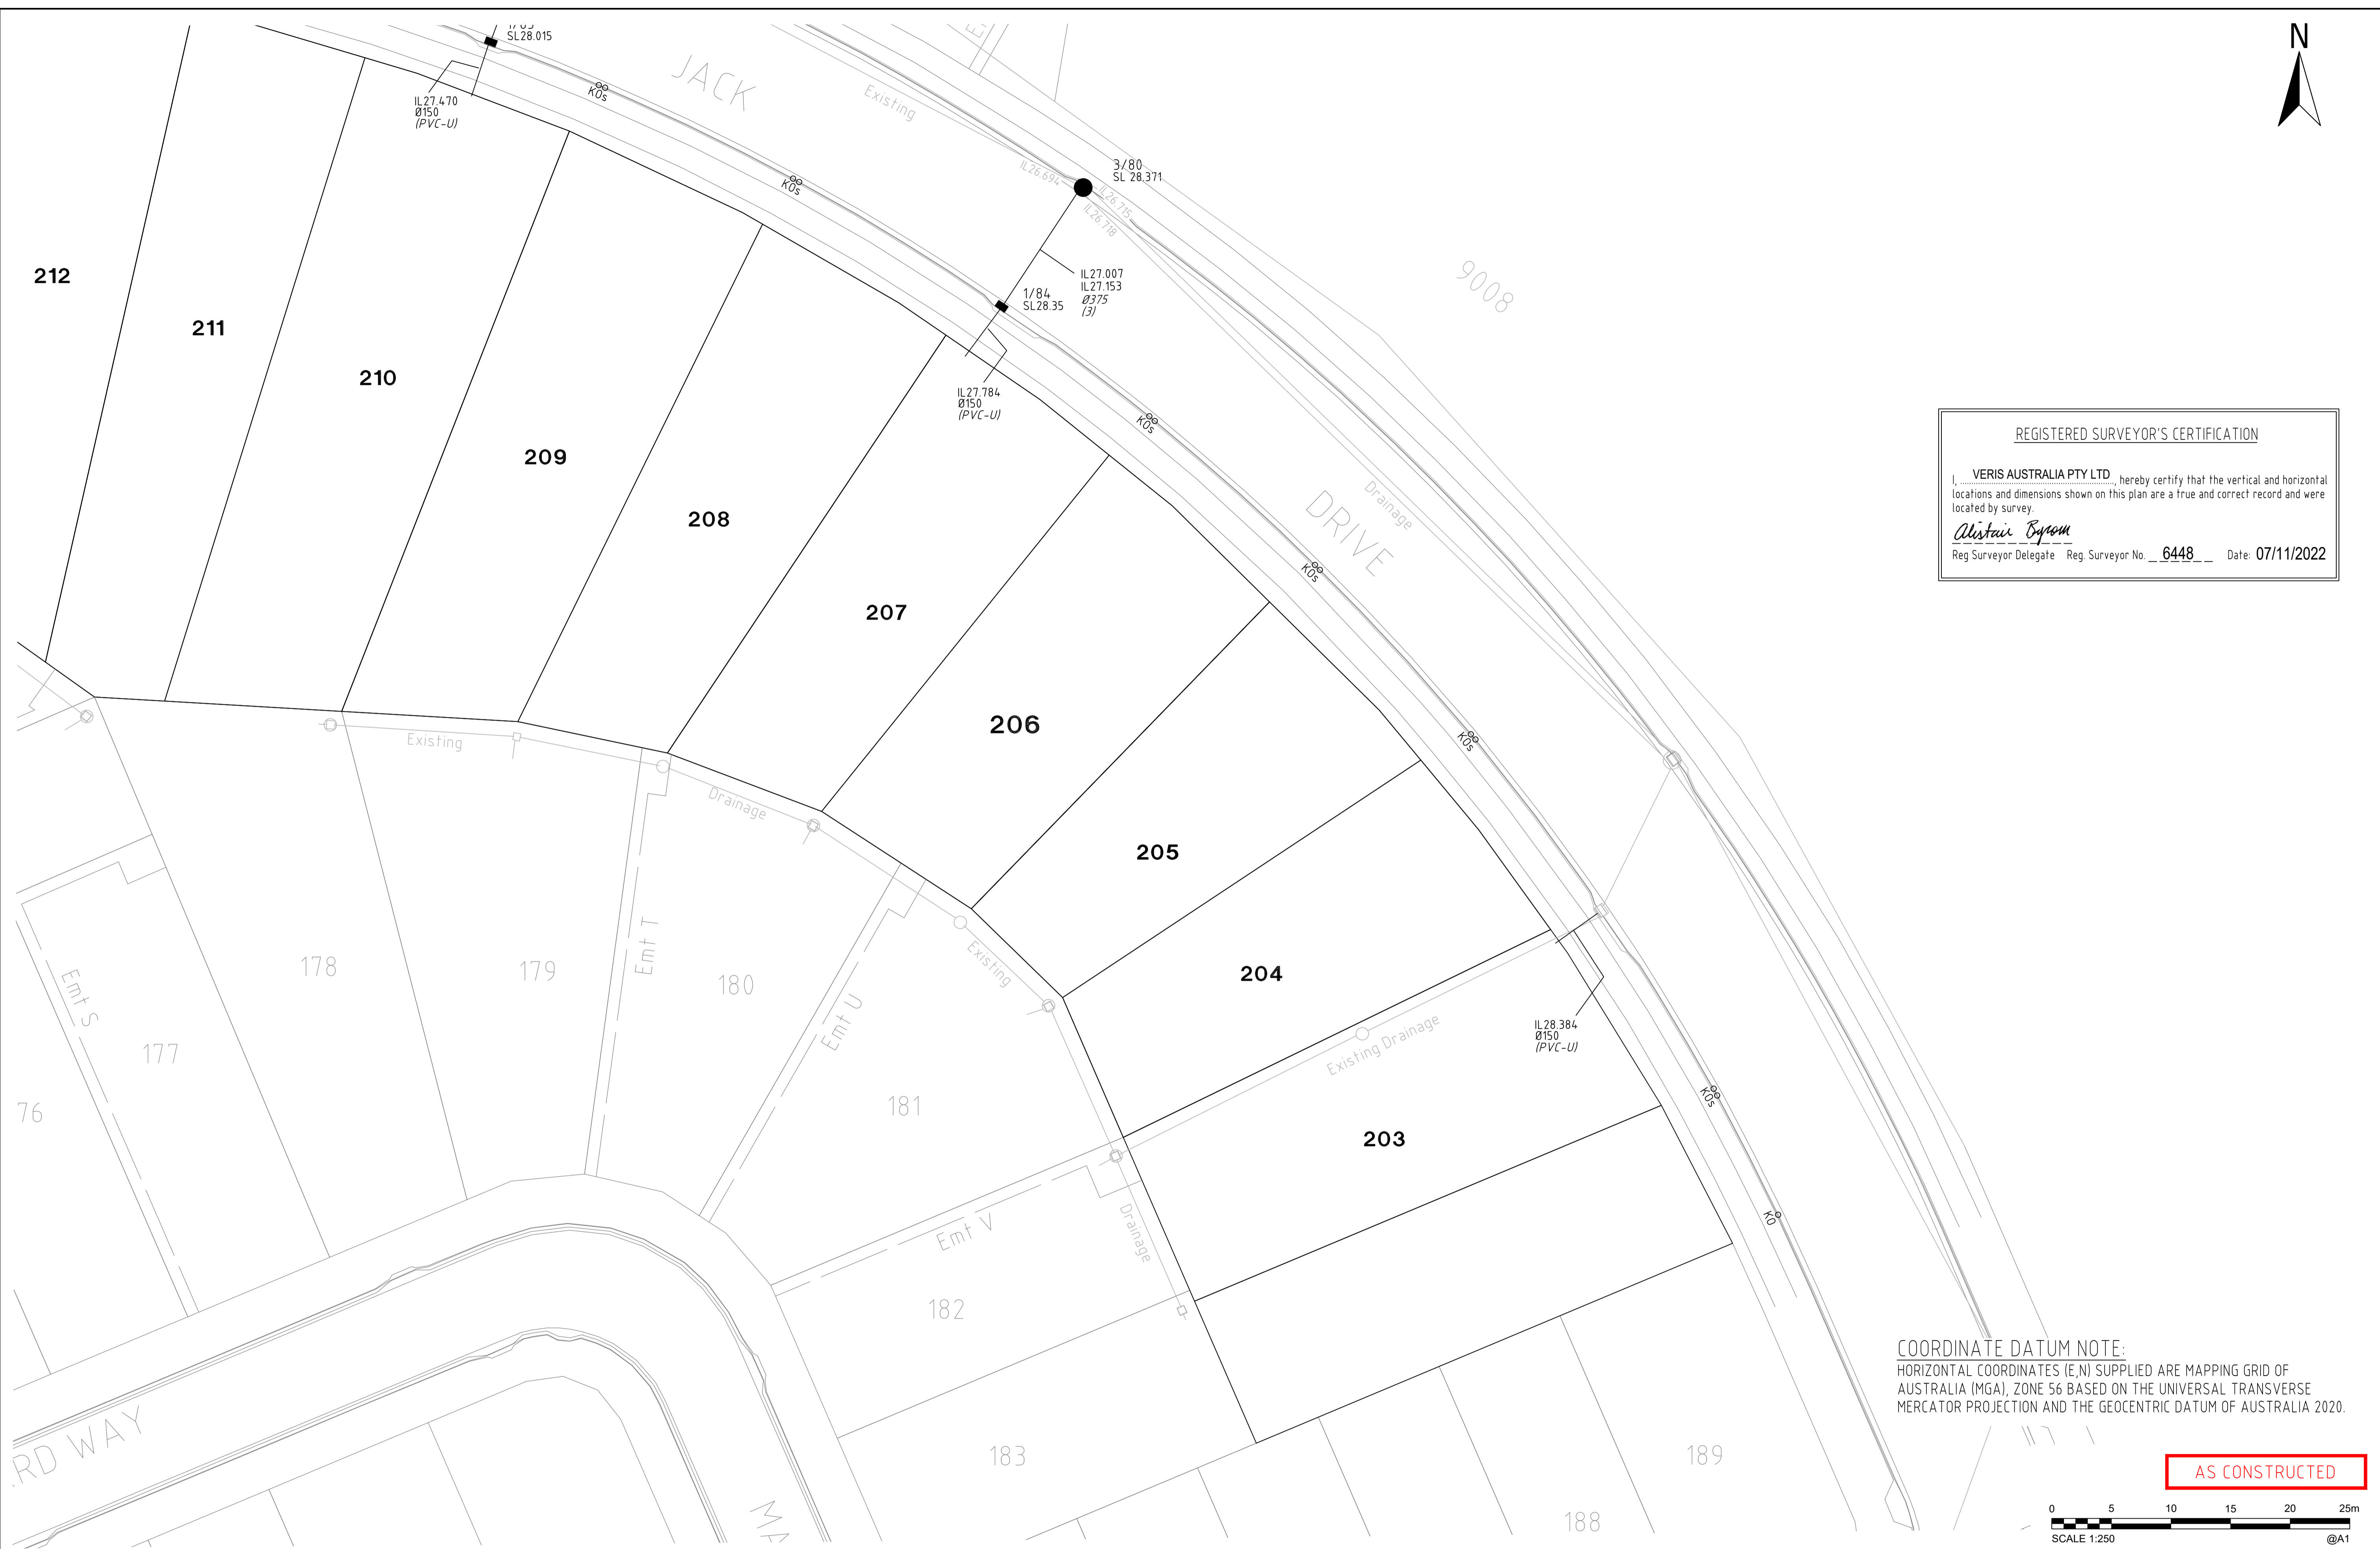

**REGISTERED SURVEYOR'S CERTIFICATION**

I, **VERIS AUSTRALIA PTY LTD**, hereby certify that the vertical and horizontal locations and dimensions shown on this plan are a true and correct record and were located by survey.

*Alister Byron*  
Reg Surveyor Delegate Reg. Surveyor No. **6448** Date: **07/11/2022**

**COORDINATE DATUM NOTE:**  
HORIZONTAL COORDINATES (E,N) SUPPLIED ARE MAPPING GRID OF AUSTRALIA (MGA), ZONE 56 BASED ON THE UNIVERSAL TRANSVERSE MERCATOR PROJECTION AND THE GEOCENTRIC DATUM OF AUSTRALIA 2020.

**AS CONSTRUCTED**



<b>A1</b>	INDEX	DATE	REVISIONS	DRAWN	CHECKED	PASSED
	A	01/11/2022	FINAL DRAINAGE PLOT	JMc		

DRAWN	JMc	01/11/2022
CHECKED	JH	07/11/2022
PASSED		
INITIALS		DATE

**veris**  
BRISBANE (07) 3664 4700 WHITSUNDAYS (07) 4945 9600  
MACKAY (07) 4911 9700 CAIRNS (07) 4102 3400  
veris.com.au  
ACN 615 735 727  
Veris Australia Pty Ltd



**IPSWICH CITY COUNCIL**

BRENTWOOD STAGE 13  
AS CONSTRUCTED  
DRAINAGE

SCALE	1:250 @A1
SHEET	3 OF 3 SHEETS
DRAWING NO.	400891-ASW13