


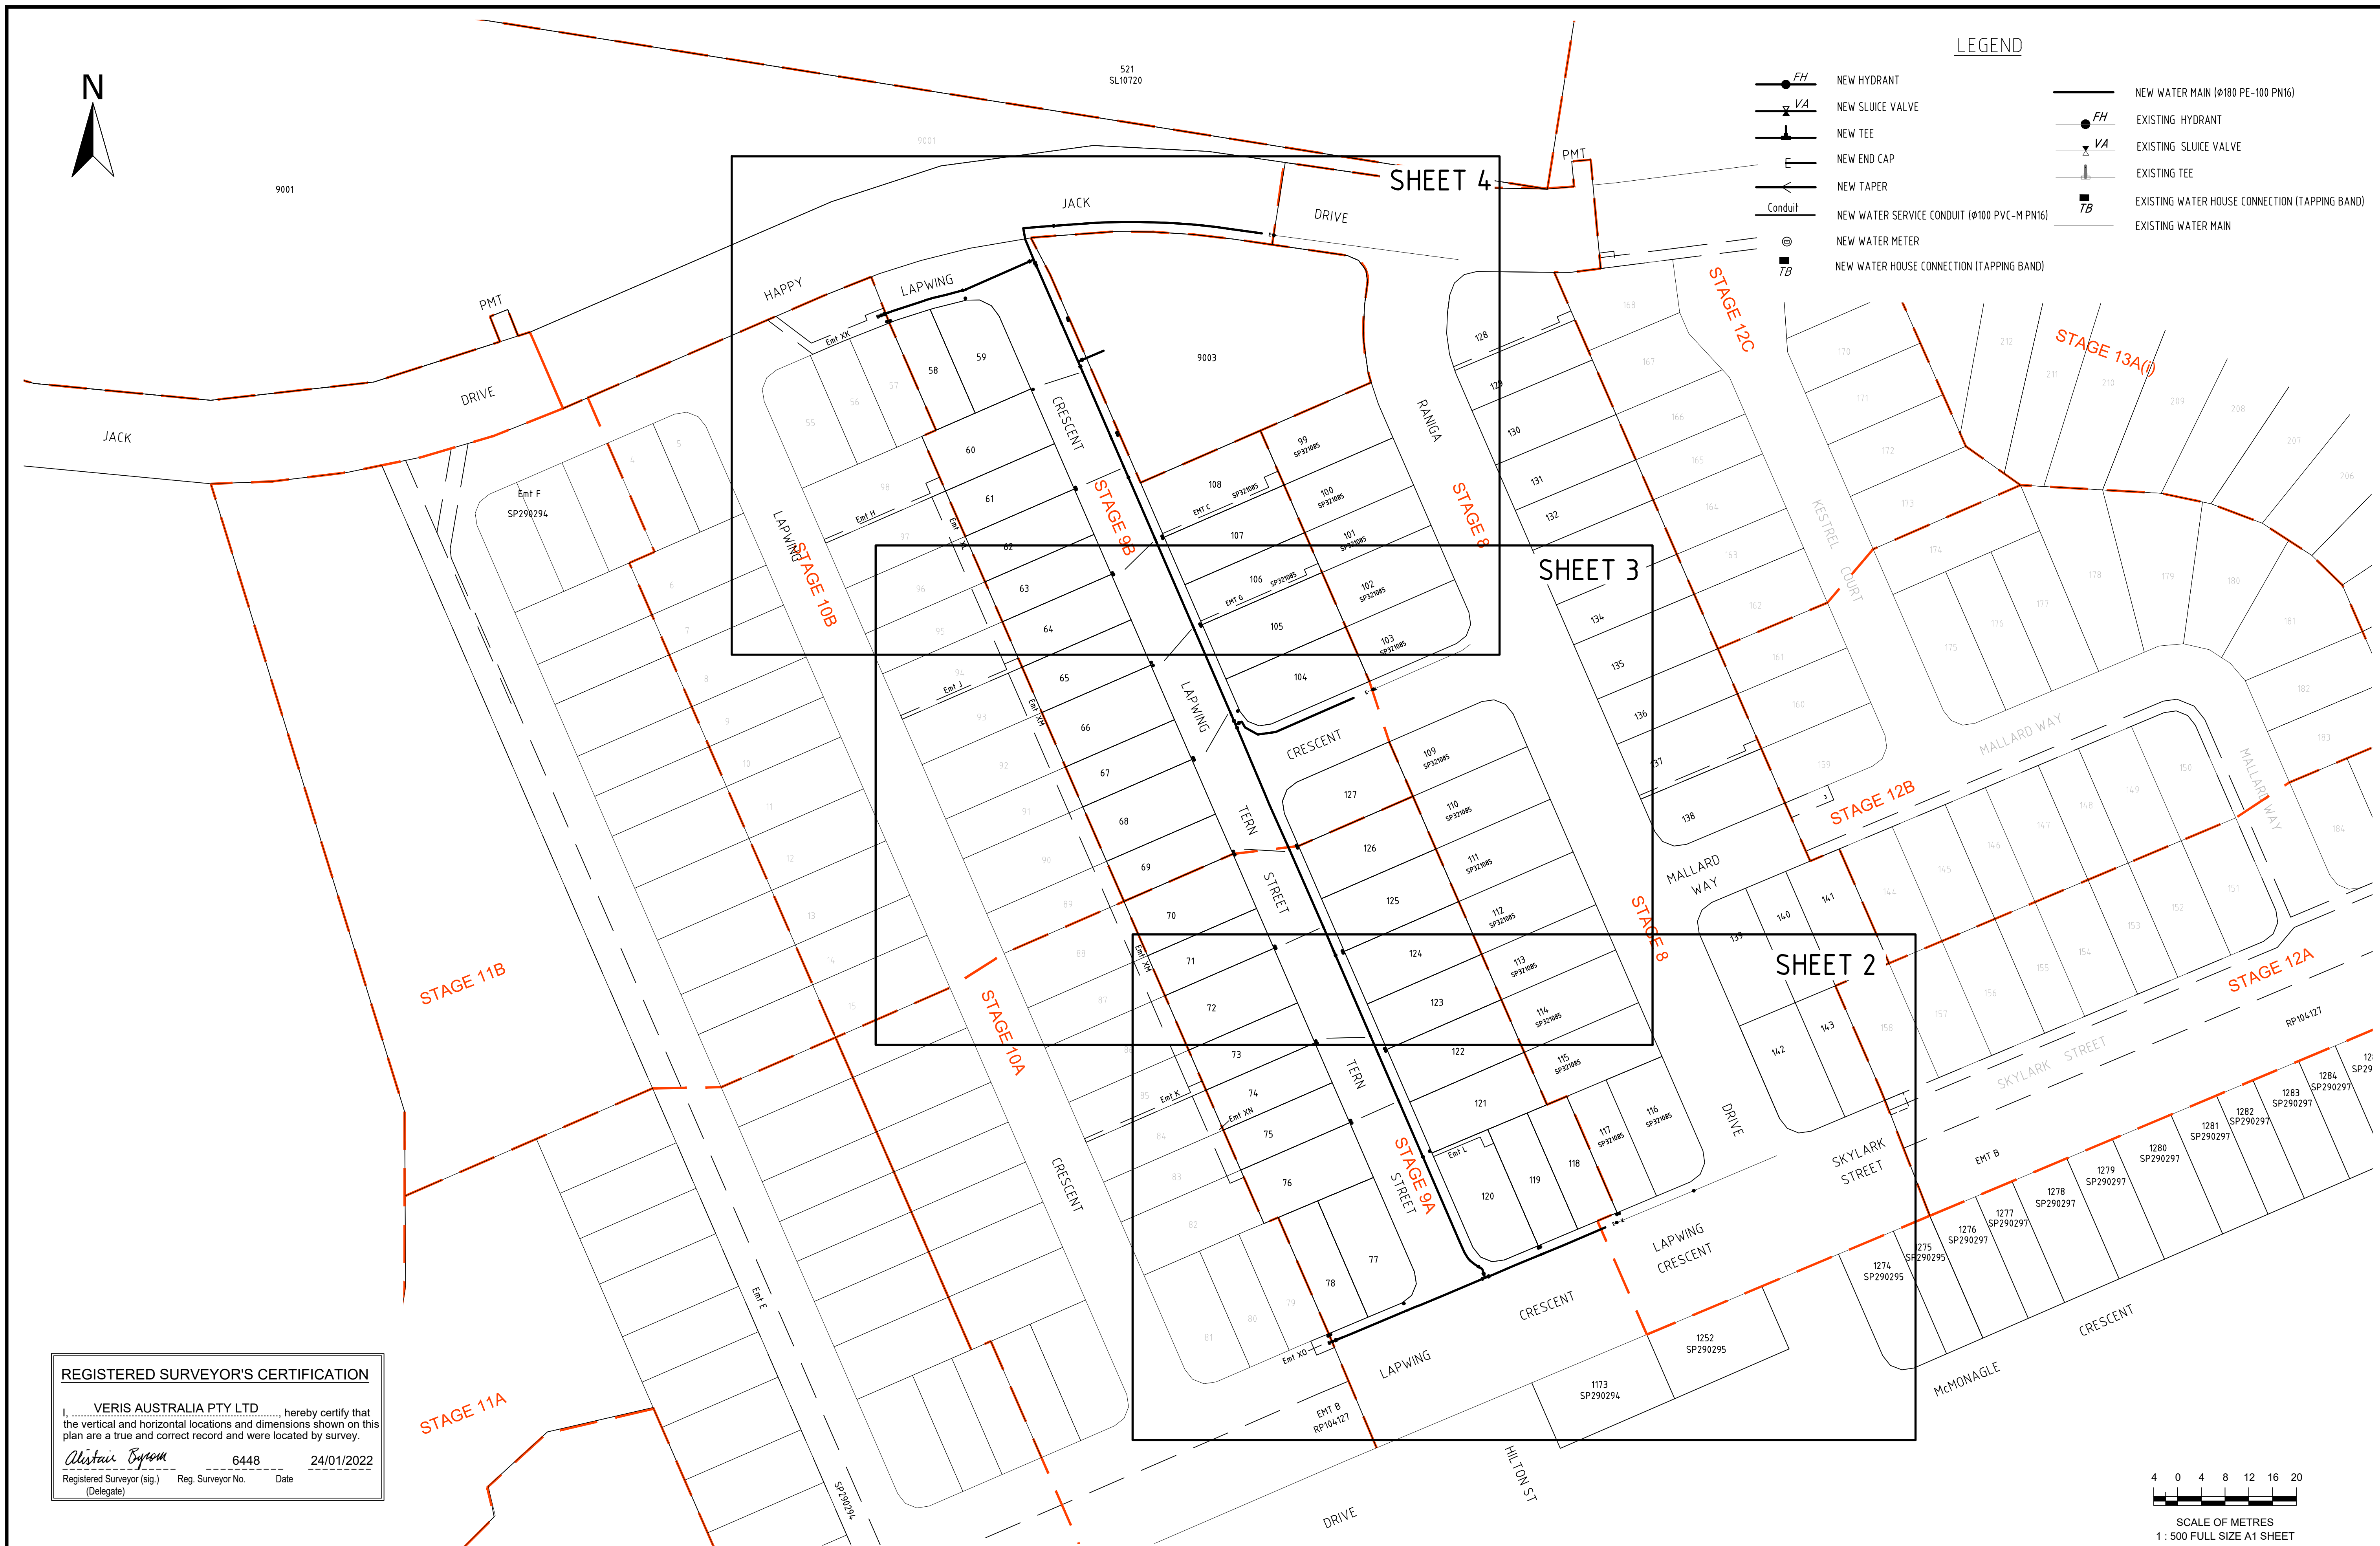

A1	C	24/01/2022	FINAL	MJT	DRAWN	JMc	16/11/2021	
	B	14/12/2021	PROGRESS PLOT	GJF	CHECKED	MJT	16/11/2021	
	A	16/11/2021	PROGRESS PLOT	JMc	APPROVED			
	REV NO	DATE	REVISION PURPOSE / DESCRIPTION	DRAWN	RPEQ	RPEQ No	INITIALS	DATE

BRISBANE (07) 3566 4700 **WHITSUNDAYS** (07) 4945 6000
MACKAY (07) 495 9100 **CAIRNS** (07) 4332 8400
[veris.com.au](#)
 ACN 615 735 727
 Veris Australia Pty Ltd

BRENTWOOD FOREST
 7000 Jones Road, Bellbird Park

AS CONSTRUCTED WATER STAGE 9 WATER

DRAWING STATUS	
<u>AS CONSTRUCTED</u>	
SHEET 1 OF 4 SHEETS	
DRAWING NO. 400891-AW09	REV. C





LEGEND

- | | | | |
|--|---|--|--|
| | NEW HYDRANT | | EXISTING HYDRANT |
| | NEW SLUIICE VALVE | | EXISTING SLUIICE VALVE |
| | NEW TEE | | EXISTING TEE |
| | NEW END CAP | | EXISTING WATER HOUSE CONNECTION (TAPPING BAND) |
| | NEW TAPER | | EXISTING WATER MAIN |
| | NEW WATER SERVICE CONDUIT (ø100 PVC-M PN16) | | |
| | NEW WATER METER | | |
| | NEW WATER HOUSE CONNECTION (TAPPING BAND) | | |

REGISTERED SURVEYOR'S CERTIFICATION

I, VERIS AUSTRALIA PTY LTD hereby certify that the vertical and horizontal locations and dimensions shown on this plan are a true and correct record and were located by survey.

Alister Byrom 6448 24/01/2022
Registered Surveyor (sig.) Reg. Surveyor No. Date
(Delegate)

4 0 4 8 12 16 20
SCALE OF METRES
1 : 500 FULL SIZE A1 SHEET

A1

REV NO	DATE	REVISION PURPOSE / DESCRIPTION	DRAWN	RPEQ	RPEQ No	CHECKED	INITIALS	DATE
C	24/01/2022	FINAL	MJT			DRAWN	JMc	16/11/2021
B	14/12/2021	PROGRESS PLOT	GJF			CHECKED	MJT	16/11/2021
A	16/11/2021	PROGRESS PLOT	JMc			APPROVED		

BRISBANE WHITSUNDAYS
(07) 3068 6700 (07) 4945 0000
MACKAY CAIRNS
(07) 4957 9700 (07) 4252 9400
veris.com.au
ACN 615 735 727
Veris Australia Pty Ltd



BRENTWOOD FOREST
7000 Jones Road, Bellbird Park
AS CONSTRUCTED WATER STAGE 9
WATER

DRAWING STATUS
AS CONSTRUCTED
SHEET 4 OF 4 SHEETS
DRAWING NO. 400891-AW09
REV. C