










LEGEND

- NEW HYDRANT
- NEW SLUICE VALVE
- NEW TEE
- NEW END CAP
- NEW TAPER
- NEW WATER SERVICE CONDUIT (Ø100 PVC-M PN16)
- NEW WATER METER
- NEW WATER HOUSE CONNECTION (TAPPING BAND)
- EXISTING HYDRANT
- EXISTING SLUICE VALVE
- EXISTING TEE
- EXISTING WATER HOUSE CONNECTION (TAPPING BAND)
- EXISTING WATER MAIN

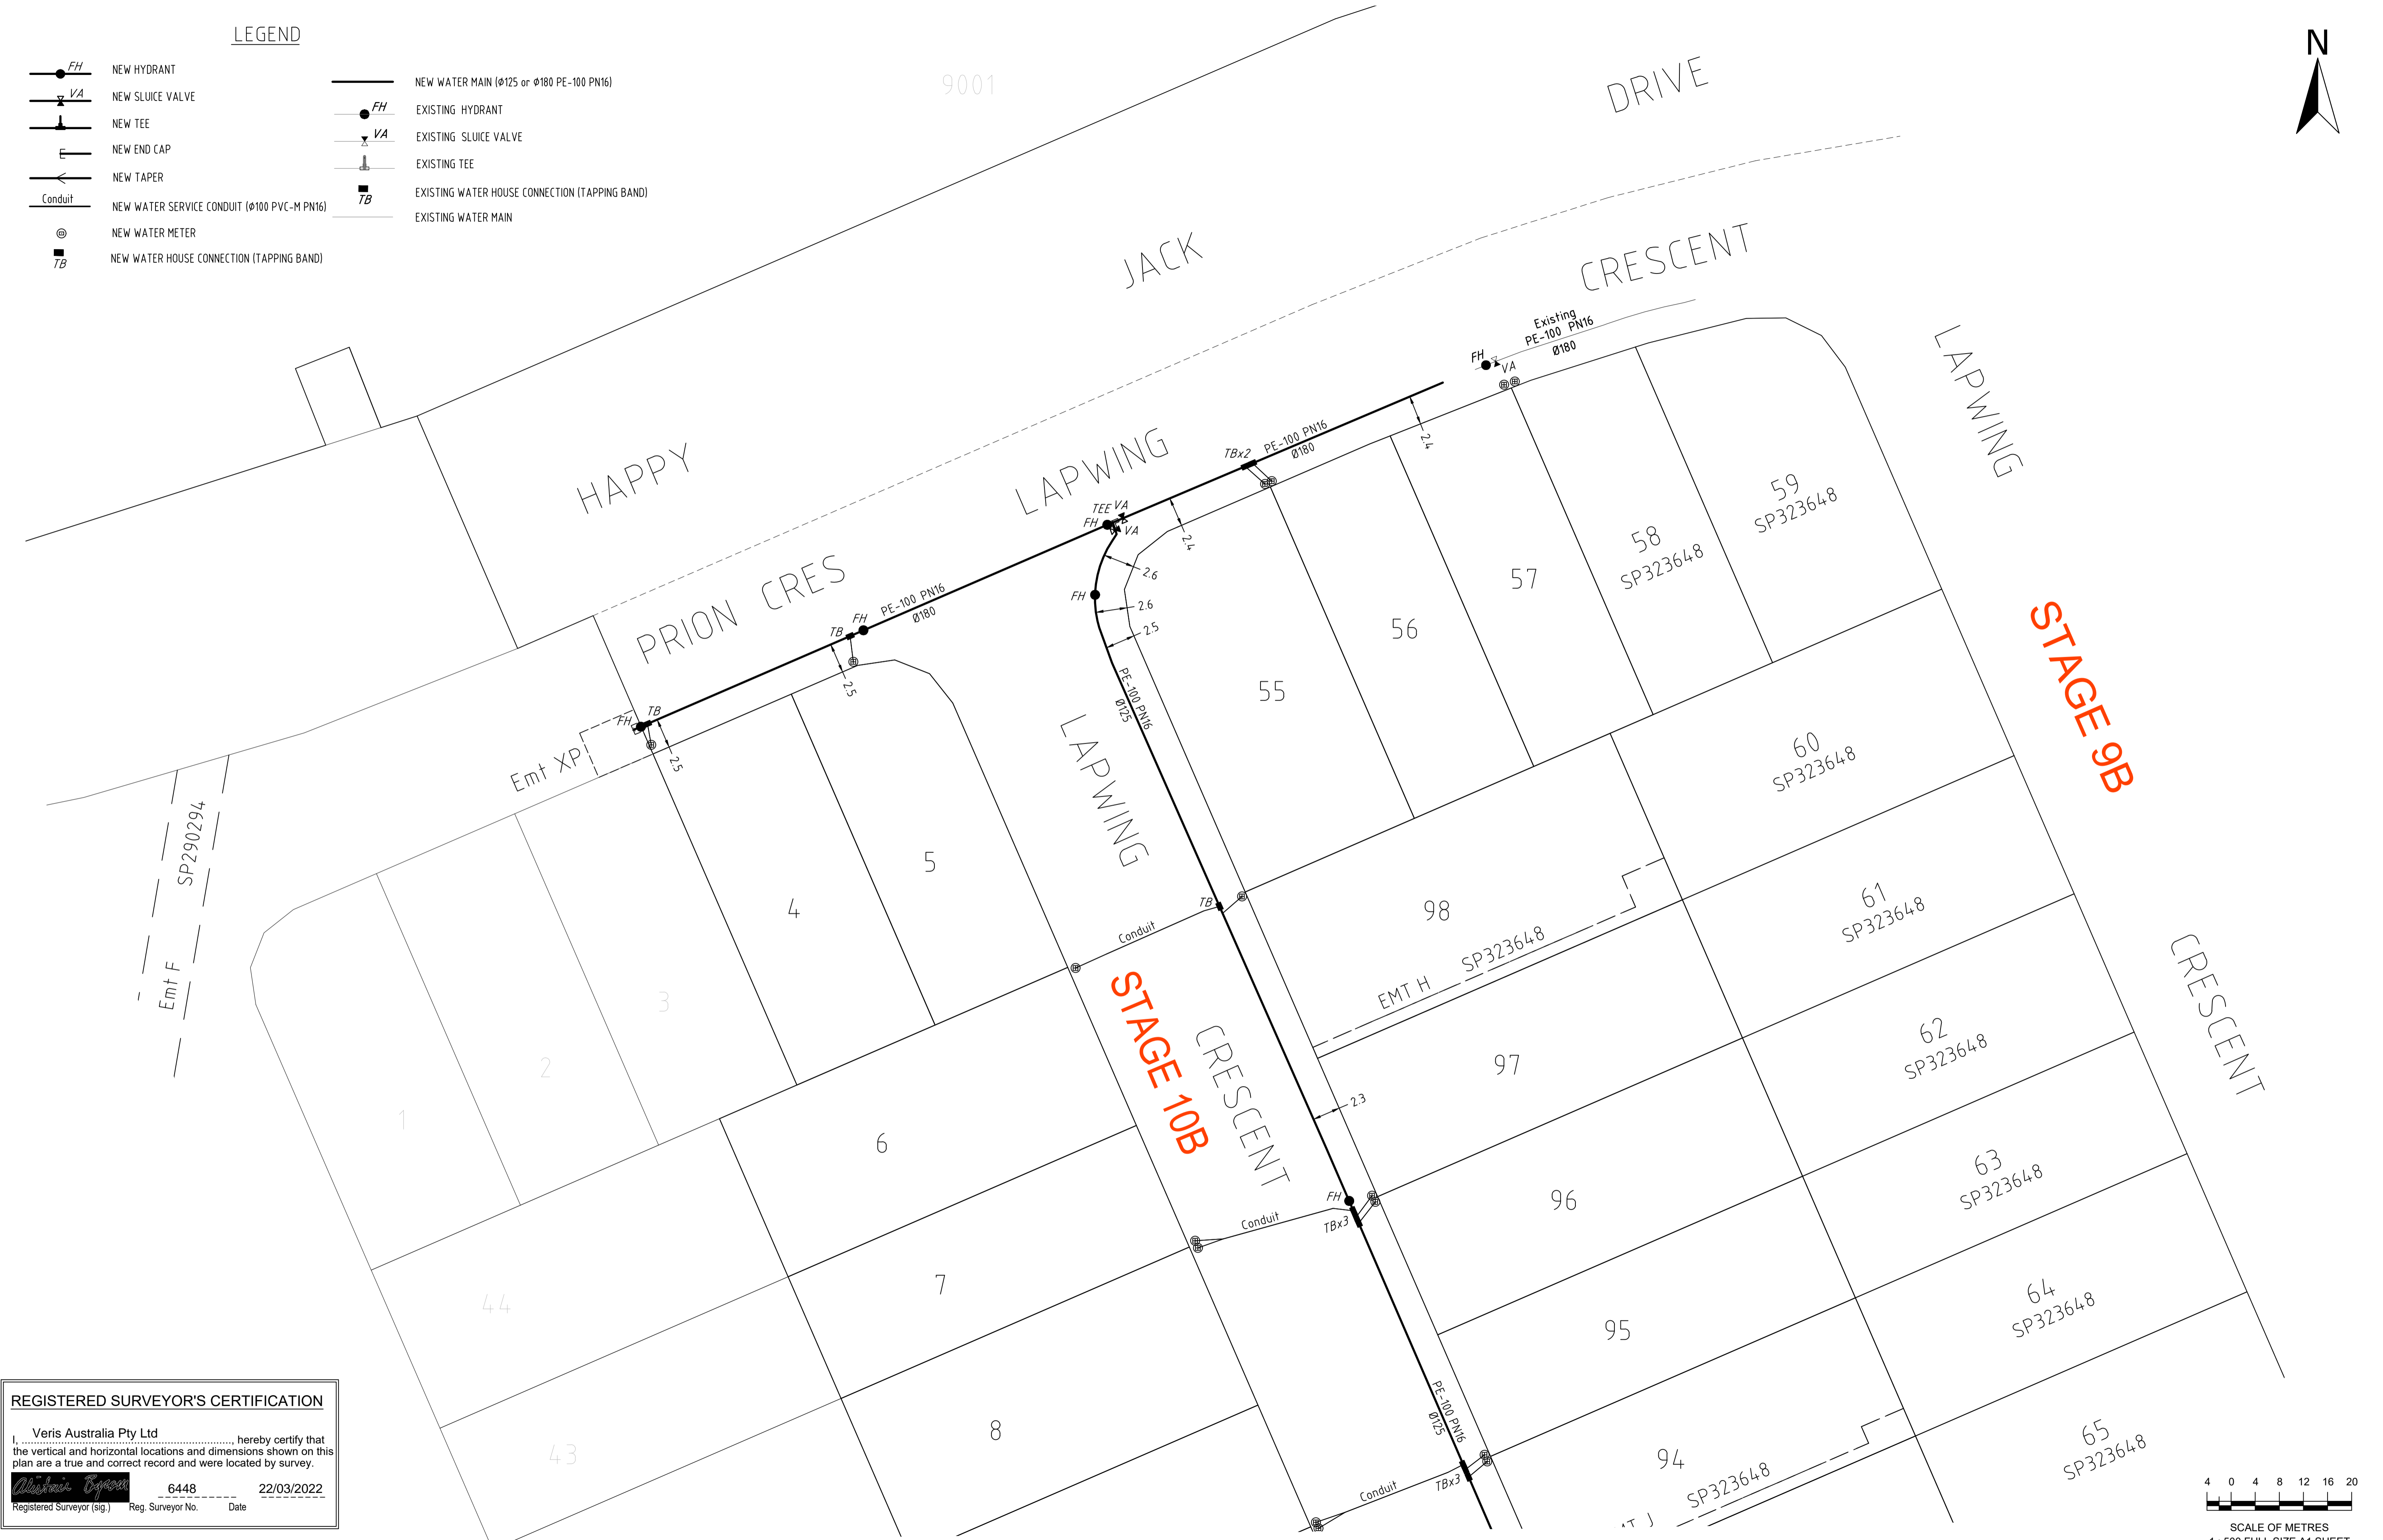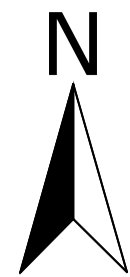

**REGISTERED SURVEYOR'S CERTIFICATION**  
 I, Veris Australia Pty Ltd, hereby certify that the vertical and horizontal locations and dimensions shown on this plan are a true and correct record and were located by survey.  
  
 6448 22/03/2022  
 Registered Surveyor (sig.) Reg. Surveyor No. Date

<b>A1</b>	REV NO	DATE	REVISION PURPOSE / DESCRIPTION	DRAWN	RPEQ	RPEQ No	INITIALS	DATE
	B	24/02/2022	PROGRESS PLOT	GJF				18/11/2021
	A	18/11/2021	PROGRESS PLOT	JMc				18/11/2021

	BRISBANE 071 3066 6700	WHITSUNDAYS 071 4944 6600
	MACKAY 071 4967 6700	CAIRNS 071 4252 9400
	veris.com.au ACN 615 730 727 Veris Australia Pty Ltd	



**BRENTWOOD FOREST**  
 7000 Jones Road, Bellbird Park  
**AS CONSTRUCTED WATER STAGE 10 WATER**

DRAWING STATUS <b>AS CONSTRUCTED</b>	
SHEET 4 OF 4 SHEETS	
DRAWING NO. <b>400891-AW10A</b>	REV. <b>A</b>