





**LEGEND**

- NEW HYDRANT
- NEW SLUICE VALVE
- NEW TEE
- NEW END CAP
- NEW TAPER
- NEW WATER SERVICE CONDUIT (Ø100 PVC-M PN16)
- NEW WATER METER
- NEW WATER HOUSE CONNECTION (TAPPING BAND)
- EXISTING HYDRANT
- EXISTING SLUICE VALVE
- EXISTING TEE
- EXISTING WATER HOUSE CONNECTION (TAPPING BAND)
- EXISTING WATER MAIN
- WATER MAKER
- NEW WATER MAIN (Ø125 or Ø180 PE-100 PN16)

**REGISTERED SURVEYOR'S CERTIFICATION**  
 I, Veris Australia Pty Ltd, hereby certify that the vertical and horizontal locations and dimensions shown on this plan are a true and correct record and were located by survey.  
  
 Registered Surveyor (sig.)      6448      25/11/2022  
 Reg. Surveyor No.      Date



SCALE OF METRES  
 1 : 250 FULL SIZE A1 SHEET

<b>A1</b>	C	21/11/2022	FINAL EDITS	JH	DRAWN	JM	05/10/2022
	B	12/10/2022	PROGRESS PLOT	JM	CHECKED	JH	21/11/2022
	A	05/10/2022	PROGRESS PLOT	JM	APPROVED		
	REV NO	DATE	REVISION PURPOSE / DESCRIPTION	DRAWN	RPEQ	RPEQ No	INITIALS


**veris**

BRISBANE (07) 3664 4700    WHITSUNDAYS (07) 4945 6900  
 MACKAY (07) 4957 9700    CAIRNS (07) 4252 9400  
 veris.com.au  
 ACN 615 735 727  
 Veris Australia Pty Ltd



**BRENTWOOD FOREST**  
 7000 Jones Road, Bellbird Park  
**AS CONSTRUCTED WATER STAGE 11**  
**WATER**

<b>DRAWING STATUS</b> <b>AS CONSTRUCTED</b>	
SHEET 2 OF 4 SHEETS	
DRAWING NO. <b>400891-AW11</b>	REV. <b>C</b>

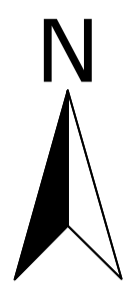

**LEGEND**

- NEW HYDRANT
- NEW SLUICE VALVE
- NEW TEE
- NEW END CAP
- NEW TAPER
- NEW WATER SERVICE CONDUIT (ø100 PVC-M PN16)
- NEW WATER METER
- NEW WATER HOUSE CONNECTION (TAPPING BAND)
- NEW WATER MAIN (ø125 or ø180 PE-100 PN16)
- EXISTING HYDRANT
- EXISTING SLUICE VALVE
- EXISTING TEE
- EXISTING WATER HOUSE CONNECTION (TAPPING BAND)
- EXISTING WATER MAIN
- WATER MAKER

**REGISTERED SURVEYOR'S CERTIFICATION**

I, Veris Australia Pty Ltd, hereby certify that the vertical and horizontal locations and dimensions shown on this plan are a true and correct record and were located by survey.

*Alister Baynam* 6448 25/11/2022  
 Registered Surveyor (sig.) Reg. Surveyor No. Date



SCALE OF METRES  
1 : 250 FULL SIZE A1 SHEET

<b>A1</b>	REV NO	DATE	REVISION PURPOSE / DESCRIPTION	DRAWN	RPEQ	RPEQ No	INITIALS	DATE
	C	21/11/2022	FINAL EDITS	JH				05/10/2022
	B	12/10/2022	PROGRESS PLOT	JMc				21/11/2022
	A	05/10/2022	PROGRESS PLOT	JMc				

**veris**


BRISBANE (07) 3664 4700 WHITSUNDAYS (07) 4945 6900  
 MACKAY (07) 4957 9700 CAIRNS (07) 4252 9400  
 veris.com.au  
 ACN 615 736 727  
 Veris Australia Pty Ltd



**BRENTWOOD FOREST**  
 7000 Jones Road, Bellbird Park  
**AS CONSTRUCTED WATER STAGE 11**  
**WATER**

DRAWING STATUS <b>AS CONSTRUCTED</b>	
SHEET 3 OF 4 SHEETS	
DRAWING NO. <b>400891-AW11</b>	REV. <b>C</b>



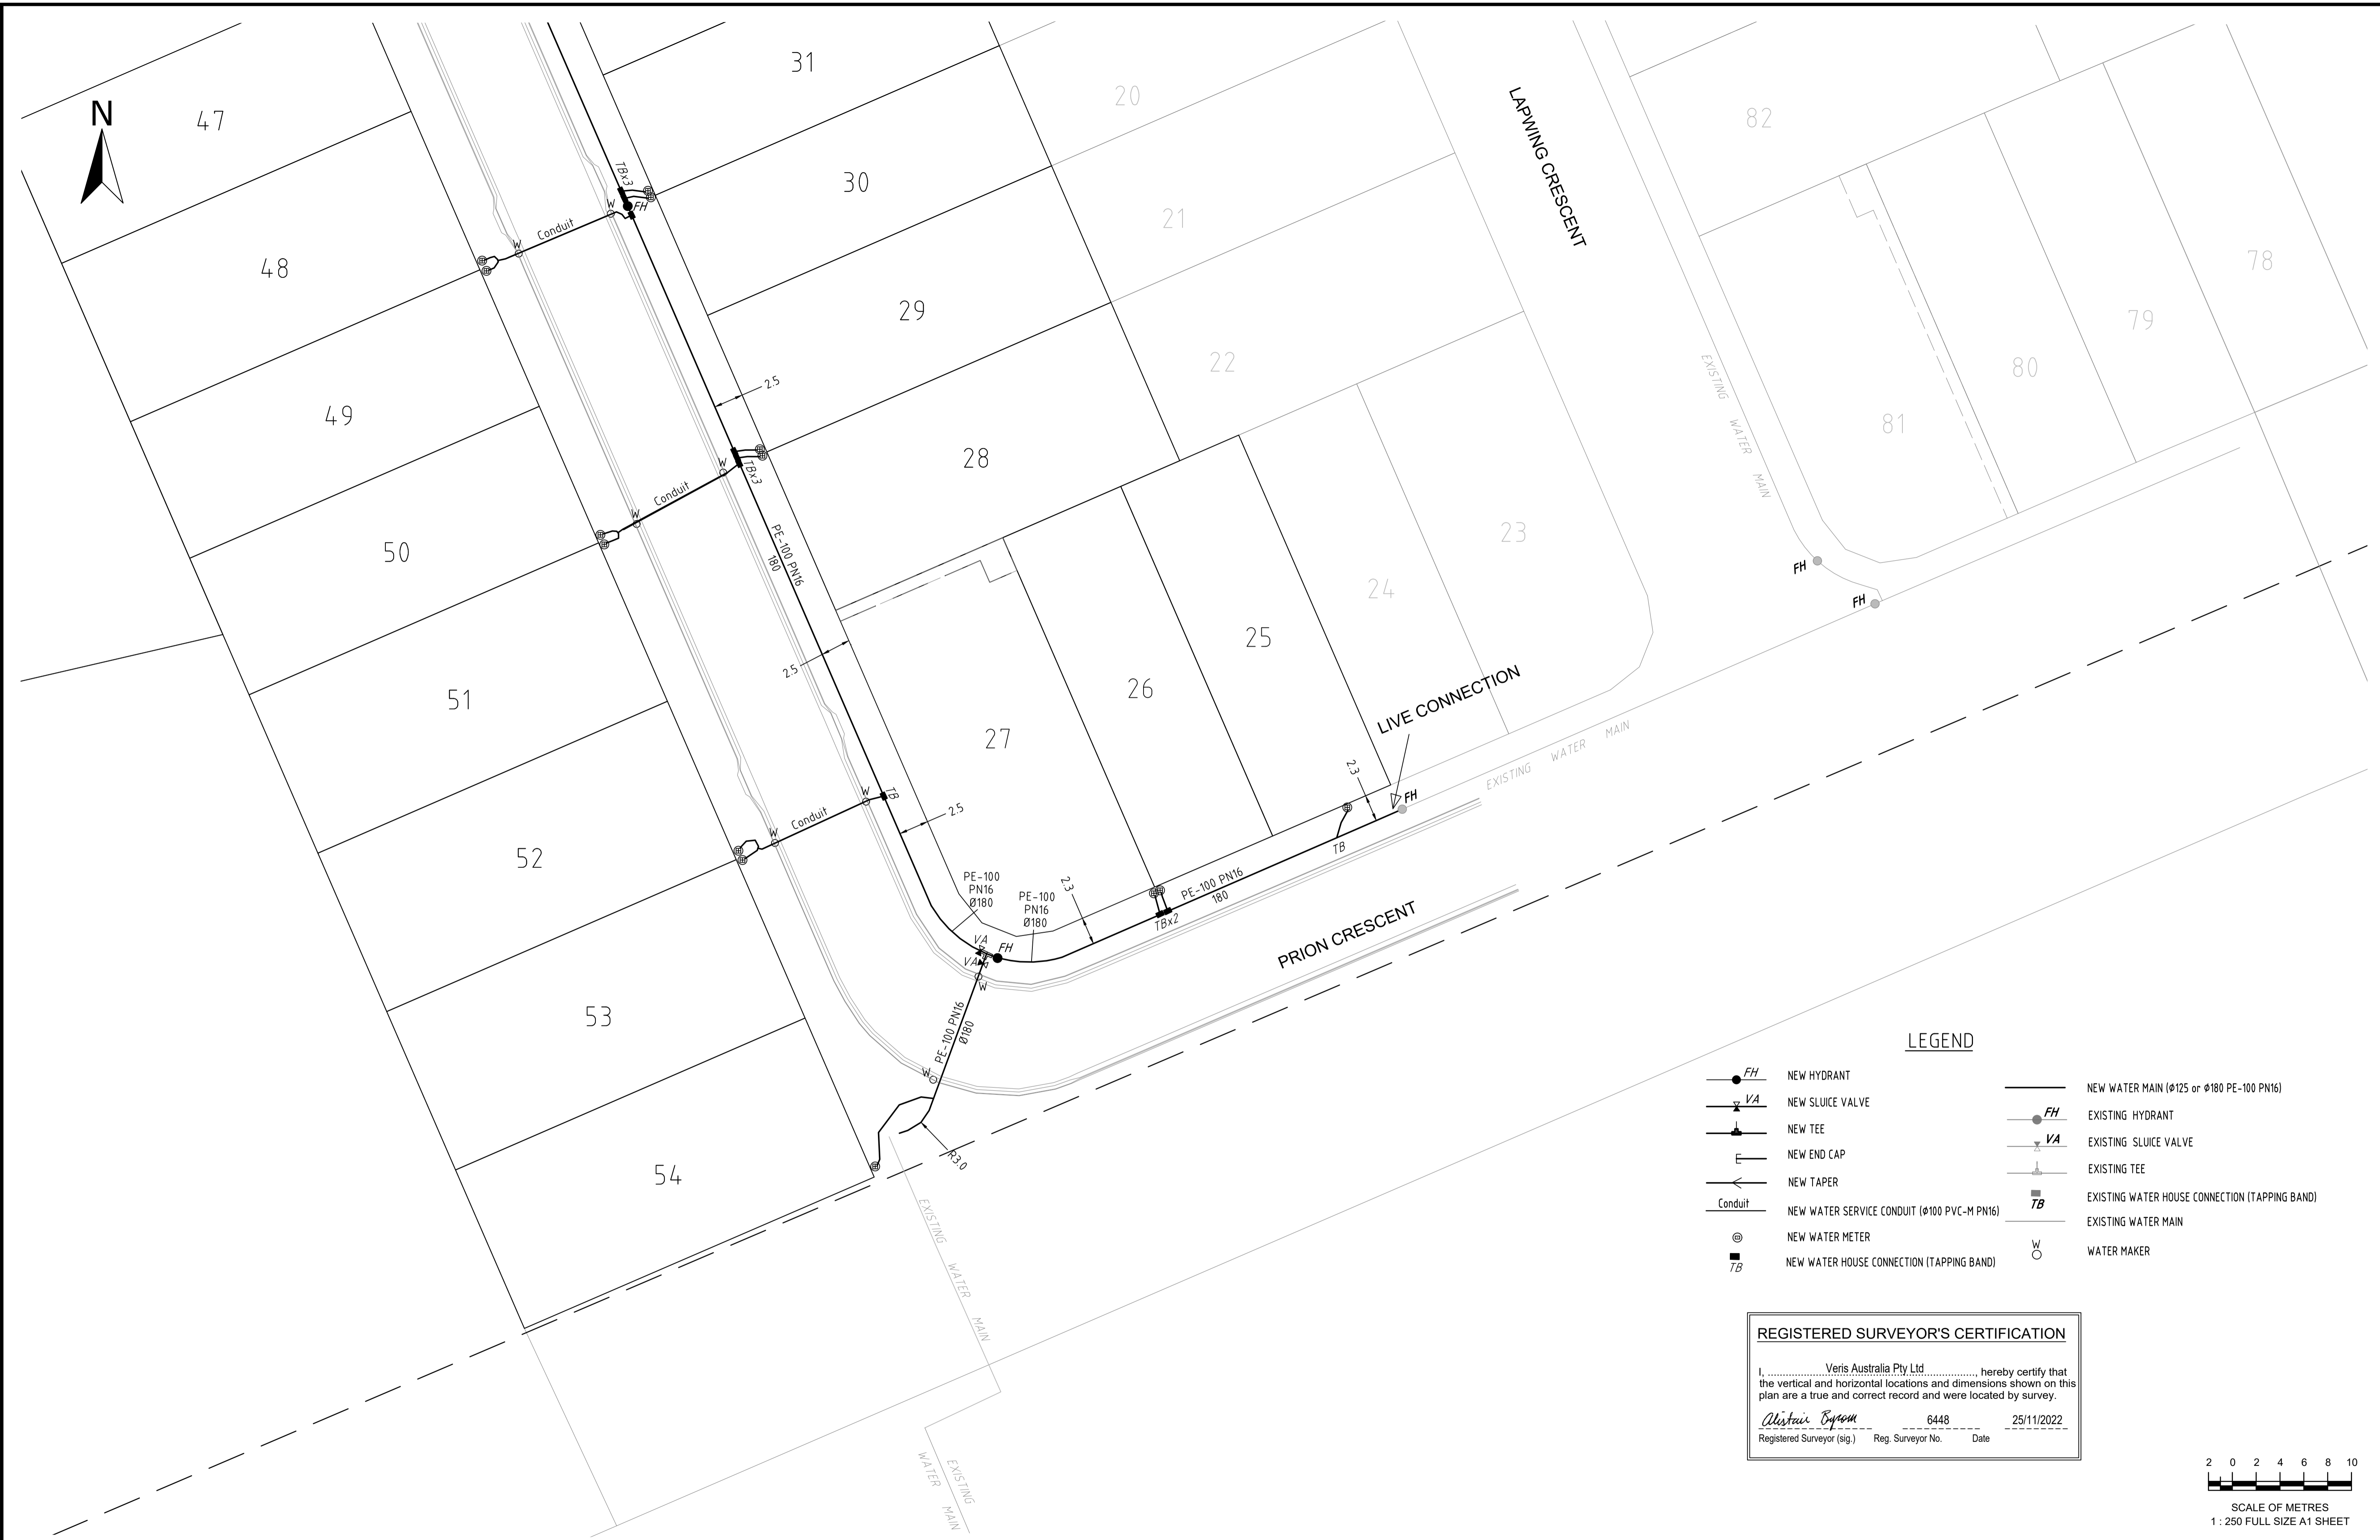


**LEGEND**

- NEW HYDRANT
- NEW SLUICE VALVE
- NEW TEE
- NEW END CAP
- NEW TAPER
- NEW WATER SERVICE CONDUIT (Ø100 PVC-M PN16)
- NEW WATER METER
- NEW WATER HOUSE CONNECTION (TAPPING BAND)
- EXISTING HYDRANT
- EXISTING SLUICE VALVE
- EXISTING TEE
- EXISTING WATER HOUSE CONNECTION (TAPPING BAND)
- EXISTING WATER MAIN
- WATER MAKER
- NEW WATER MAIN (Ø125 or Ø180 PE-100 PN16)

**REGISTERED SURVEYOR'S CERTIFICATION**

I, Veris Australia Pty Ltd, hereby certify that the vertical and horizontal locations and dimensions shown on this plan are a true and correct record and were located by survey.

*Alistair Byrom* 6448 25/11/2022  
 Registered Surveyor (sig.) Reg. Surveyor No. Date

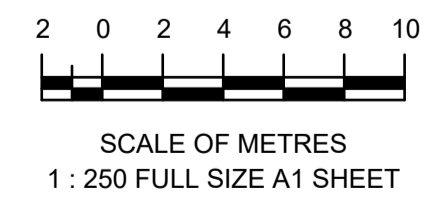

<b>A1</b>	REV NO	DATE	REVISION PURPOSE / DESCRIPTION	DRAWN	RPEQ	RPEQ No	INITIALS	DATE
	C	21/11/2022	FINAL EDITS	JH			DRAWN JMc	05/10/2022
	B	12/10/2022	PROGRESS PLOT	JMc			CHECKED JH	21/11/2022
	A	05/10/2022	PROGRESS PLOT	JMc			APPROVED	

**veris**

BRISBANE (07) 3664 4700 WHITSUNDAYS (07) 4945 6900  
 MACKAY (07) 4957 9700 CAIRNS (07) 4252 9400  
 veris.com.au  
 ACN 615 735 727  
 Veris Australia Pty Ltd



**BRENTWOOD FOREST**  
 7000 Jones Road, Bellbird Park  
**AS CONSTRUCTED WATER STAGE 11**  
**WATER**

DRAWING STATUS <b>AS CONSTRUCTED</b>	
SHEET 4 OF 4 SHEETS	
DRAWING NO. <b>400891-AW11</b>	REV. <b>C</b>