




SHEET 2

9008

LEGEND

- NEW HYDRANT
- NEW SLUICE VALVE
- NEW TEE
- NEW END CAP
- NEW TAPER
- NEW WATER SERVICE CONDUIT (ø100 PVC-0 PN16)
- NEW WATER SERVICE (ø25 PE PN16)
- NEW WATER METER
- NEW WATER HOUSE CONNECTION (READY TAP)
- EXISTING HYDRANT
- EXISTING SLUICE VALVE
- EXISTING TEE
- EXISTING WATER HOUSE CONNECTION (READY TAP)
- EXISTING WATER MAIN
- NEW WATER MAIN (ø100 PVC-0 PN16)
- NEW WATER MAIN (ø150 PVC-0 PN16)
- NEW WATER MAIN (ø125 or ø180 PE-100 PN16)

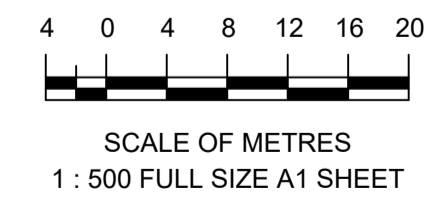

REGISTERED SURVEYOR'S CERTIFICATION

I, Veris Australia Pty Ltd, hereby certify that the vertical and horizontal locations and dimensions shown on this plan are a true and correct record and were located by survey.

Alistair Byrom 6448 17/10/2022
 Registered Surveyor (sig.) Reg. Surveyor No. Date

A1	C	13/10/2022	PROGRESS PLOT	JMc			DRAWN	JMc	23/05/2022
	B	29/09/2022	PROGRESS PLOT	JMc			CHECKED	MJT	
	A	23/05/2022	PROGRESS PLOT	JMc			APPROVED		
	REV NO	DATE	REVISION PURPOSE / DESCRIPTION	DRAWN	RPEQ	RPEQ No	INITIALS	DATE	


veris

BRISBANE (07) 3656 4700 WHITSUNDAYS (07) 4945 6900
 MACKAY (07) 4957 9700 CAIRNS (07) 4252 9400
 veris.com.au
 ACN 615 736 727
 Veris Australia Pty Ltd



BRENTWOOD FOREST
 7000 Jones Road, Bellbird Park
AS CONSTRUCTED WATER STAGE 13
 WATER

DRAWING STATUS	
AS CONSTRUCTED	
SHEET 1 OF 2 SHEETS	
DRAWING NO.	REV.
400891-AW13	C

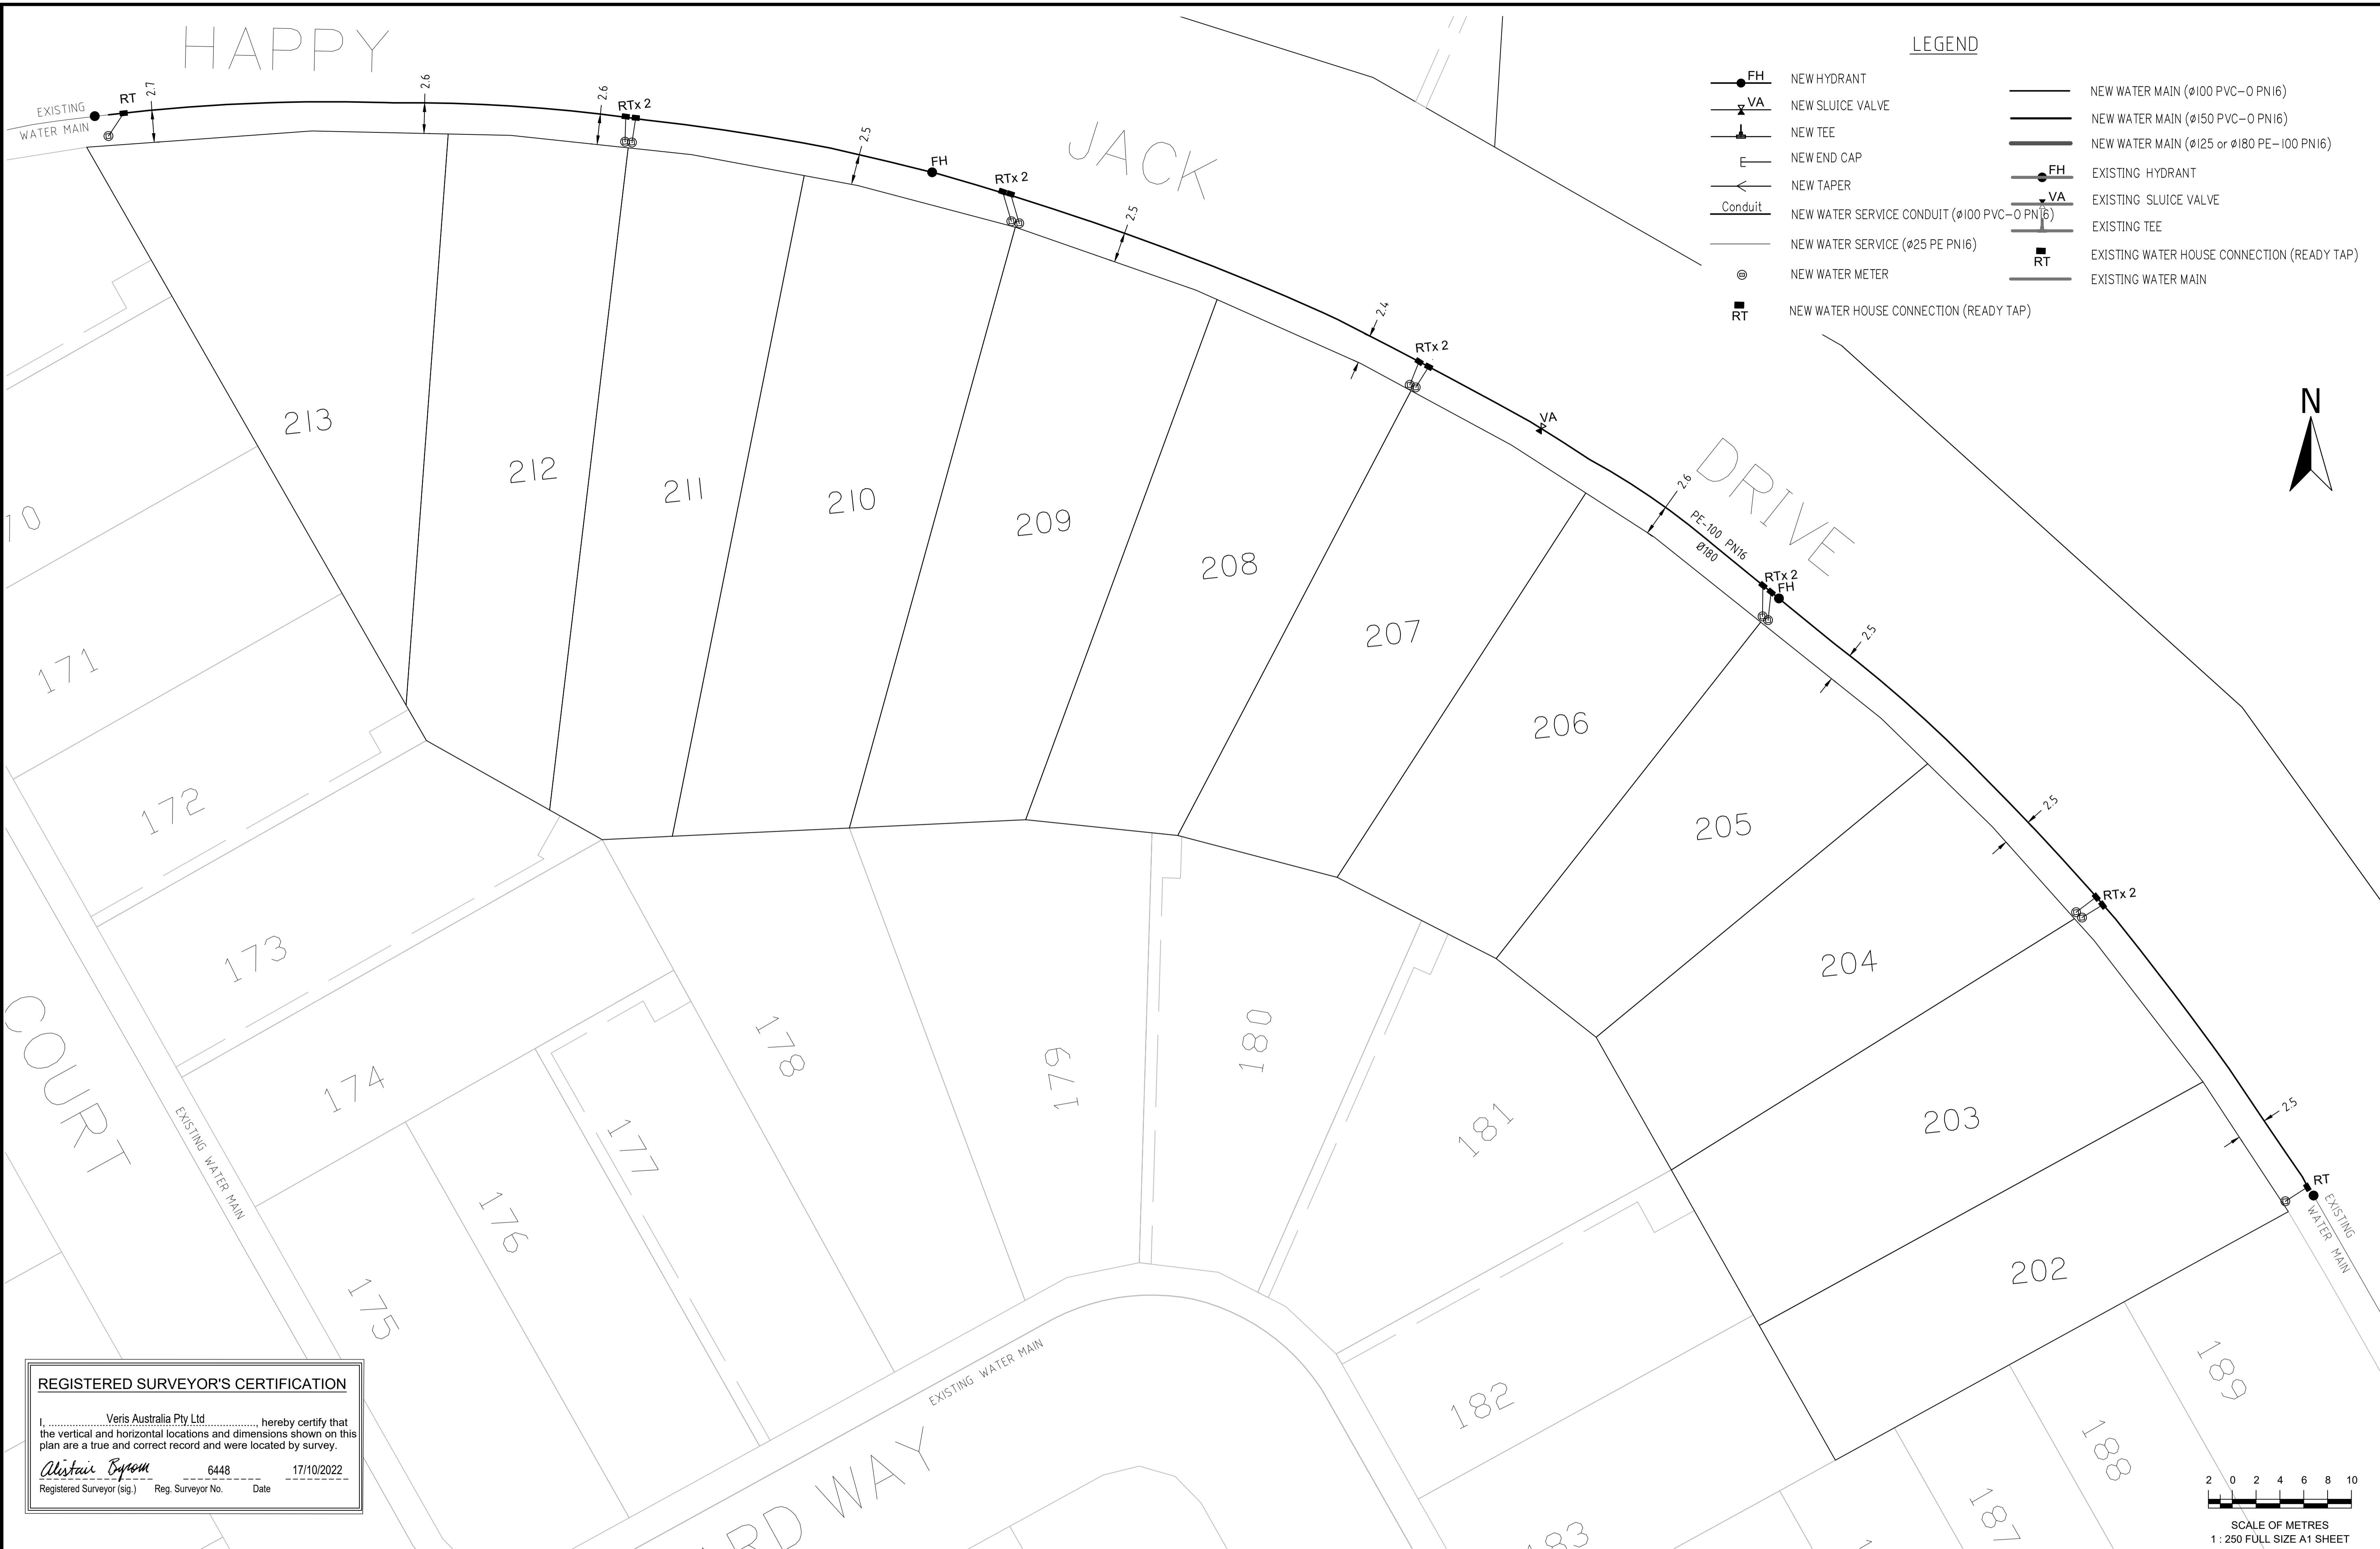

- LEGEND**
- NEW HYDRANT
 - NEW SLUICE VALVE
 - NEW TEE
 - NEW END CAP
 - NEW TAPER
 - NEW WATER SERVICE CONDUIT (Ø100 PVC-0 PN16)
 - NEW WATER SERVICE (Ø25 PE PN16)
 - NEW WATER METER
 - NEW WATER HOUSE CONNECTION (READY TAP)
 - NEW WATER MAIN (Ø100 PVC-0 PN16)
 - NEW WATER MAIN (Ø150 PVC-0 PN16)
 - NEW WATER MAIN (Ø125 or Ø180 PE-100 PN16)
 - EXISTING HYDRANT
 - EXISTING SLUICE VALVE
 - EXISTING TEE
 - EXISTING WATER HOUSE CONNECTION (READY TAP)
 - EXISTING WATER MAIN

REGISTERED SURVEYOR'S CERTIFICATION

I, Veris Australia Pty Ltd, hereby certify that the vertical and horizontal locations and dimensions shown on this plan are a true and correct record and were located by survey.

Alistair Byrom 6448 17/10/2022
 Registered Surveyor (sig.) Reg. Surveyor No. Date

A1	C	13/10/2022	PROGRESS PLOT	JMc		DRAWN	JMc	23/05/2022
	B	29/09/2022	PROGRESS PLOT	JMc		CHECKED		
	A	23/05/2022	PROGRESS PLOT	JMc		APPROVED		
	REV NO	DATE	REVISION PURPOSE / DESCRIPTION	DRAWN	RPEQ	RPEQ No	INITIALS	DATE

veris

BRISBANE (07) 3664 4700 WHITSUNDAYS (07) 4945 6900
 MACKAY (07) 4957 9700 CAIRNS (07) 4252 9400
 veris.com.au
 ACN 615 735 727
 Veris Australia Pty Ltd

QUEENSLAND UrbanUtilities

BRENTWOOD FOREST
 7000 Jones Road, Bellbird Park
AS CONSTRUCTED WATER STAGE 13
 WATER

DRAWING STATUS	
AS CONSTRUCTED	
SHEET 2 OF 2 SHEETS	
DRAWING NO.	REV.
400891-AW13	C