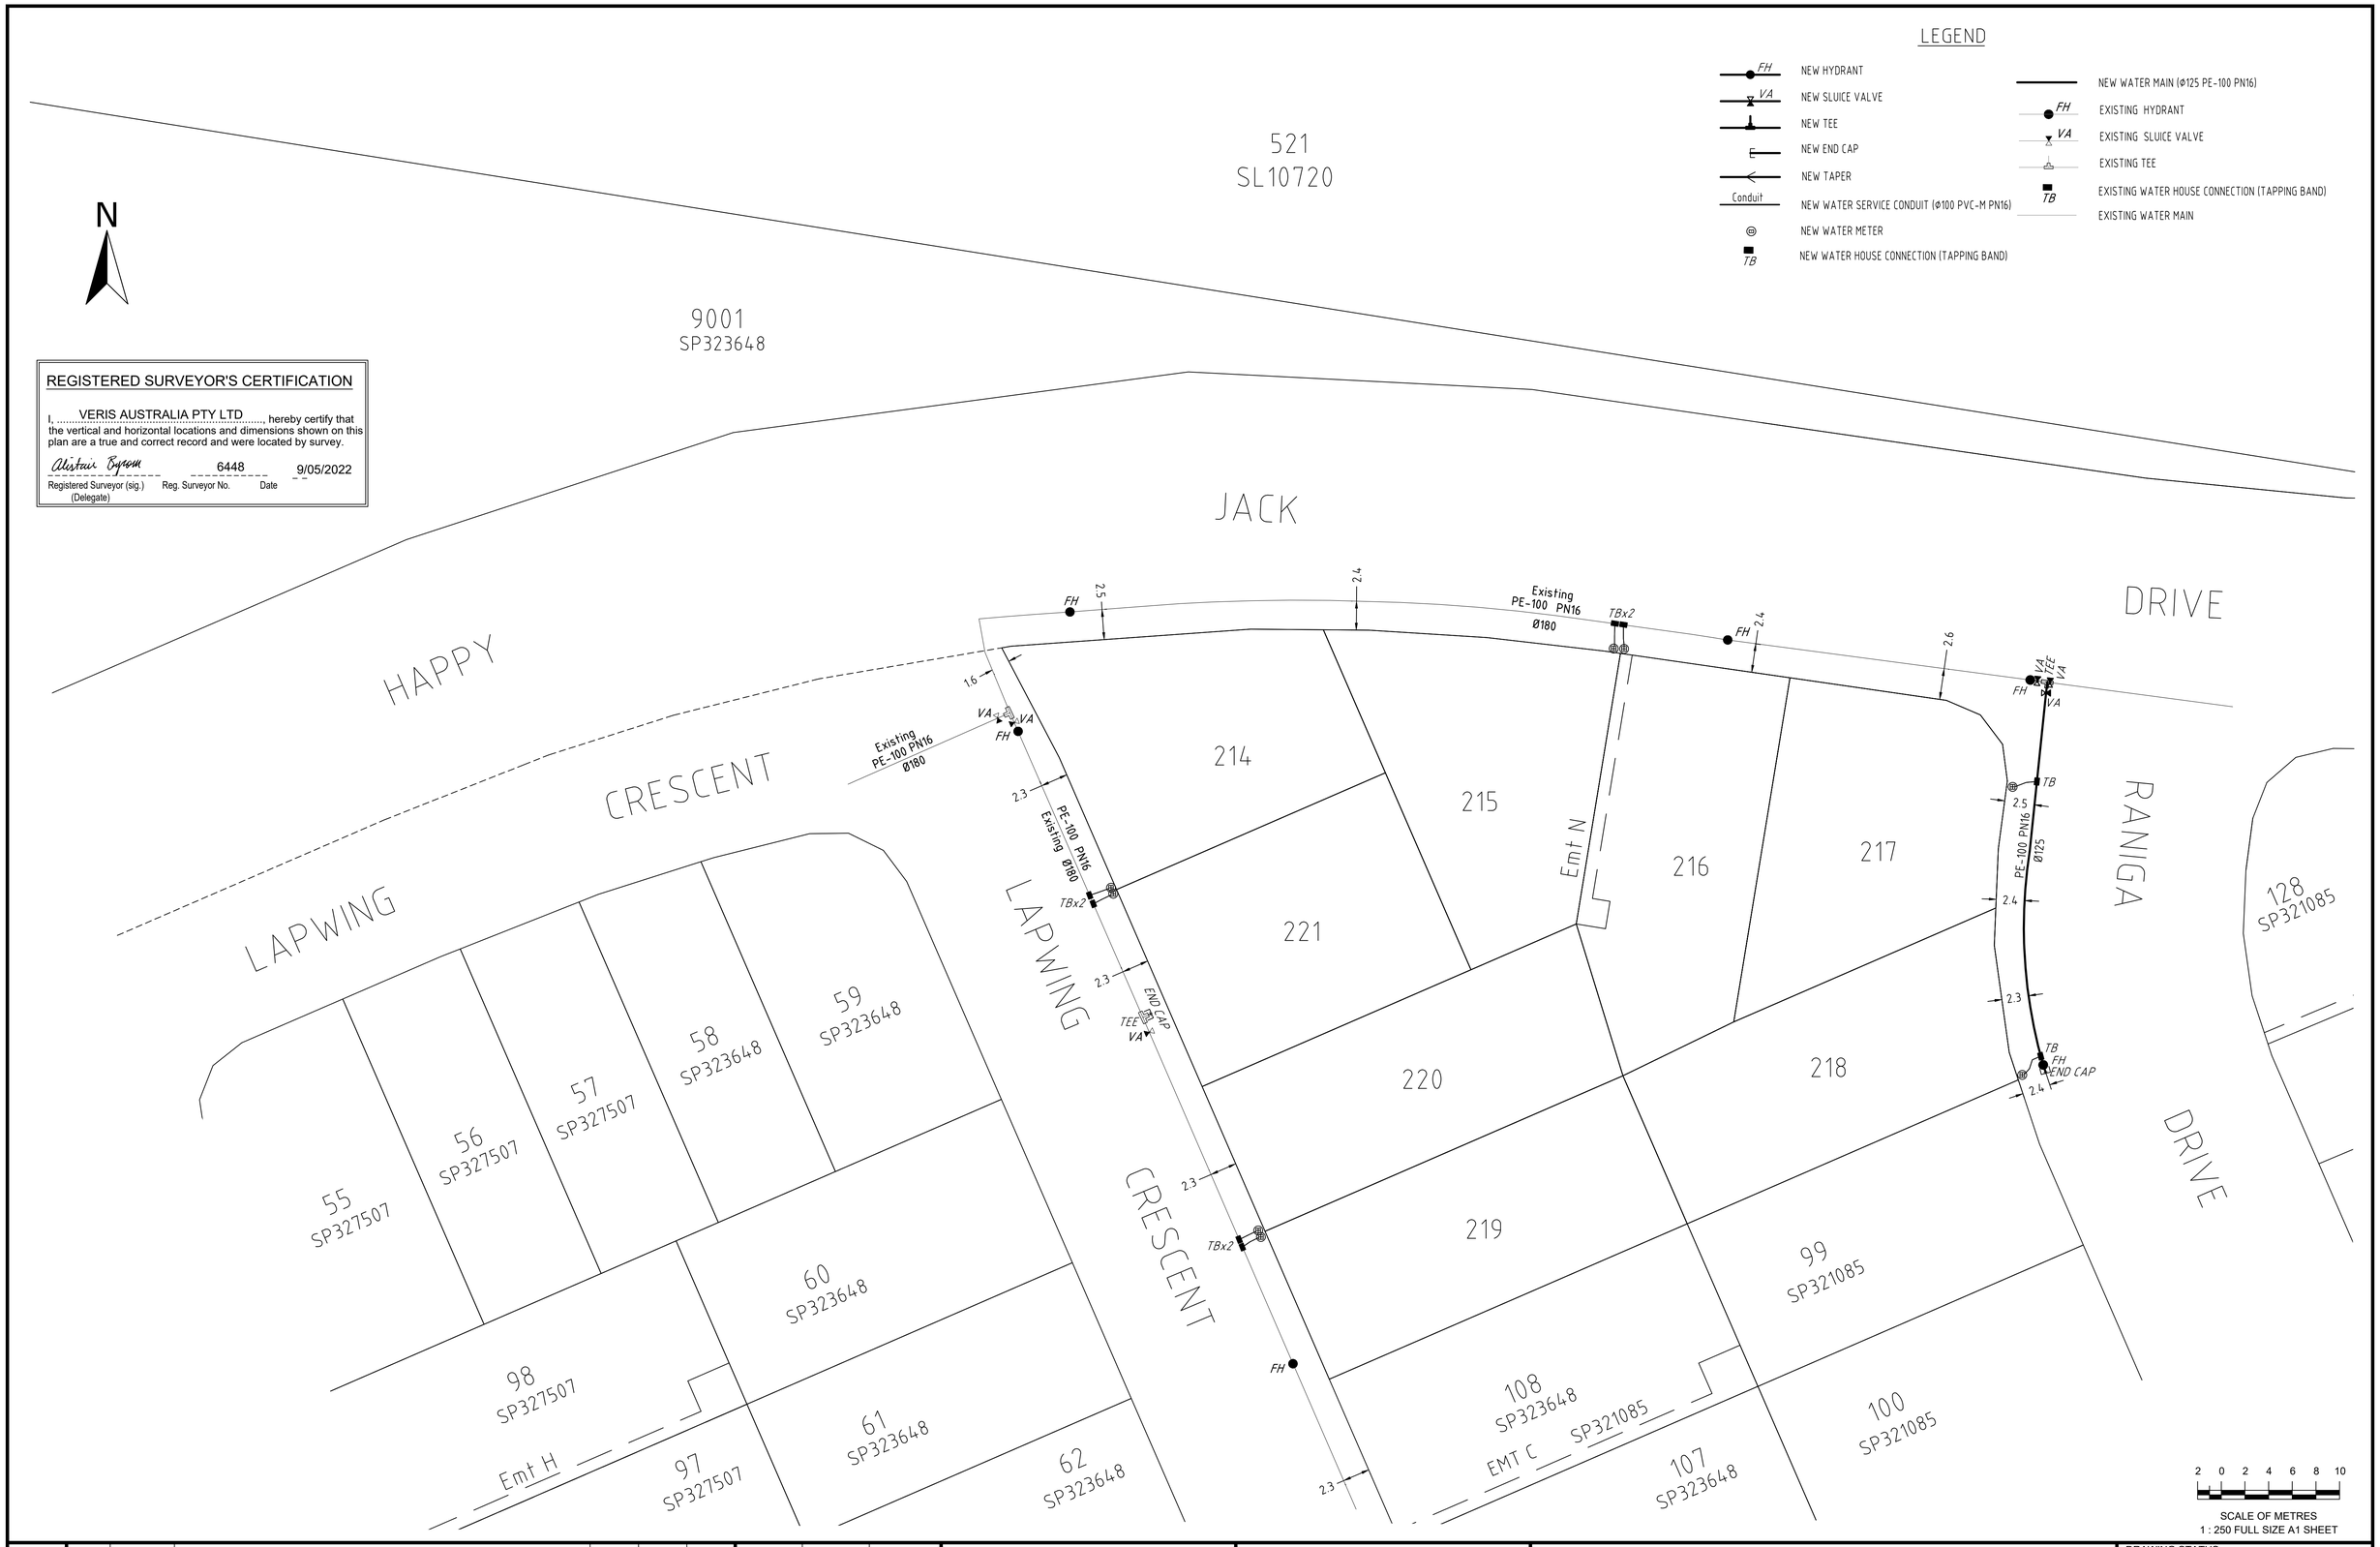

REGISTERED SURVEYOR'S CERTIFICATION

I, VERIS AUSTRALIA PTY LTD, hereby certify that the vertical and horizontal locations and dimensions shown on this plan are a true and correct record and were located by survey.

Alistair Byrom — Registered Surveyor (sig.) (Delegate)
6448 — Reg. Surveyor No.
9/05/2022 — Date

REV NO	DATE	REVISION PURPOSE / DESCRIPTION	DRAWN	RPEQ	RPEQ No
B	29/04/2022	PROGRESS PLOT	GJF		
A	08/04/2022	PROGRESS PLOT	GJF		

	INITIALS	DATE
DRAWN	GJF	08/04/2022
CHECKED		
APPROVED		

A1

veris
BRISBANE (07) 3666 4700 — WHITSUNDAYS (07) 4945 6600
MACKAY (07) 4957 9700 — CAIRNS (07) 4252 9400
veris.com.au
ACN 615 735 727
Veris Australia Pty Ltd

QUEENSLAND UrbanUtilities

BRENTWOOD FOREST
7000 Jones Road, Bellbird Park

AS CONSTRUCTED WATER STAGE 9C
WATER

DRAWING STATUS: AS CONSTRUCTED
SHEET 1 OF 1 SHEETS
DRAWING NO. 400891-AW09C
REV. B